


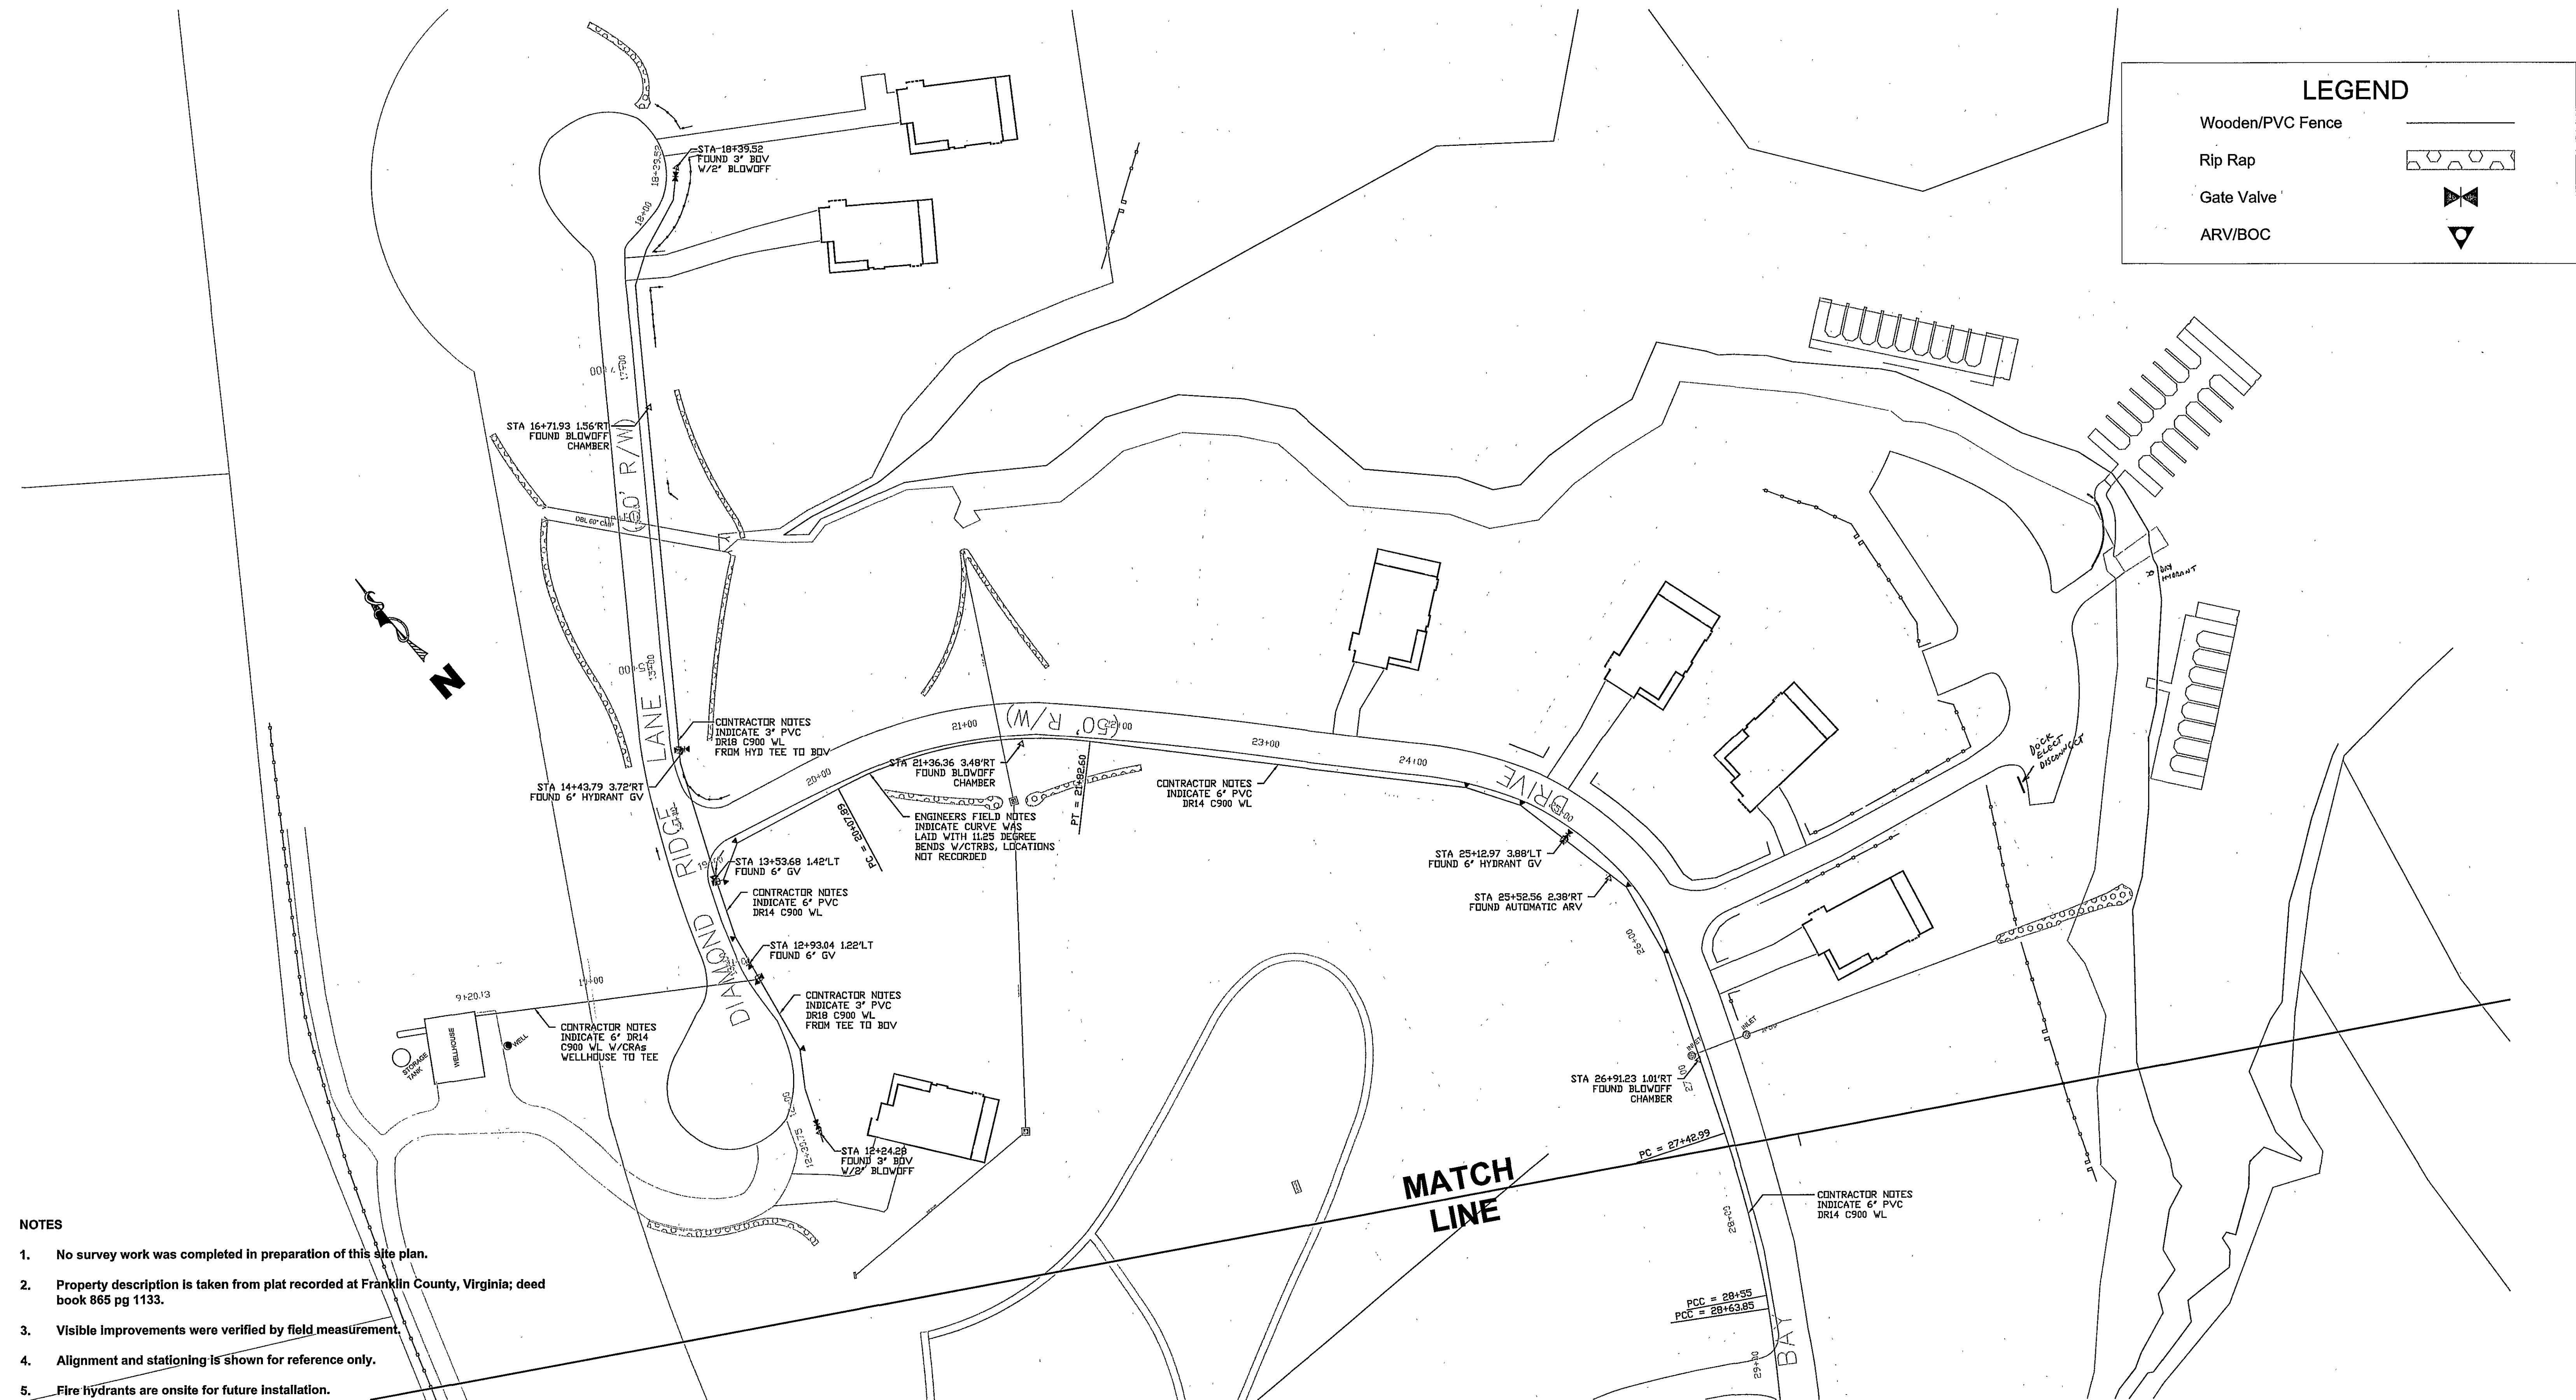

LEGEND

Wooden/PVC Fence

Rip Rap

Gate Valve

ARV/BOC

- NOTES
1. No survey work was completed in preparation of this site plan.

2. Property description is taken from plat recorded at Franklin County, Virginia; deed book 865 pg 1133.

3. Visible Improvements were verified by field measurement.

4. Alignment and stationing is shown for reference only.

5. Fire hydrants are onsite for future installation.

The Villages at

EMERALD BAY

Call Miss Utility Before You Dig

Dial 811 in VA, or 1-800-552-7001

(PROJECT RELATED INFORMATION)

MASTER WORK ORDER NUMBER:

PROJECT NUMBER: 2006-EBV

DEED BOOK / PAGE: 865, p1133

SHEET NO: 1 OF 1

NETWORK LOCATION & DRAWING TITLE:

P:\BAYVIEW ESTIMATING\EBV\EBV-AB\dwg\EBVAB.dwg

(REVISIONS)

EMERALD BAY VILLAGE

AS-BUILT SITE PLAN

WATER DISTRIBUTION SYSTEM

Bayview Construction Company

70 Homeplace Circle

Smith Mountain Lake

Moneta, VA 24121

(540) 537-6056 Fax (540) 721-5614

www.bayviewconstructioncompany.com

DESIGN BY:

DRAWN BY:

APPROVED BY:

SURVEYED BY:

AS BUILT

PKS

DATE:

DATE:

DATE:

SCALE:

DATE:

DATE:

DATE:

SCALE:

JUNE 10, 2008

1" = 50' HORIZ.

SHEET

U2