



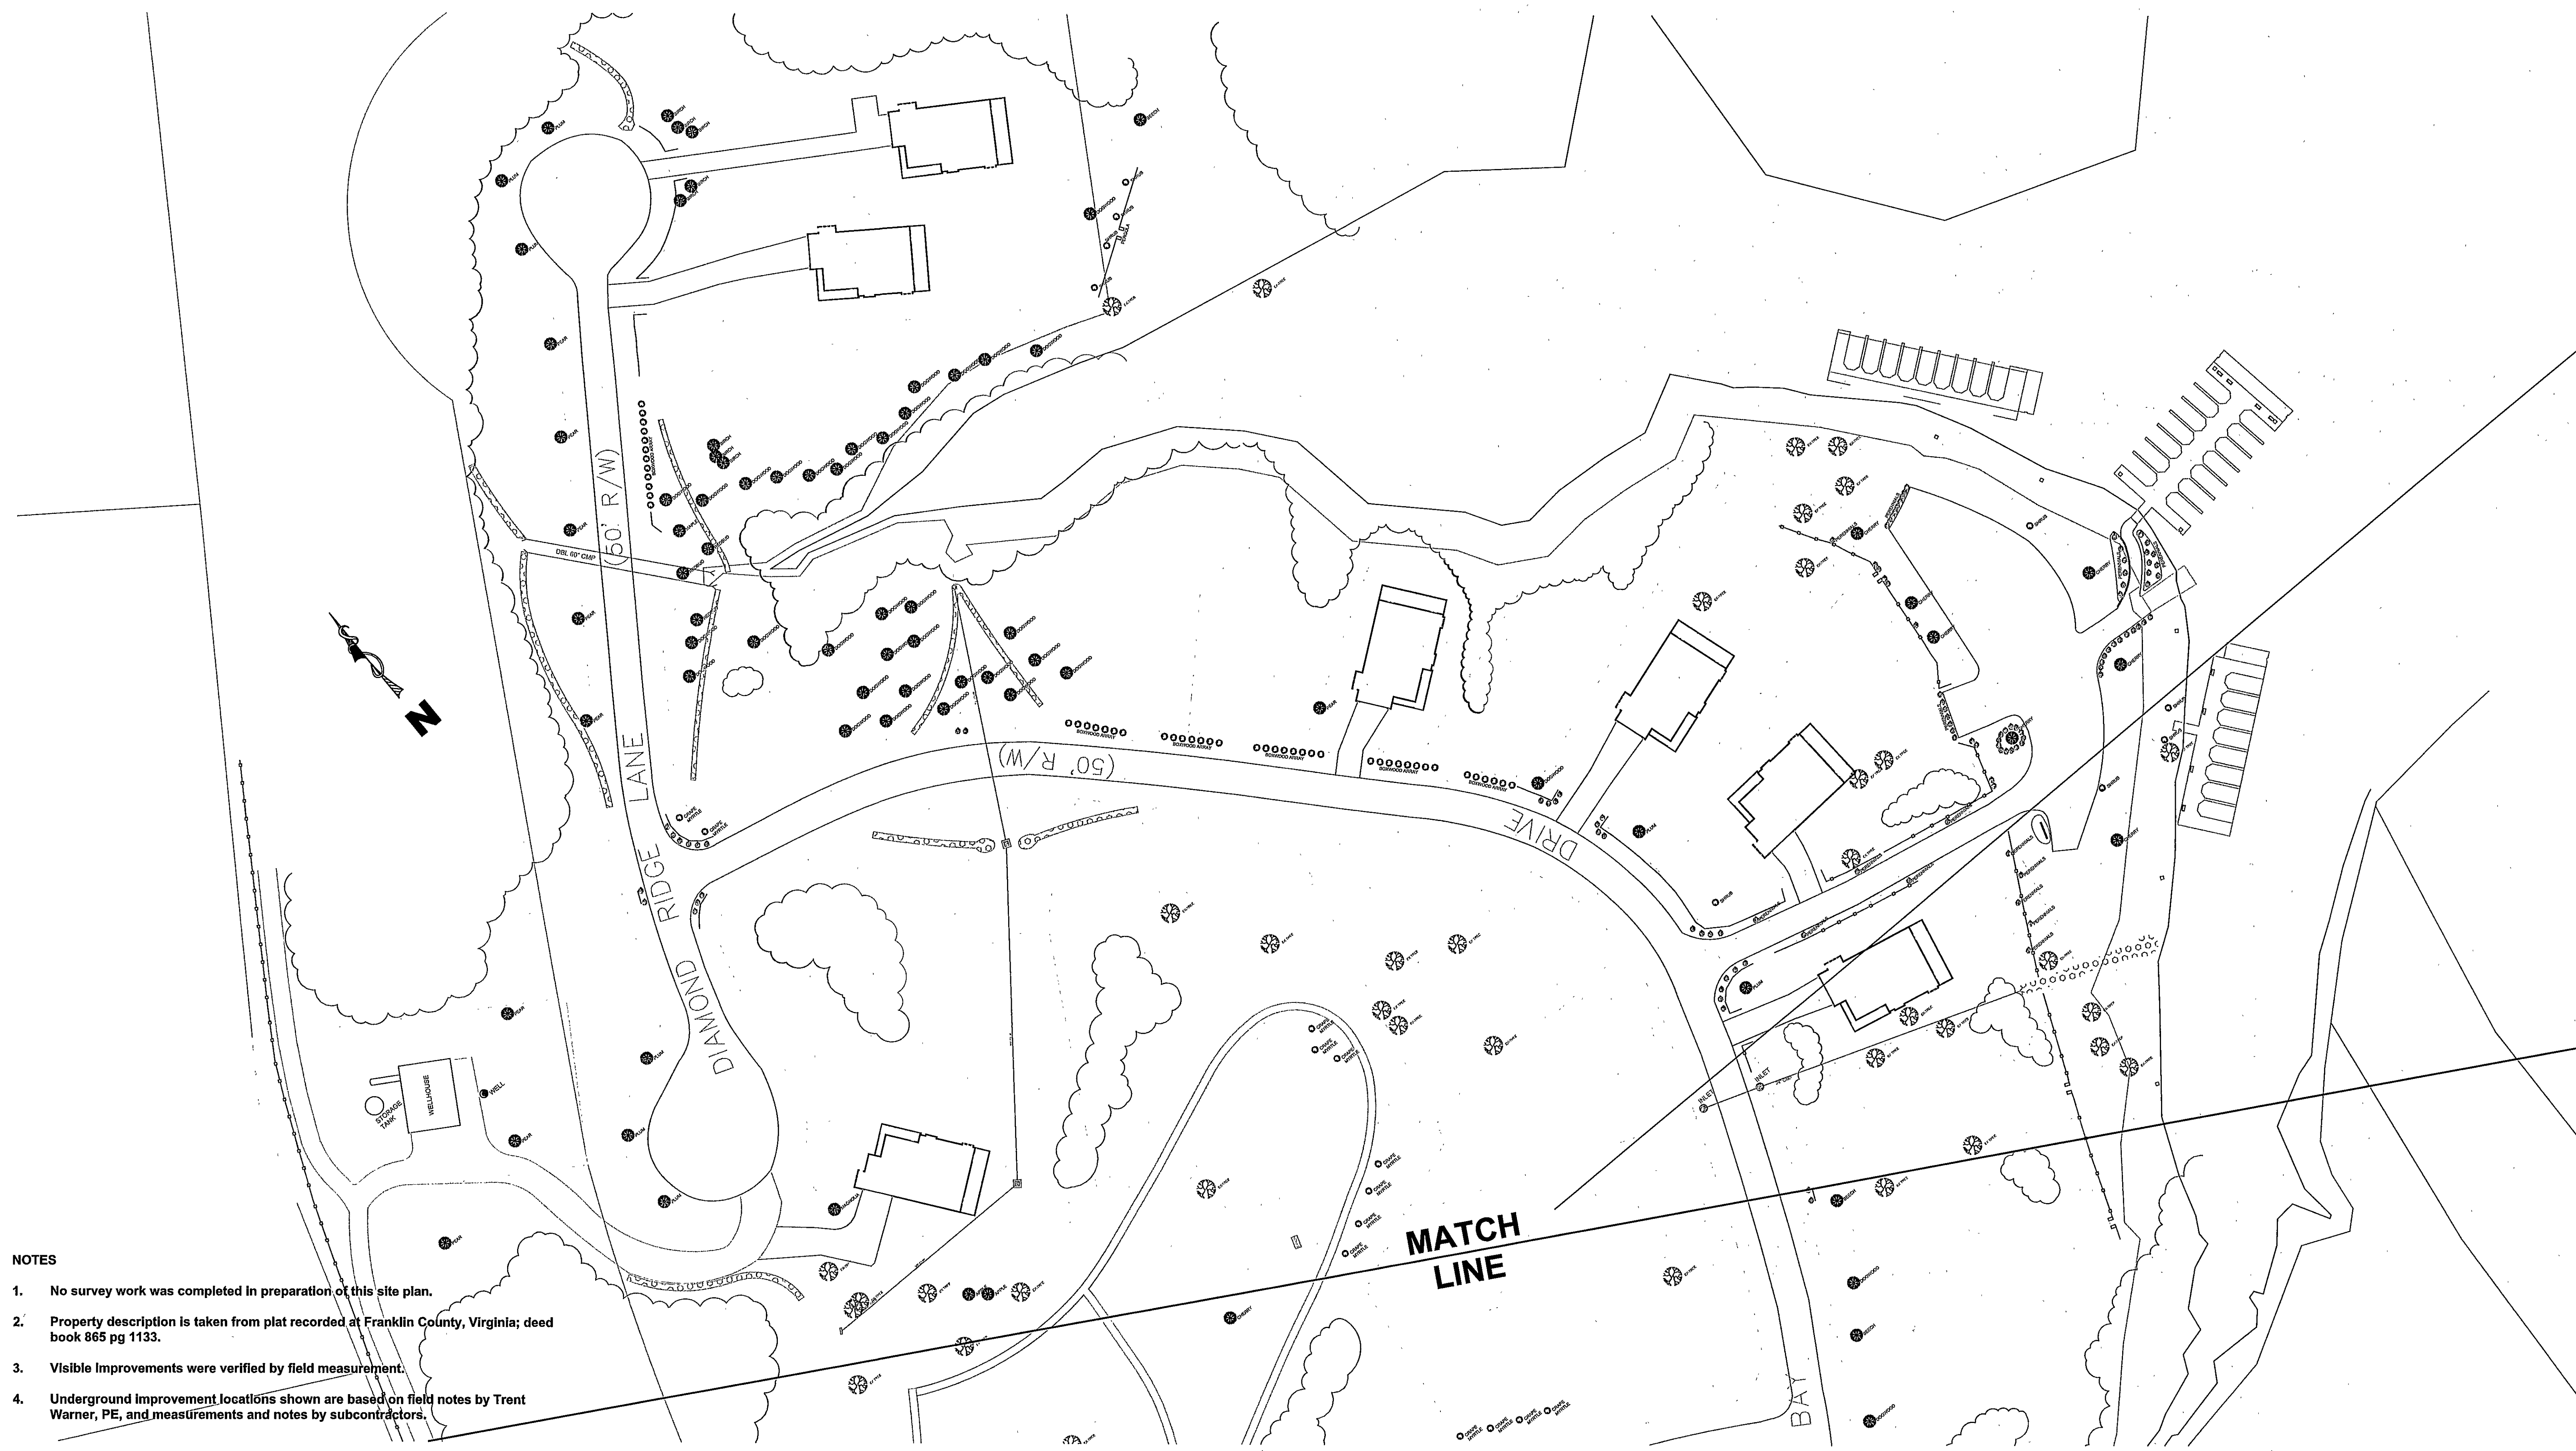

NOTES


1. No survey work was completed in preparation of this site plan.
2. Property description is taken from plat recorded at Franklin County, Virginia; deed book 865 pg 1133.
3. Visible Improvements were verified by field measurement.
4. Underground improvement locations shown are based on field notes by Trent Warner, PE, and measurements and notes by subcontractors.

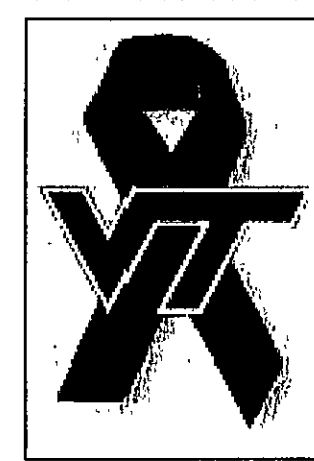

Call Miss Utility Before You Dig
Dial 811 in VA, or 1-800-552-7001

(PROJECT RELATED INFORMATION)	(REVISIONS)
MASTER WORK ORDER NUMBER:	
PROJECT NUMBER: 2007-S033	
DEED BOOK / PAGE: 771, p160	
SHEET NO: 1 OF 1	
NETWORK LOCATION & DRAWING TITLE:	
P:\BAYVIEW ESTIMATING\HARLEY HOUSE\dwg\HARLEY SITE.dwg	

**EMERALD BAY VILLAGE
AS-BUILT SITE PLAN
LANDSCAPE**

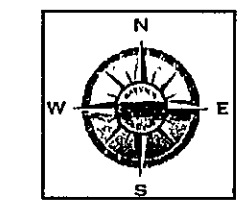

DESIGN BY:
DRAWN BY:
APPROVED BY:
SURVEYED BY:

Bayview Construction Company
70 Homelace Circle
Smith Mountain Lake
Moneta, VA 24121
(540) 537-6056 Fax (540) 721-5614
www.bayviewconstructioncompany.com

AS BUILT	DATE:
PKS	DATE: JUNE 10, 2008
	DATE:
	SCALE: 1" = 50' HORIZ.

**SHEET
L2**