
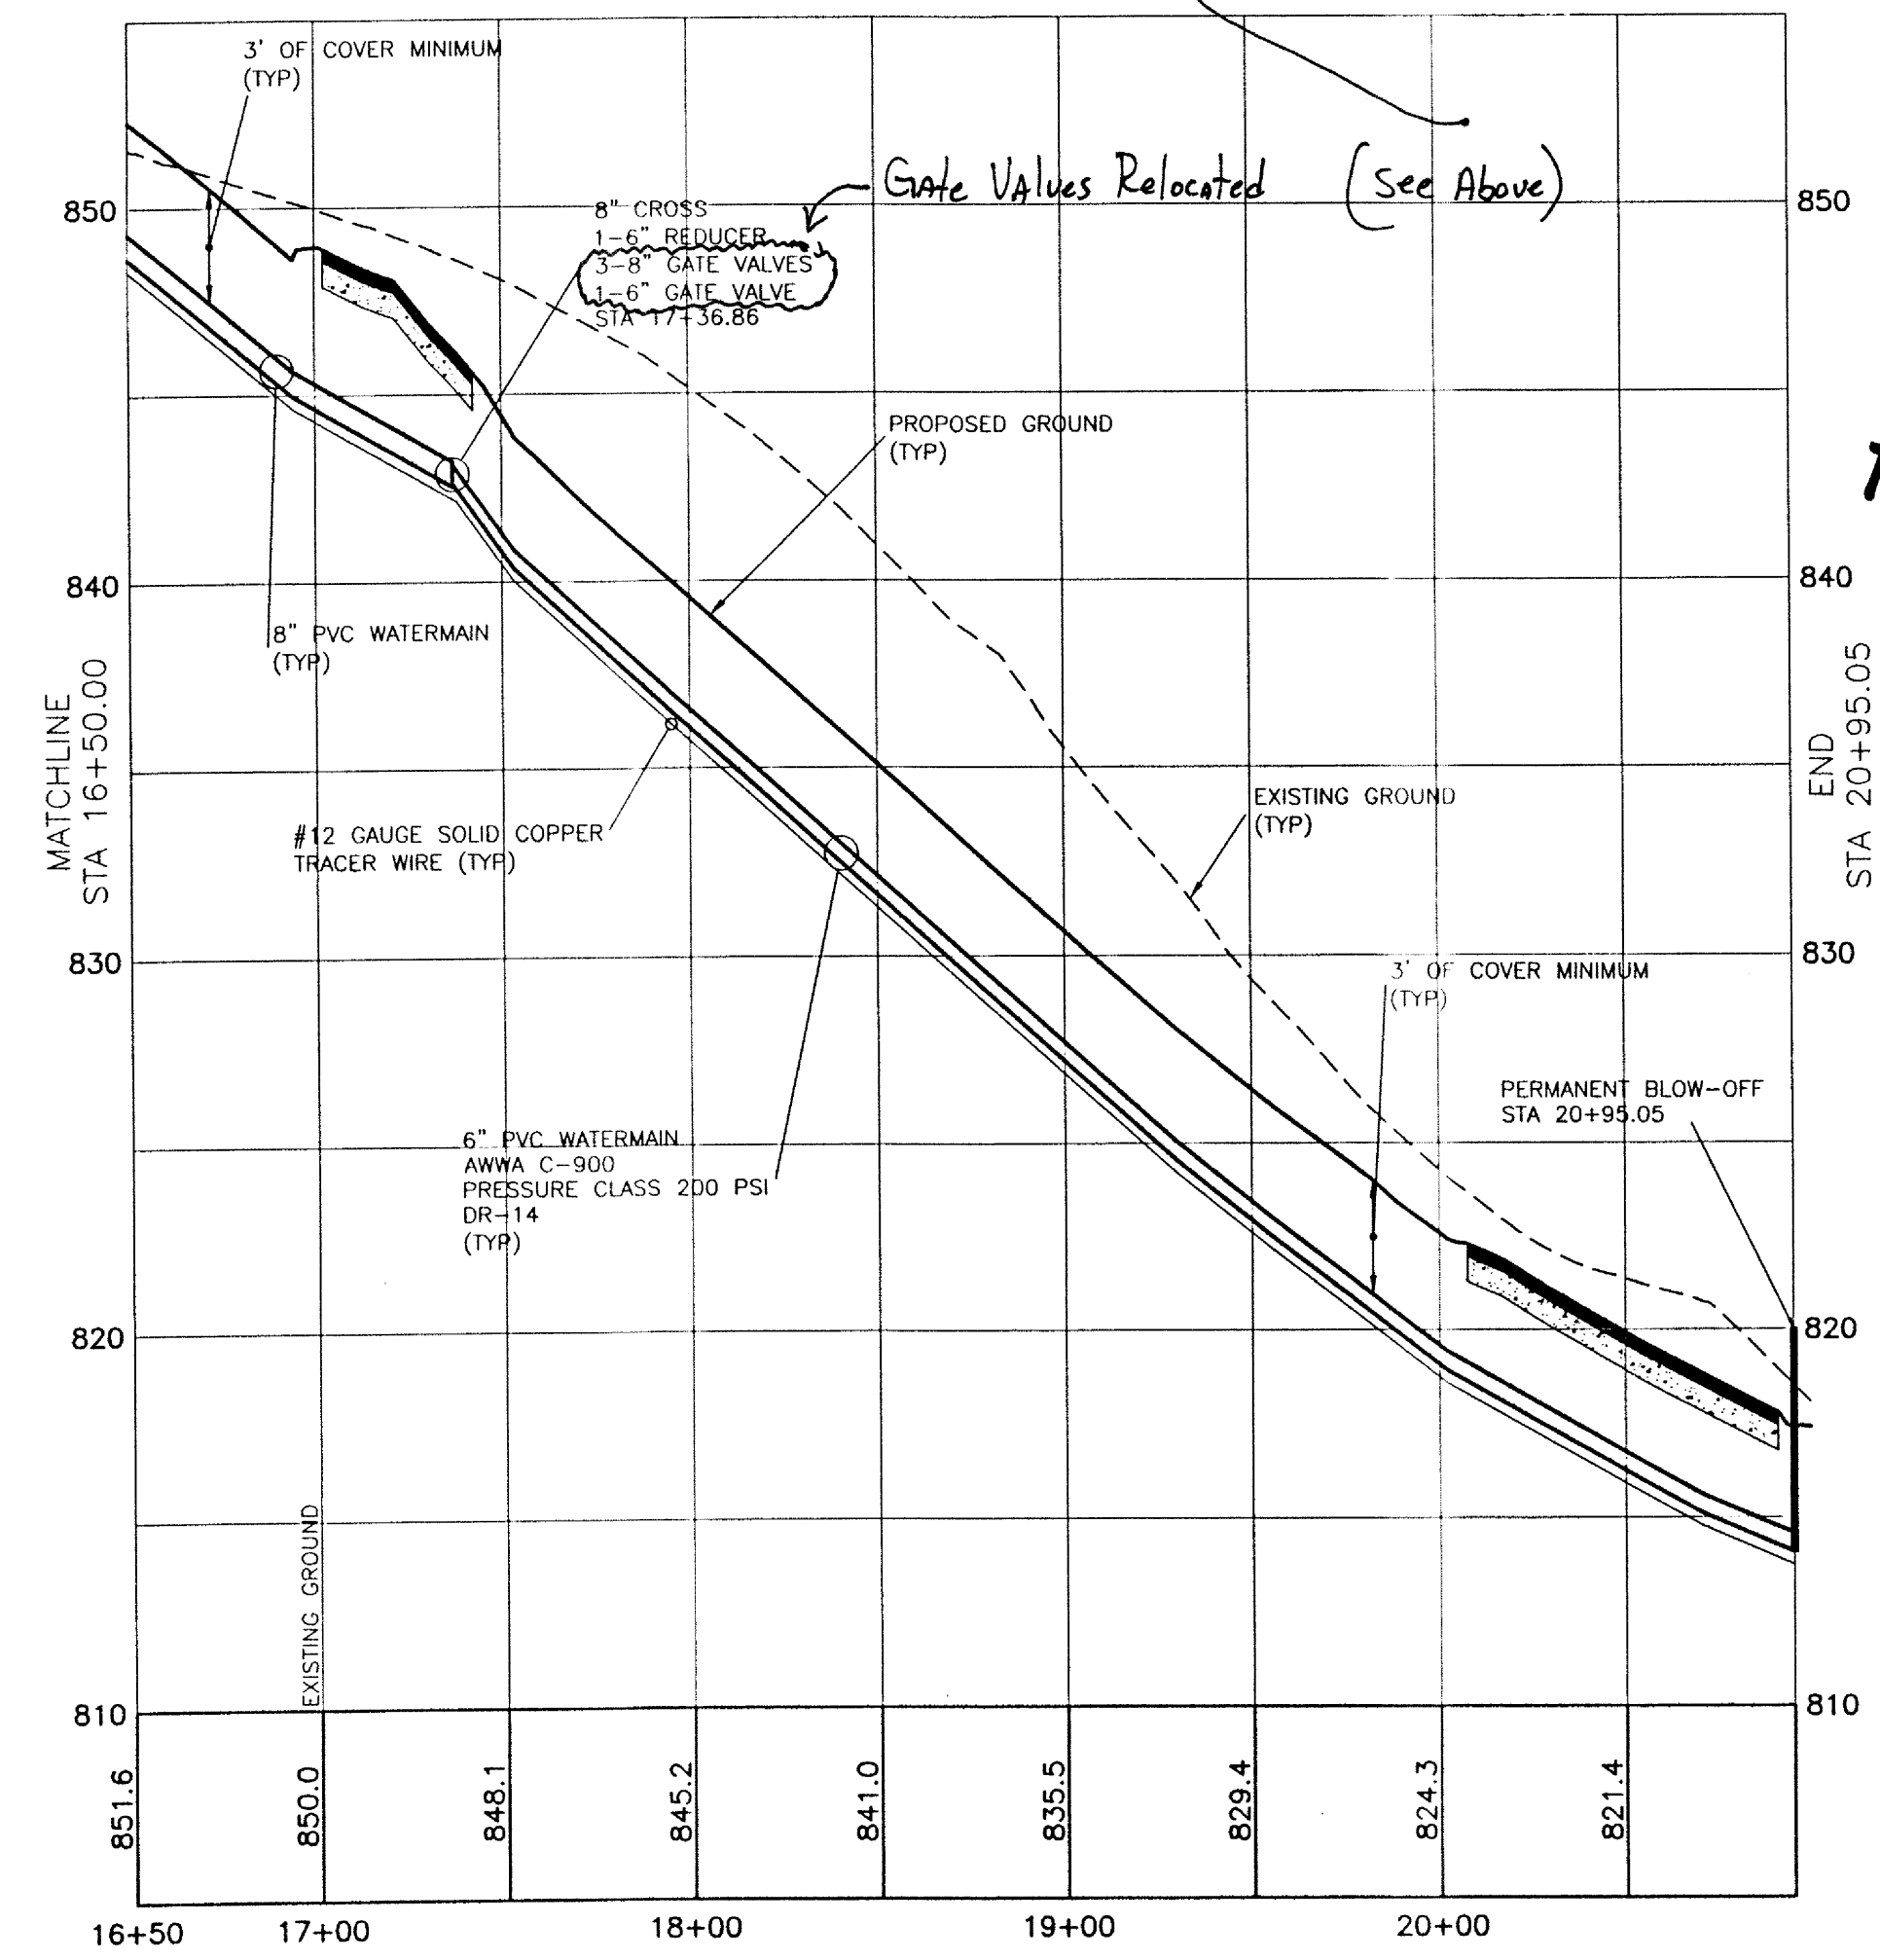
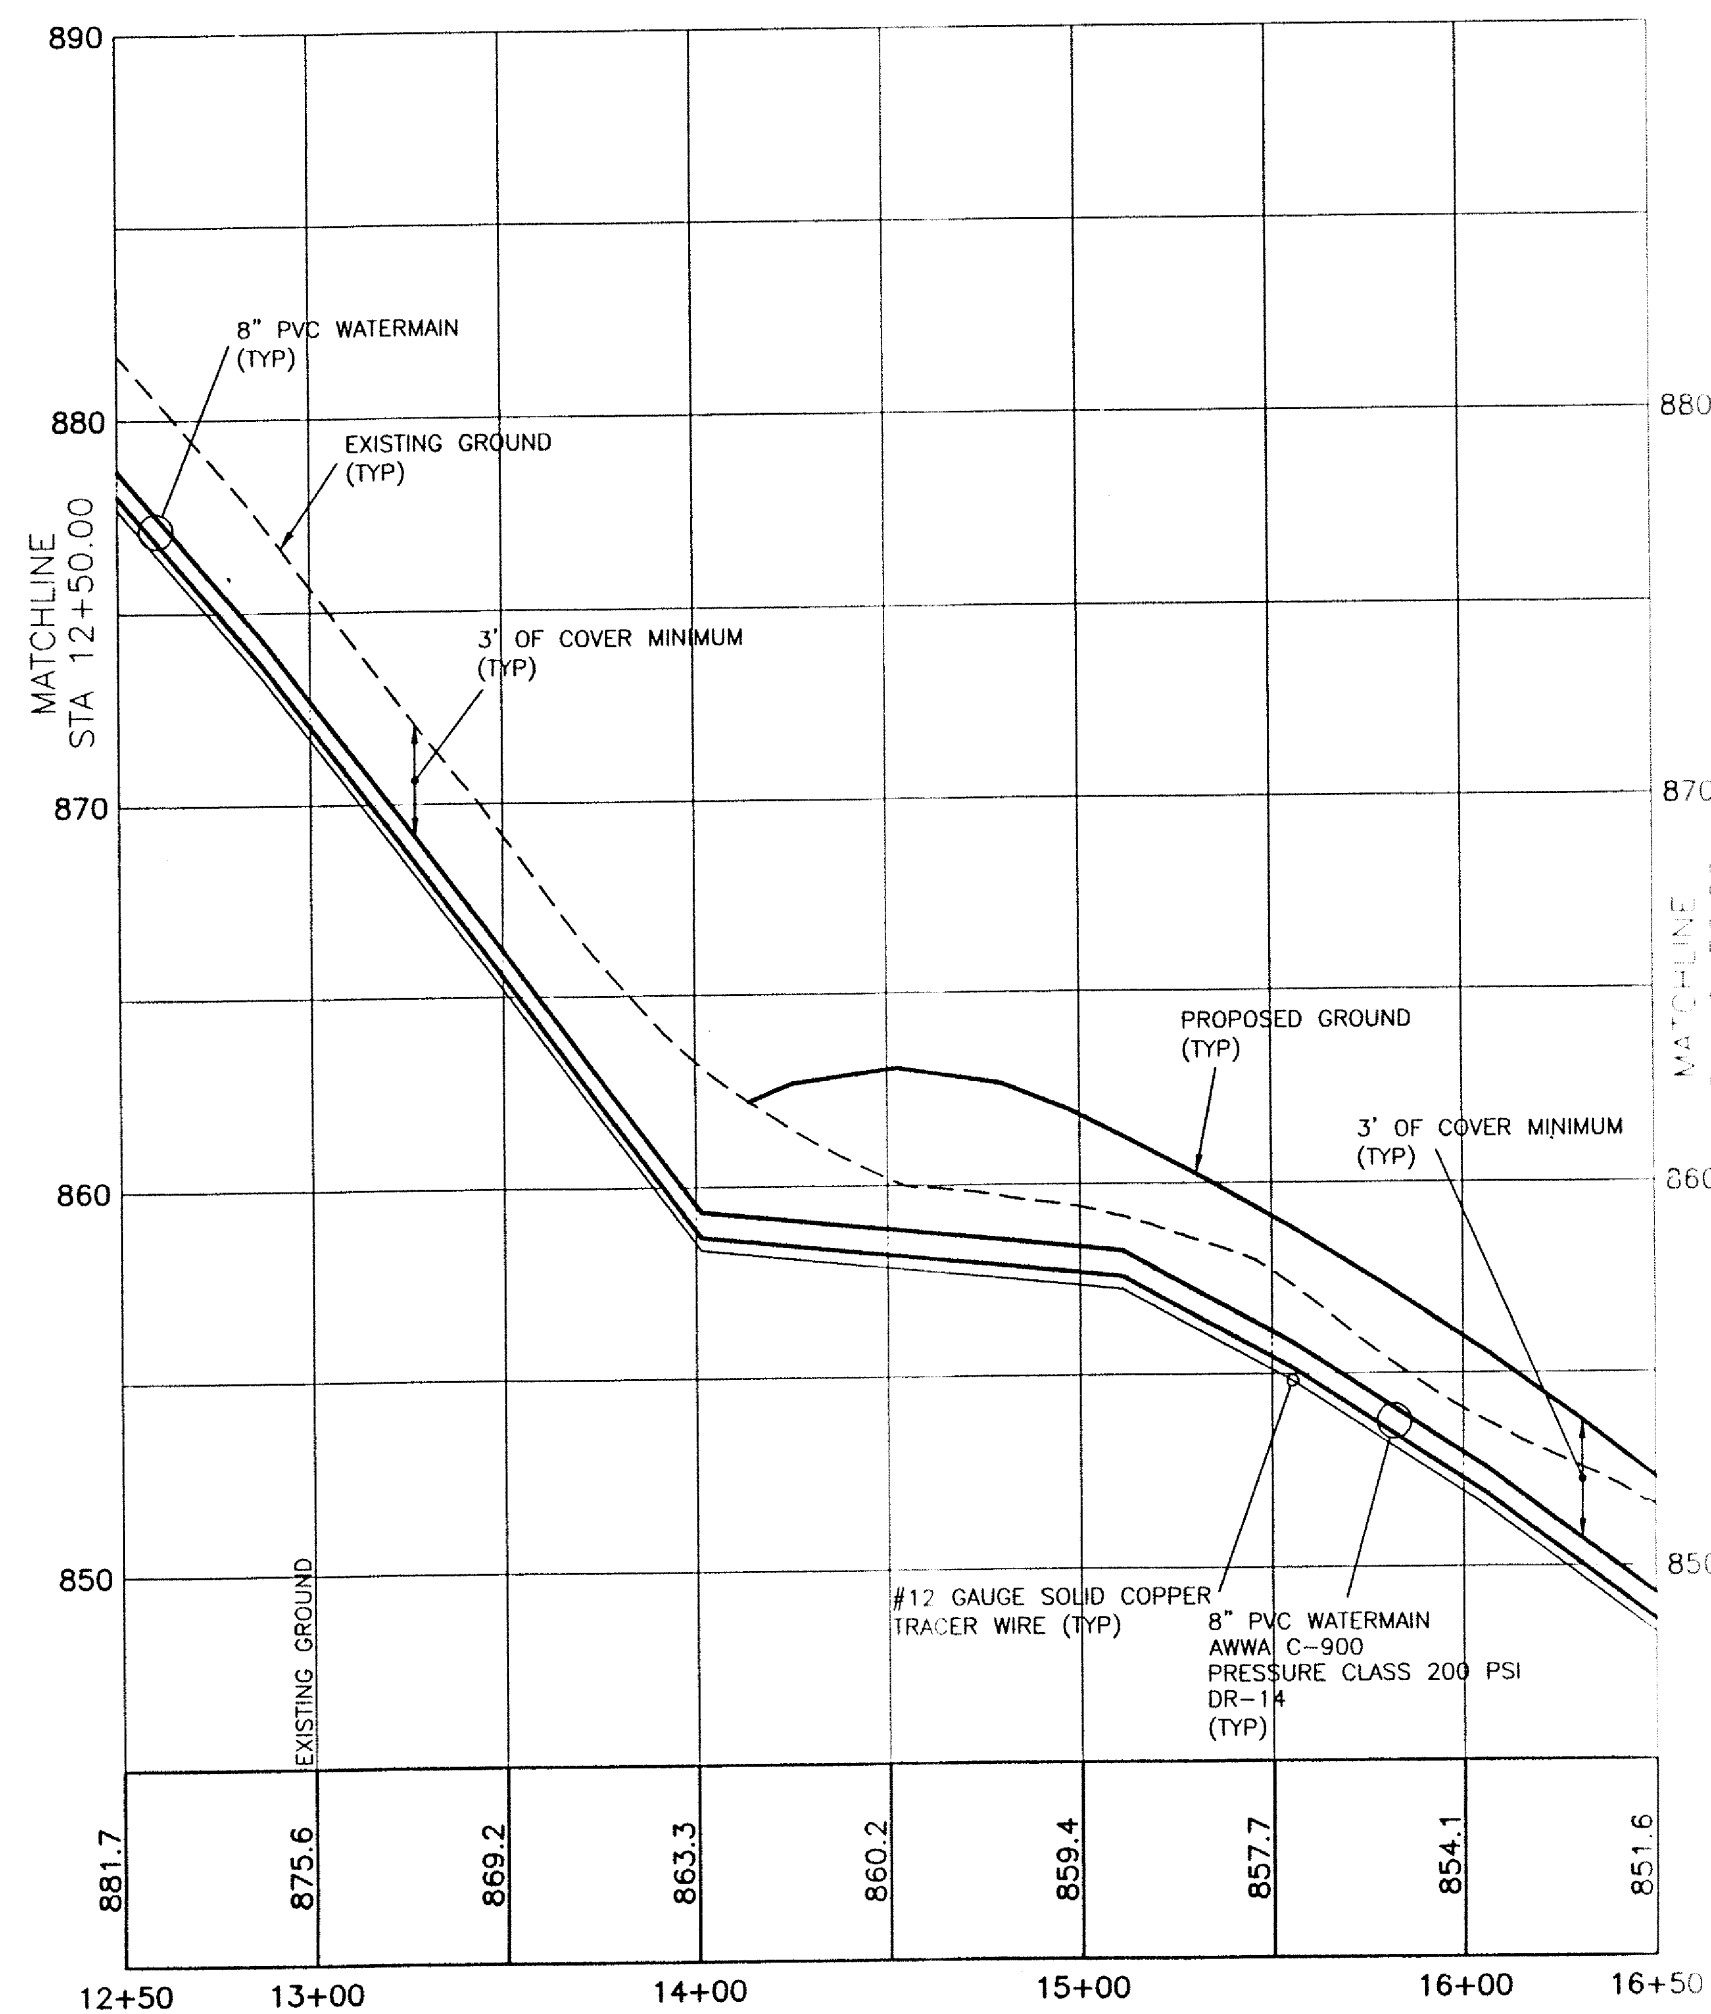


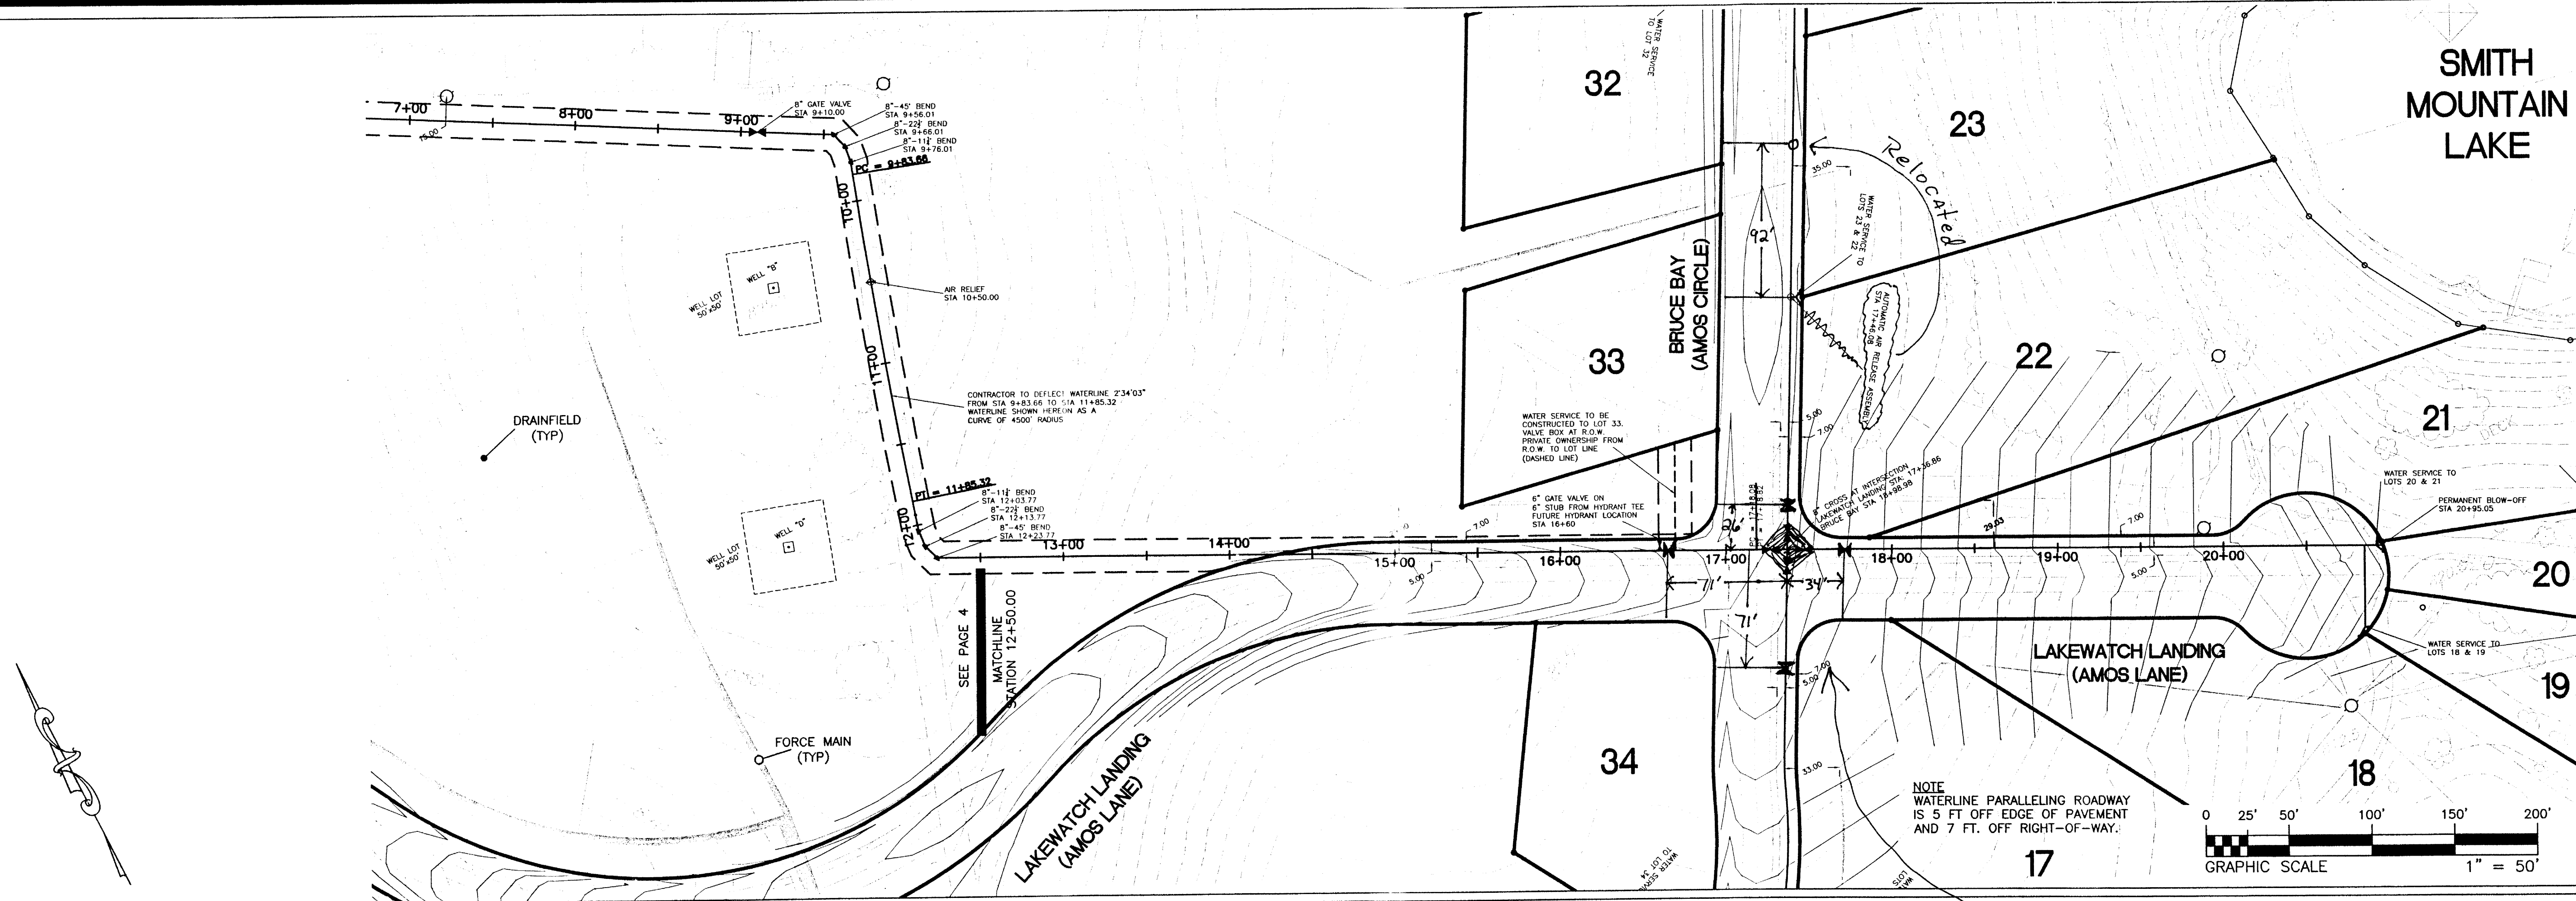

As-Built's

SCALE
1" = 50' HORIZ.
1" = 5' VERT.

REVISIONS	DATE	APPROVAL
AMENDED TO ADD COUNTY FEED AND REMOVE WTP	01-21-10	
DESCRIPTION		

Stone Engineering
P.O. BOX 1058
Rocky Mount, Virginia 24151
(540) 483-0078
(540) 483-5250 fax

DESIGN	CDS
DRAFT	CDS
CHECK	RDS

PLAN & PROFILE - LAKEWATCH LANDING
THE LAKEWATCH CLUB
LOCATED ON DUDLEY AMOS ROAD - S.R. 601
GILLS CREEK MAGISTERIAL DISTRICT
FRANKLIN COUNTY, VIRGINIA

DATE 07/10/09
SCALE AS SHOWN
SHEET 5 OF 13
PROJECT NUMBER 08094