


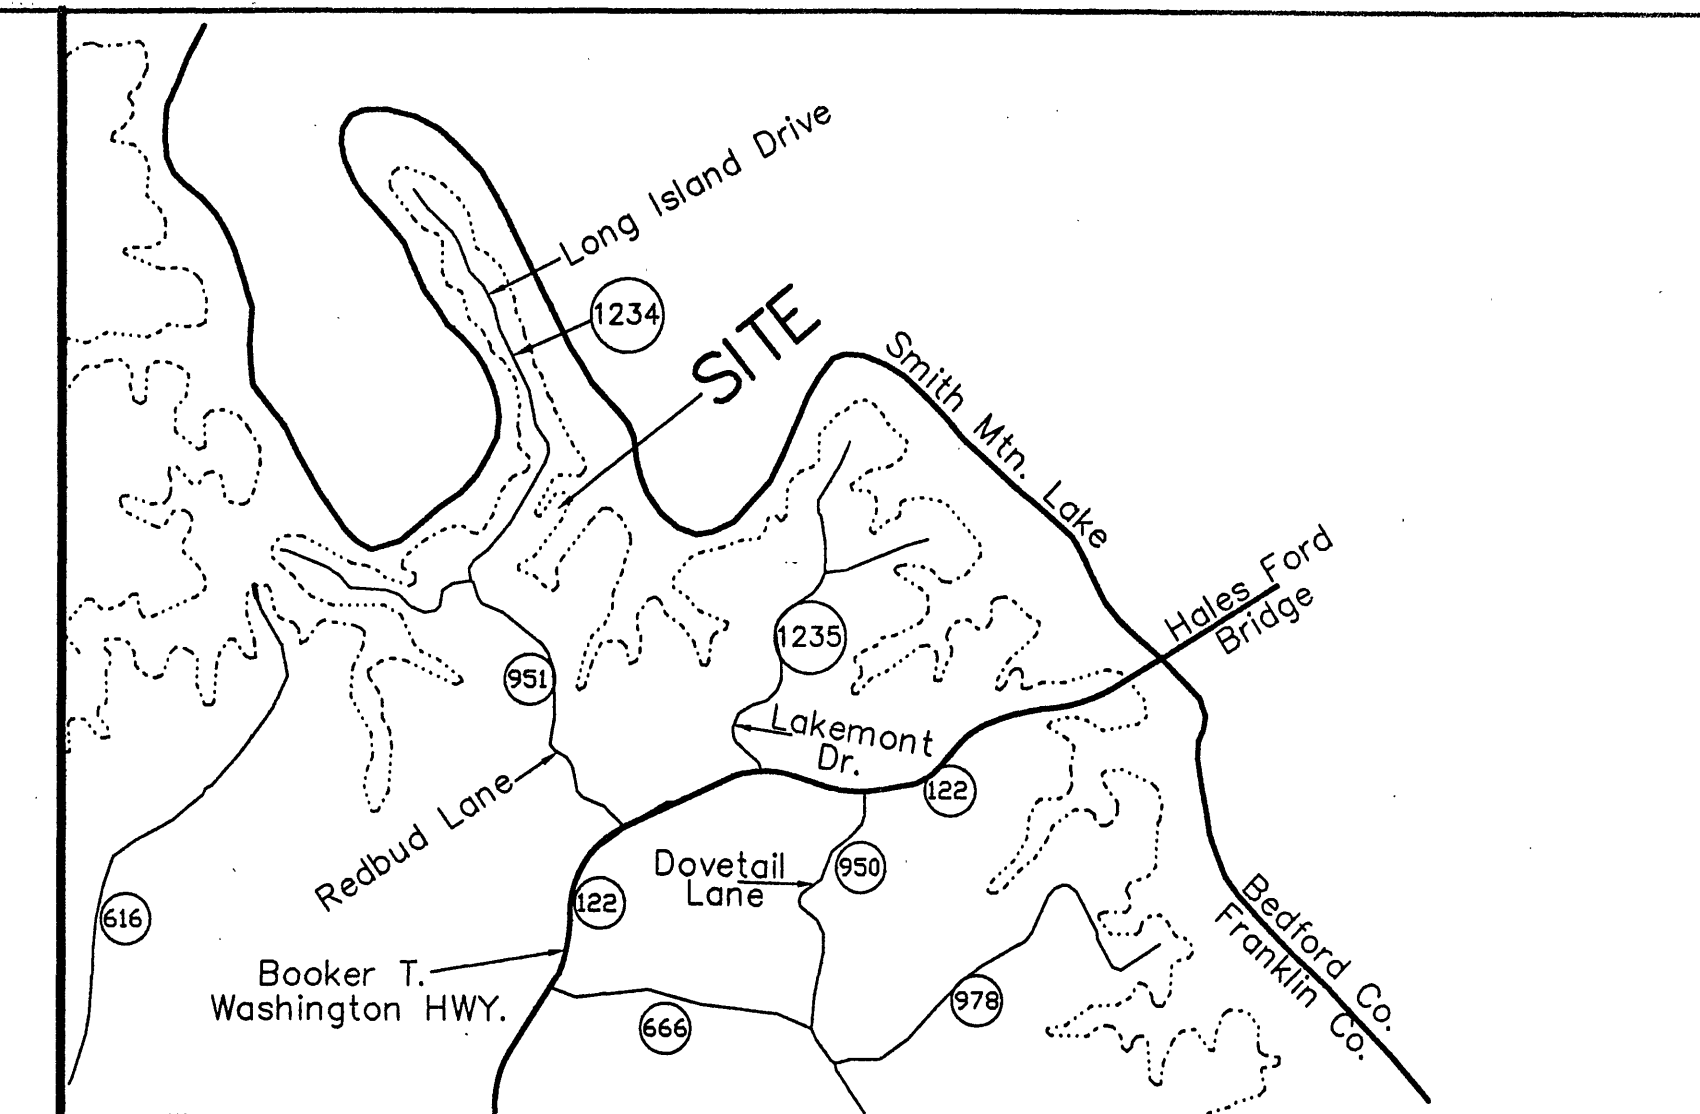

THE WINDWARD @ POINTE CHELI WATER & SEWER PLANS

GILLS CREEK DIST., FRANKLIN CO., VA.
DATE: JUNE 23, 2006

APPROVED


OCT 16 2006

BY: *David Vogt*

As-Built 2007

INDEX

SHEET 1 OF 6 = COVER SHEET / LOCATION MAP
SHEET 2 OF 6 = PLAN SHEET
SHEET 3 OF 6 = PROFILE
SHEET 4 OF 6 = E-ONE SEWER DETAILS
SHEET 5 OF 6 = SEWER LINE DETAILS
SHEET 6 OF 6 = WATER LINE DETAILS

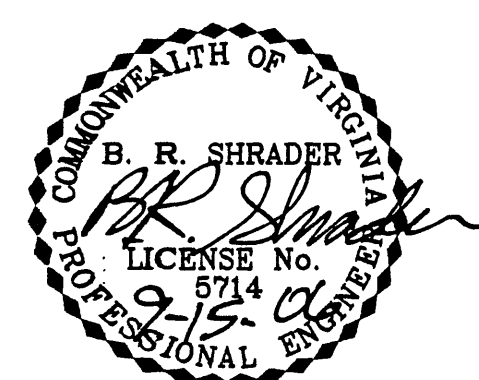

Owner Developer: SMLGP, Development LLC
Contact Person: Jim Petrine
16430 Booker T. Washington Hwy.
(UNIT 5) Moneta Va. 24121
Phone: 540-721-4594



SHRADER ENGINEERING & LAND SURVEYING, INC.
119 S. BRIDGE ST.
BEDFORD, VA. 24523
PHONE (540) 586-4710 FAX (540) 586-5407

LAST REVISION 9/15/06