



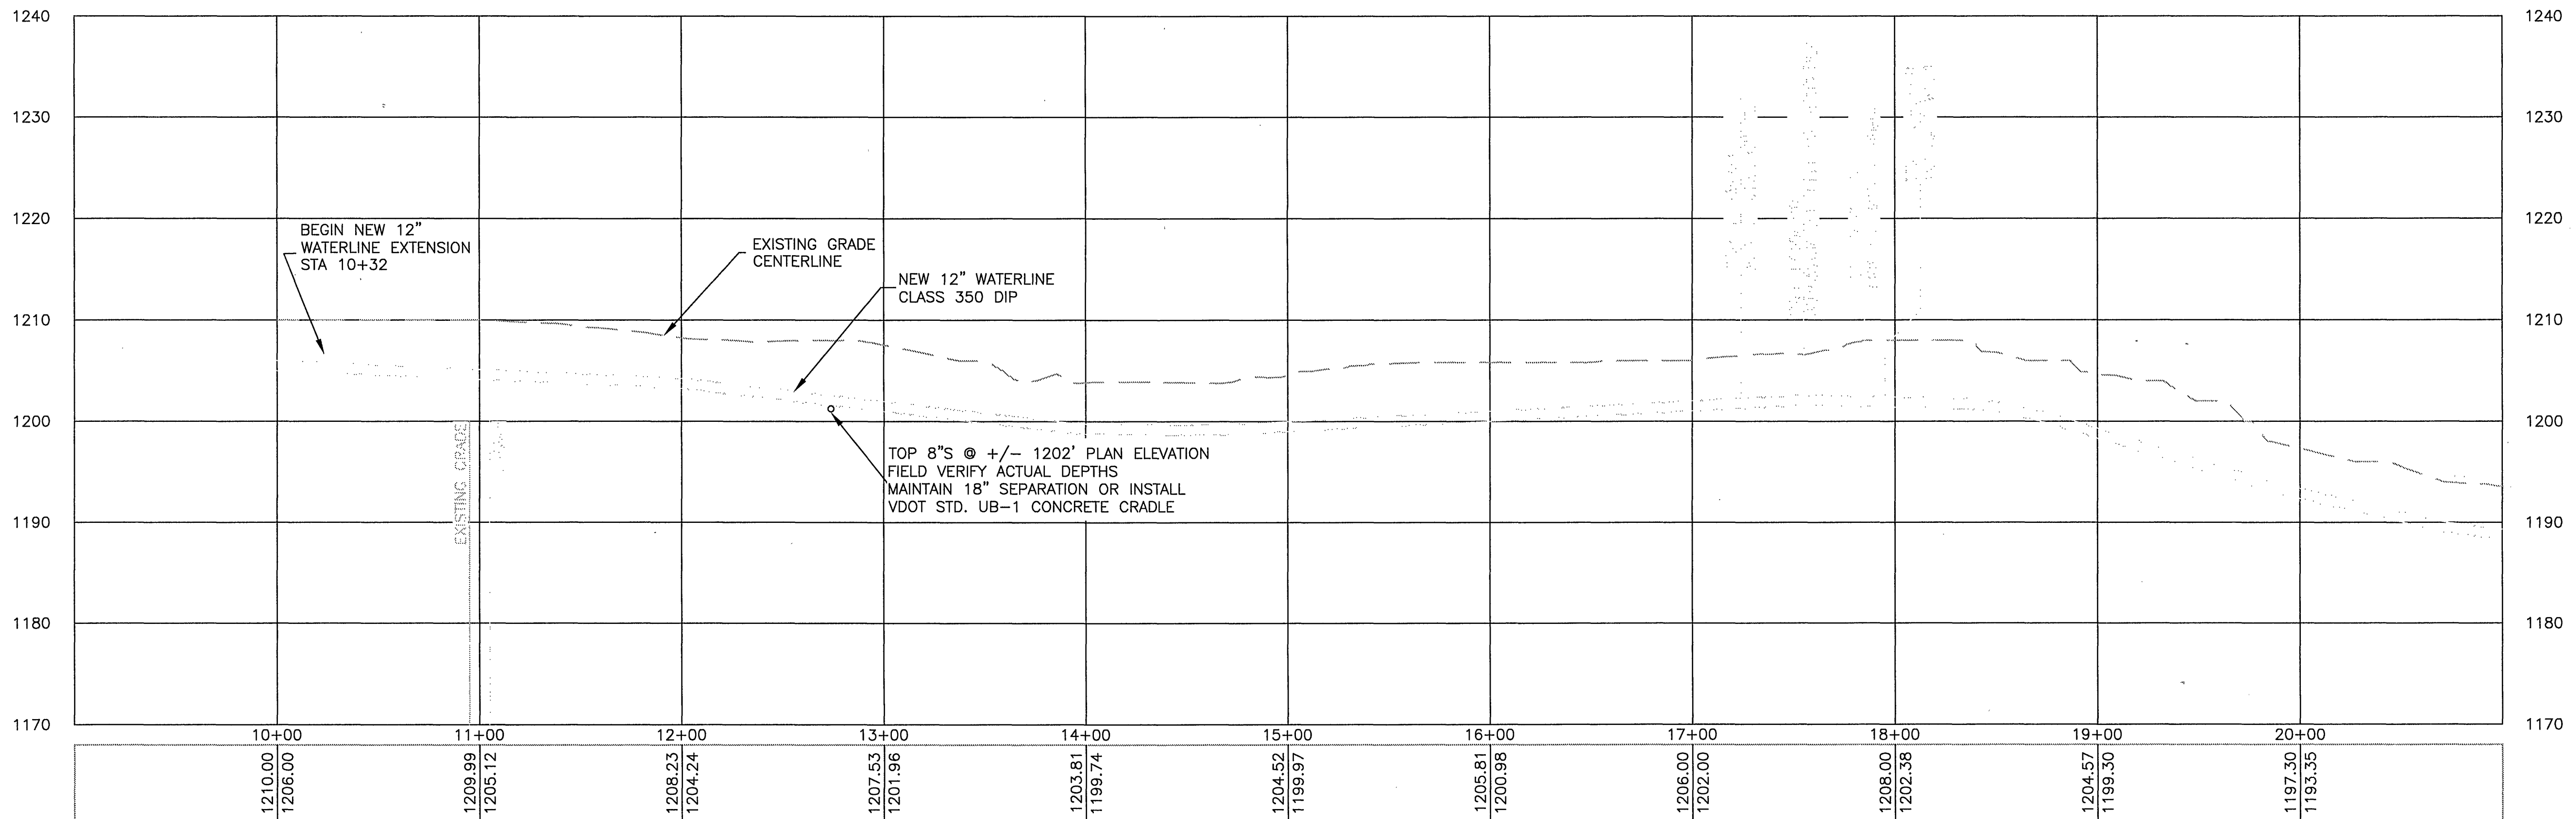

VG DENOTES VIRGIL H. GOODE
WR DENOTES WIRTZ ROAD
WFL DENOTES WINEFIELD LANE


No:	Revisions:	Date:
1	WESTERN VIRGINIA WATER AUTHORITY COMMENTS	07/19/10

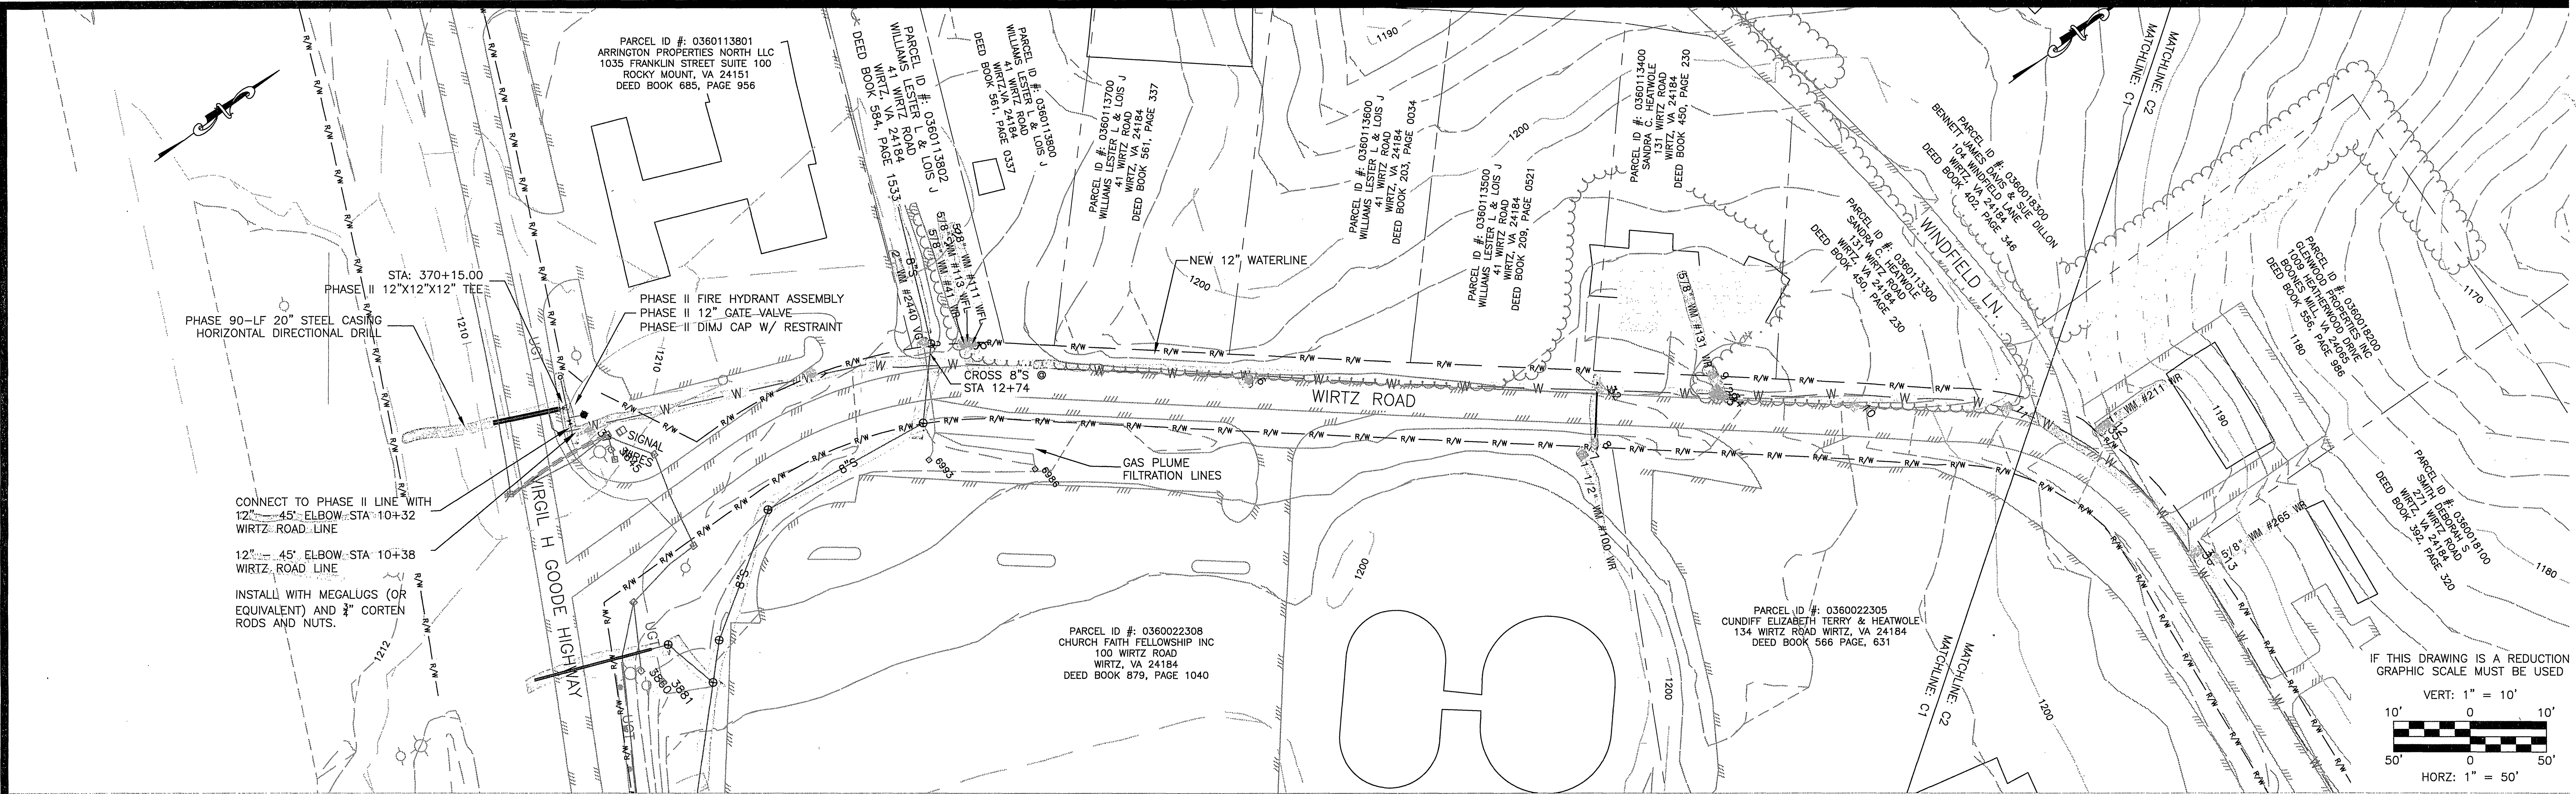

ADDRESS:
235 CLAIBORNE AVE.
ROCKY MOUNT, VA 24151

PHONE NUMBERS:
PHONE: (540) 483-5975
FAX: (540) 483-2221

WEBSITE
WWW.EARTHENV.COM

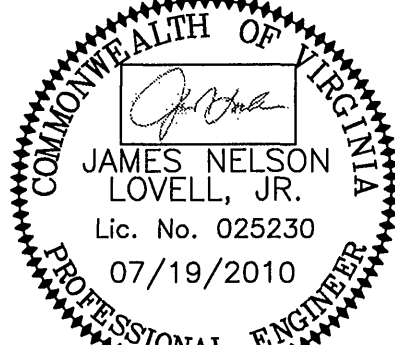

DESIGN BY: BKS	PROJECT: COUNTY OF FRANKLIN WIRTZ ROAD WATERLINE EXTENSION FRANKLIN COUNTY, VA	DATE: 11/19/2010
DRAWN BY: ANL/BKS	TITLE: AS-BUILT LOCATIONS WIRTZ ROAD WATERLINE EXTENSION STA - 10+00.00 TO 20+00.00	DRAWING NUMBER: C1
REVIEWED BY: JNL	PROJECT NUMBER: 09-0030	SHEET NUMBER: 2 of 5
DRAWING NAME: 09-0030.dwg	SCALE: H: 1" = 50'	