


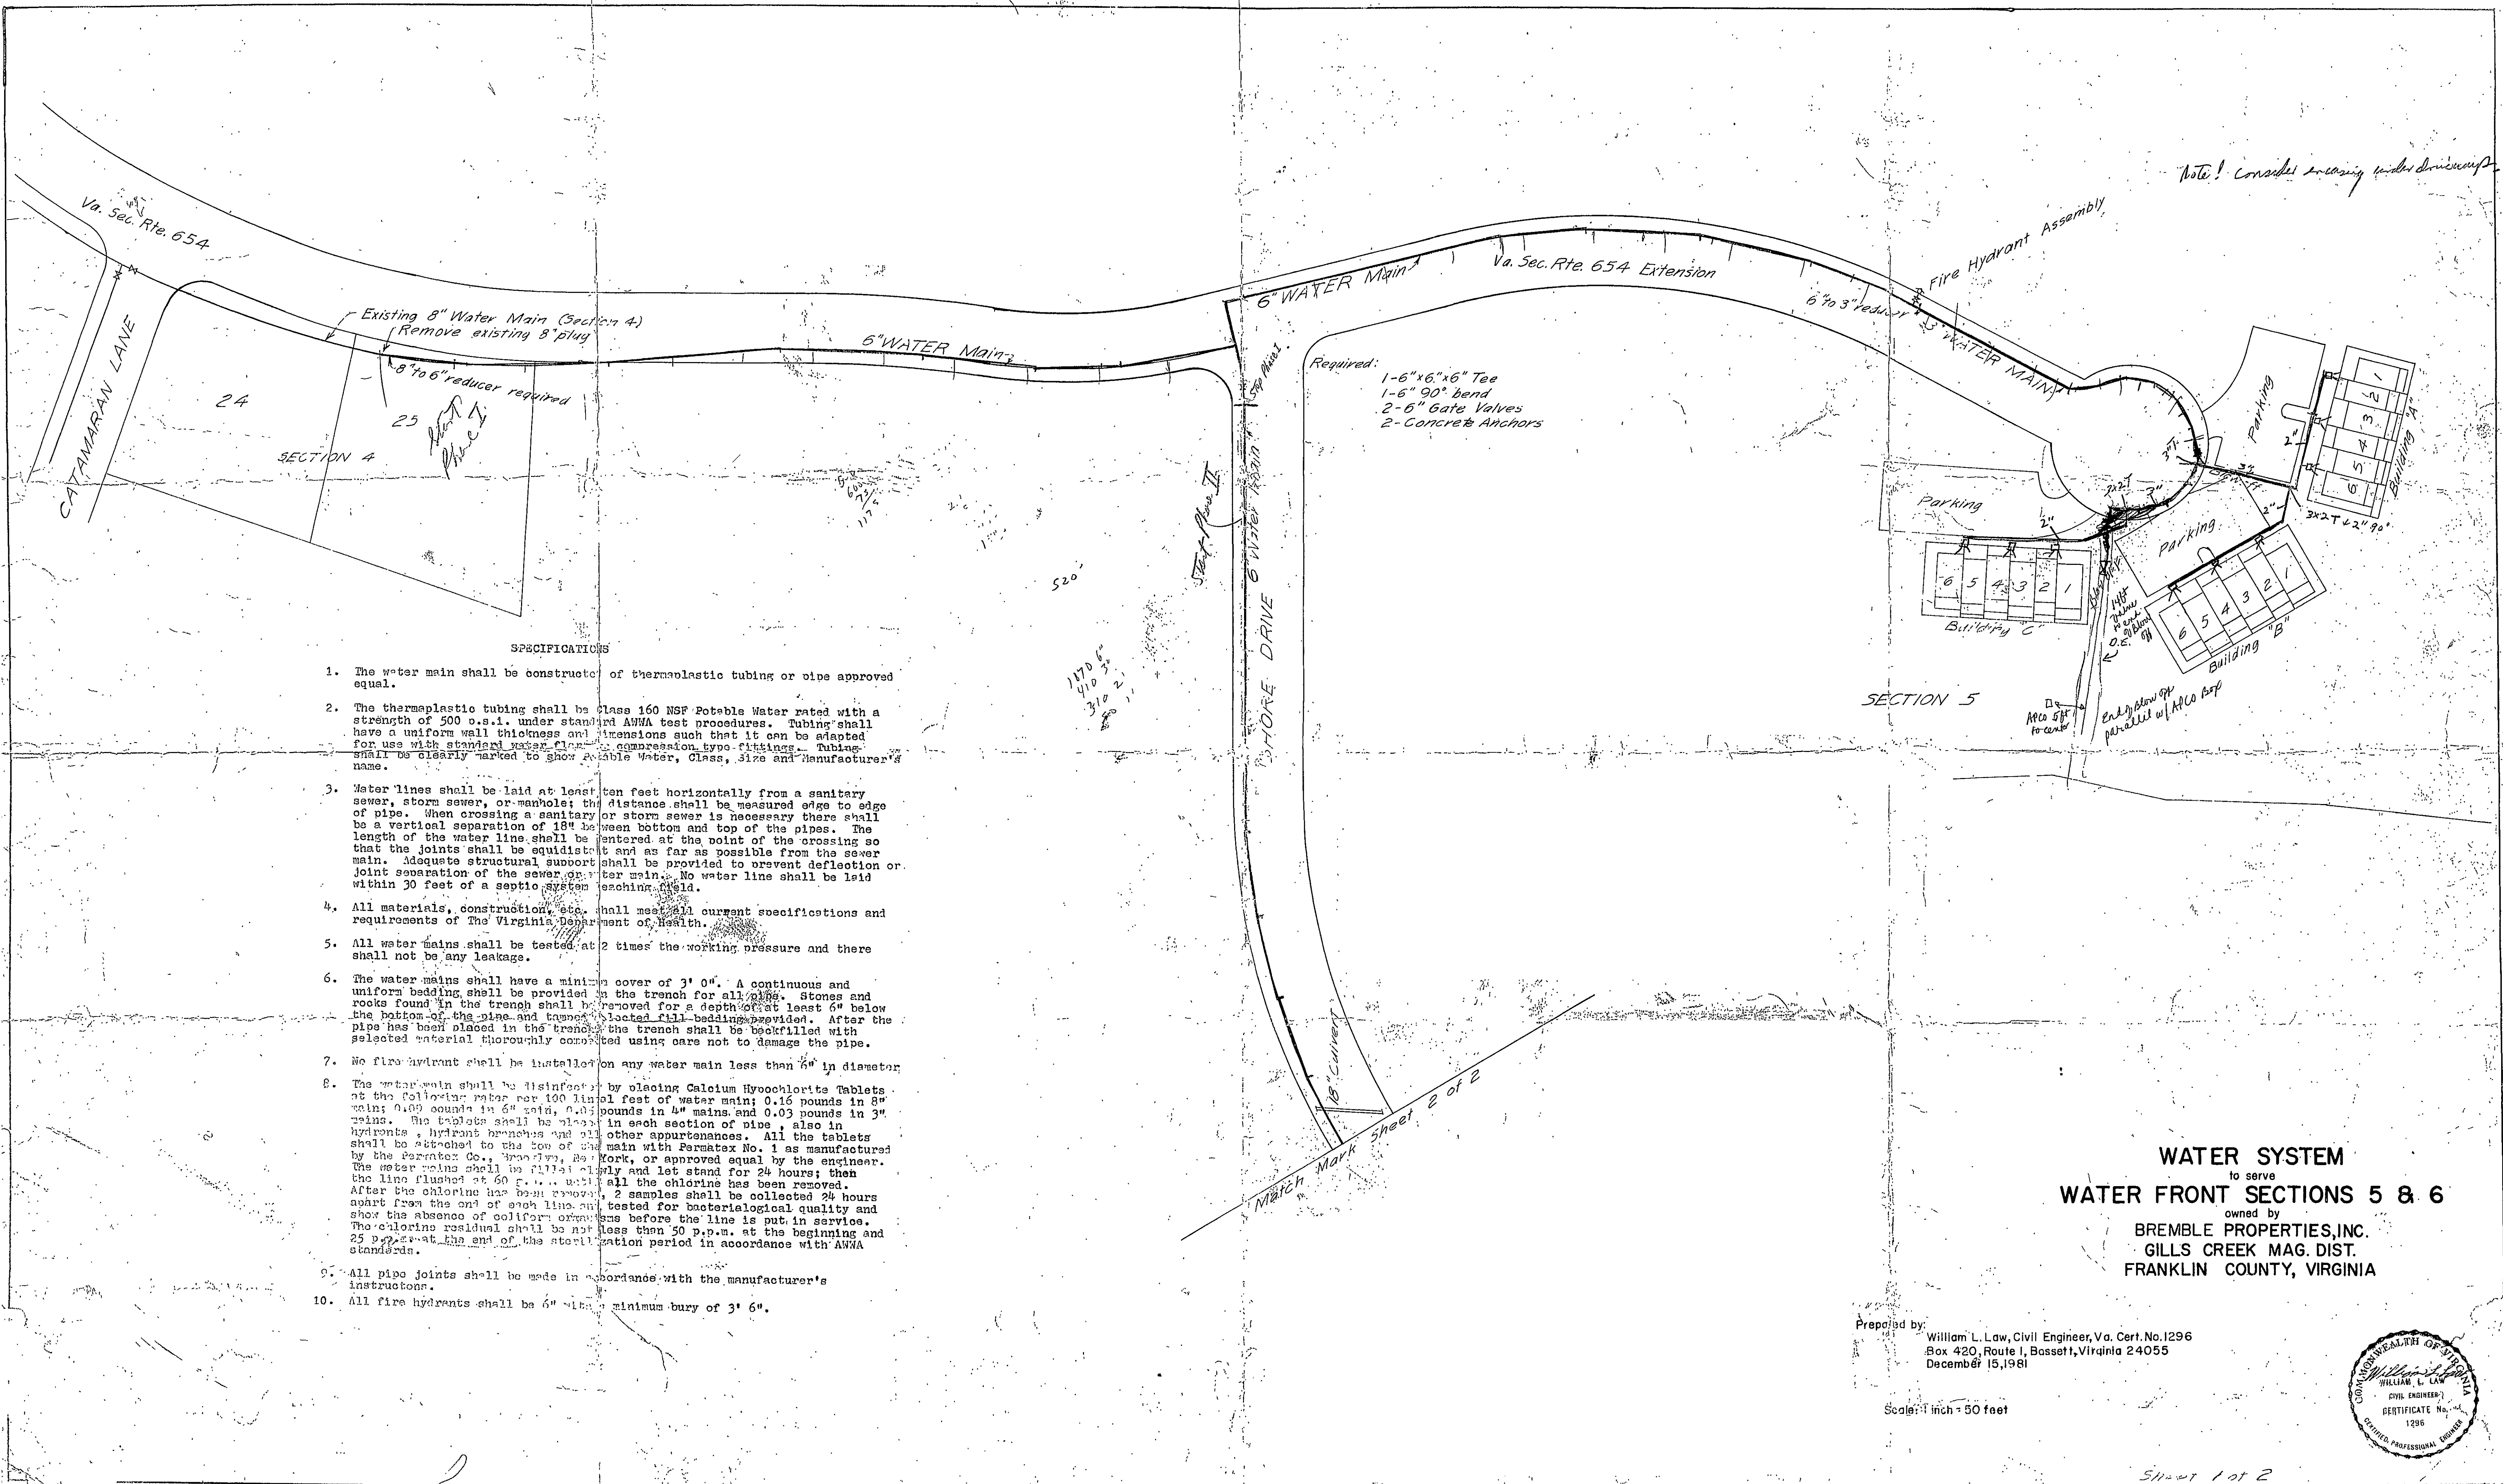

- SPECIFICATIONS**
1. The water main shall be constructed of thermoplastic tubing or pipe approved equal.
 2. The thermoplastic tubing shall be Class 160 NSF Potable Water rated with a strength of 500 p.s.i. under standard ASTM test procedures. Tubing shall have a uniform wall thickness and dimensions such that it can be adapted for use with standard water pipe compression type fittings. Tubing shall be clearly marked to show Potable Water, Class, Size and Manufacturer's name.
 3. Water lines shall be laid at least ten feet horizontally from a sanitary sewer, storm sewer, or manhole; the distance shall be measured edge to edge of pipe. When crossing a sanitary or storm sewer is necessary there shall be a vertical separation of 18" between bottom and top of the pipes. The length of the water line shall be centered at the point of the crossing so that the joints shall be equidistant and as far as possible from the sewer main. Adequate structural support shall be provided to prevent deflection or joint separation of the sewer or water main. No water line shall be laid within 30 feet of a septic system leaching field.
 4. All materials, construction, etc., shall meet all current specifications and requirements of The Virginia Department of Health.
 5. All water mains shall be tested at 2 times the working pressure and there shall not be any leakage.
 6. The water mains shall have a minimum cover of 3' 0". A continuous and uniform bedding shall be provided in the trench for all pipe. Stones and rocks found in the trench shall be removed for a depth of at least 6" below the bottom of the pipe and tamped. Selected fill bedding provided. After the pipe has been placed in the trench the trench shall be backfilled with selected material thoroughly compacted using care not to damage the pipe.
 7. No fire hydrant shall be installed on any water main less than 6" in diameter.
 8. The water main shall be disinfected by placing Calcium Hypochlorite Tablets at the following water per 100 linear feet of water main: 0.16 pounds in 8" mains; 0.09 pounds in 6" mains; 0.05 pounds in 4" mains and 0.03 pounds in 3" mains. The tablets shall be placed in each section of pipe, also in hydrants, hydrant branches and all other appurtenances. All the tablets shall be attached to the top of the main with Permatex No. 1 as manufactured by the Permatex Co., Worcester, Mass., or approved equal by the engineer. The water mains shall be flushed slowly and let stand for 24 hours; then the line flushed at 60 p.p.m. until all the chlorine has been removed. After the chlorine has been removed 2 samples shall be collected 24 hours apart from the end of each line and tested for bacteriological quality and show the absence of coliform organisms before the line is put in service. The chlorine residual shall be not less than 50 p.p.m. at the beginning and 25 p.p.m. at the end of the sterilization period in accordance with ASTM standards.
 9. All pipe joints shall be made in accordance with the manufacturer's instructions.
 10. All fire hydrants shall be 6" with a minimum bury of 3' 6".

WATER SYSTEM
to serve
WATER FRONT SECTIONS 5 & 6
owned by
BREMBLE PROPERTIES, INC.
GILLS CREEK MAG. DIST.
FRANKLIN COUNTY, VIRGINIA

Prepared by:
William L. Law, Civil Engineer, Va. Cert. No. 1296
Box 420, Route 1, Bassett, Virginia 24055
December 15, 1961

Scale: 1 inch = 50 feet



Sheet 1 of 2