


SANITARY SEWER LIFT STATION PROFILE Ph. 1B (Private)

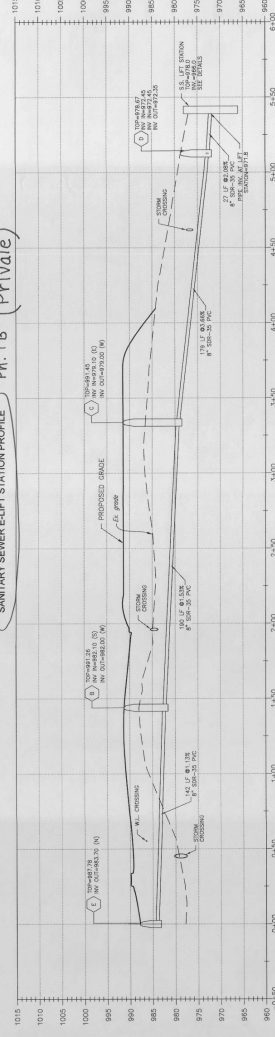


PROPOSED SANITARY SEWER SCHEDULE


- ① 5.5 MANHOLE (PRIVATE)
INVERT: 988.21
NM: 007-882.21
- ② 177 LF OF 8" SDR-35 AT 7.22%
- ③ 5.5 MANHOLE (PUBLIC)
INVERT: 988.21
NM: 007-882.21
- ④ 180 LF OF 8" SDR-35 AT 1.53%
- ⑤ 5.5 MANHOLE (PUBLIC)
INVERT: 979.51
NM: 007-879.51
- ⑥ 179 LF OF 8" SDR-35 AT 3.65%
- ⑦ 5.5 MANHOLE (PUBLIC)
INVERT: 972.35
NM: 007-872.35
- ⑧ 27 LF OF 8" SDR-35 AT 2.68%
- ⑨ 142 LF OF 8" SDR-35 AT 1.13%

NOTES: TO CONFORM TO CONSUMER ALL BUILDING TRAILING WITH B.E.P. AND ARCHITECTURAL DRAWINGS PRIOR TO CONSTRUCTION. TO CONFORM TO CONSUMER ALL BUILDING TRAILING WITH B.E.P. AND ARCHITECTURAL DRAWINGS PRIOR TO CONSTRUCTION. TO CONFORM TO CONSUMER ALL BUILDING TRAILING WITH B.E.P. AND ARCHITECTURAL DRAWINGS PRIOR TO CONSTRUCTION.

SANITARY SEWER A-D PROFILE Ph. 1A

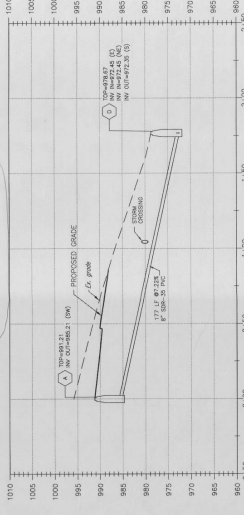

PROFILE SCALES:

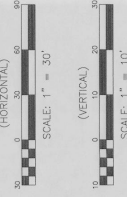

APPROVAL BLOCK

FRANKLIN COUNTY DEPARTMENT OF PLANNING & COMMUNITY DEVELOPMENT DATE

Ph. 1B Inspectors As-Built K.Winslow 4.1.24

Ph. 1A Inspectors As-Built K.Winslow 11.1.22



WESTLAKE VILLAGE APARTMENTS
PHASE 1
SANITARY PROFILES

DATE	11/1/22
DESIGNED BY	BAUZE
CHECKED BY	BAUZE
SCALE	AS SHOWN
PROJECT NO.	183000

C10
PROJECT NO. 183000