

 


OFF-SITE S.S. EXTENSION

DESIGNED BY	CPB
CHECKED BY	CPB
DATE	BTC
SCALE	4/30/23/19
REVISIONS	AS NOTED

	2011-2015	8-20-2015	10-06-2011	12-01-2011	3-24-2012	9-28-2012
PLANNING						

C11



(HORIZONTAL)

30 0 30 60 90

SCALE: 1" = 30'

The Force main
was installed per
plans As shown to
WWWA specs, except for
the note shown Above.

Johnston

APPROVAL BLOCK

FRANKLIN COUNTY DEPARTMENT OF PLANNING & COMMUNITY DEVELOPMENT	DATE
--	------