




1. WATER & SEWER RELOCATION AND RECONNECTION SHALL BE COORDINATED WITH THE OWNER TO ENSURE MINIMAL UTILITY SERVICE DISRUPTION.
2. NEW 6" WATER LINE TO BE INSTALLED, TESTED AND APPROVED BY THE WYMA PRIOR TO TAPPING INTO THE EXIST. 6" WATER LINE THAT WILL BE ABANDONED.
3. CAP EXIST. 6" WATER LINE NEAR STA. 5+00 AS SHOWN WHILE TYING IN WATER LINE AT STA. 1+00.


GRAPHIC SCALE

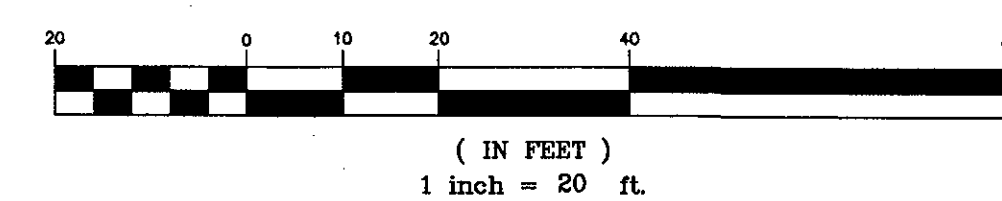

LA LUMSDEN ASSOCIATES, P.C.
ENGINEERS-SURVEYORS-PLANNERS
ROANOKE, VIRGINIA

4664 BRAMBLETON AVENUE
P.O. BOX 20669
ROANOKE, VIRGINIA 24018

PHONE: (540) 774-4411
FAX: (540) 772-9445
E-MAIL: MAIL@LUMSDENPC.COM

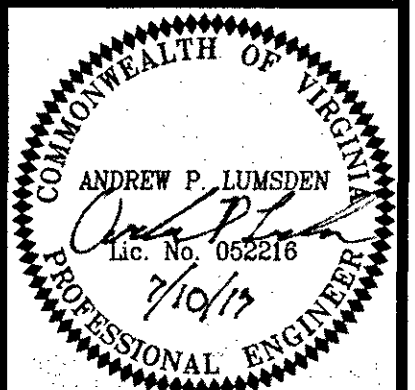

WATER LINE PLAN & PROFILE

**SITE DEVELOPMENT PLAN
FOR
WESTLAKE ASSISTED LIVING
BUILDING ADDITION
R & P SML FACILITY LLC
SITUATED ALONG CAREFREE COURT
FRANKLIN COUNTY, VIRGINIA**

REVISIONS		DESCRIPTION
NO.	DATE	
1		
2		
3		
4		
5		

DATE: July 10, 2017

SCALE: AS SHOWN

COMMISSION NO: 10-170

SHEET 7 OF 10

As-Built 2.7.19 K. Winslow