


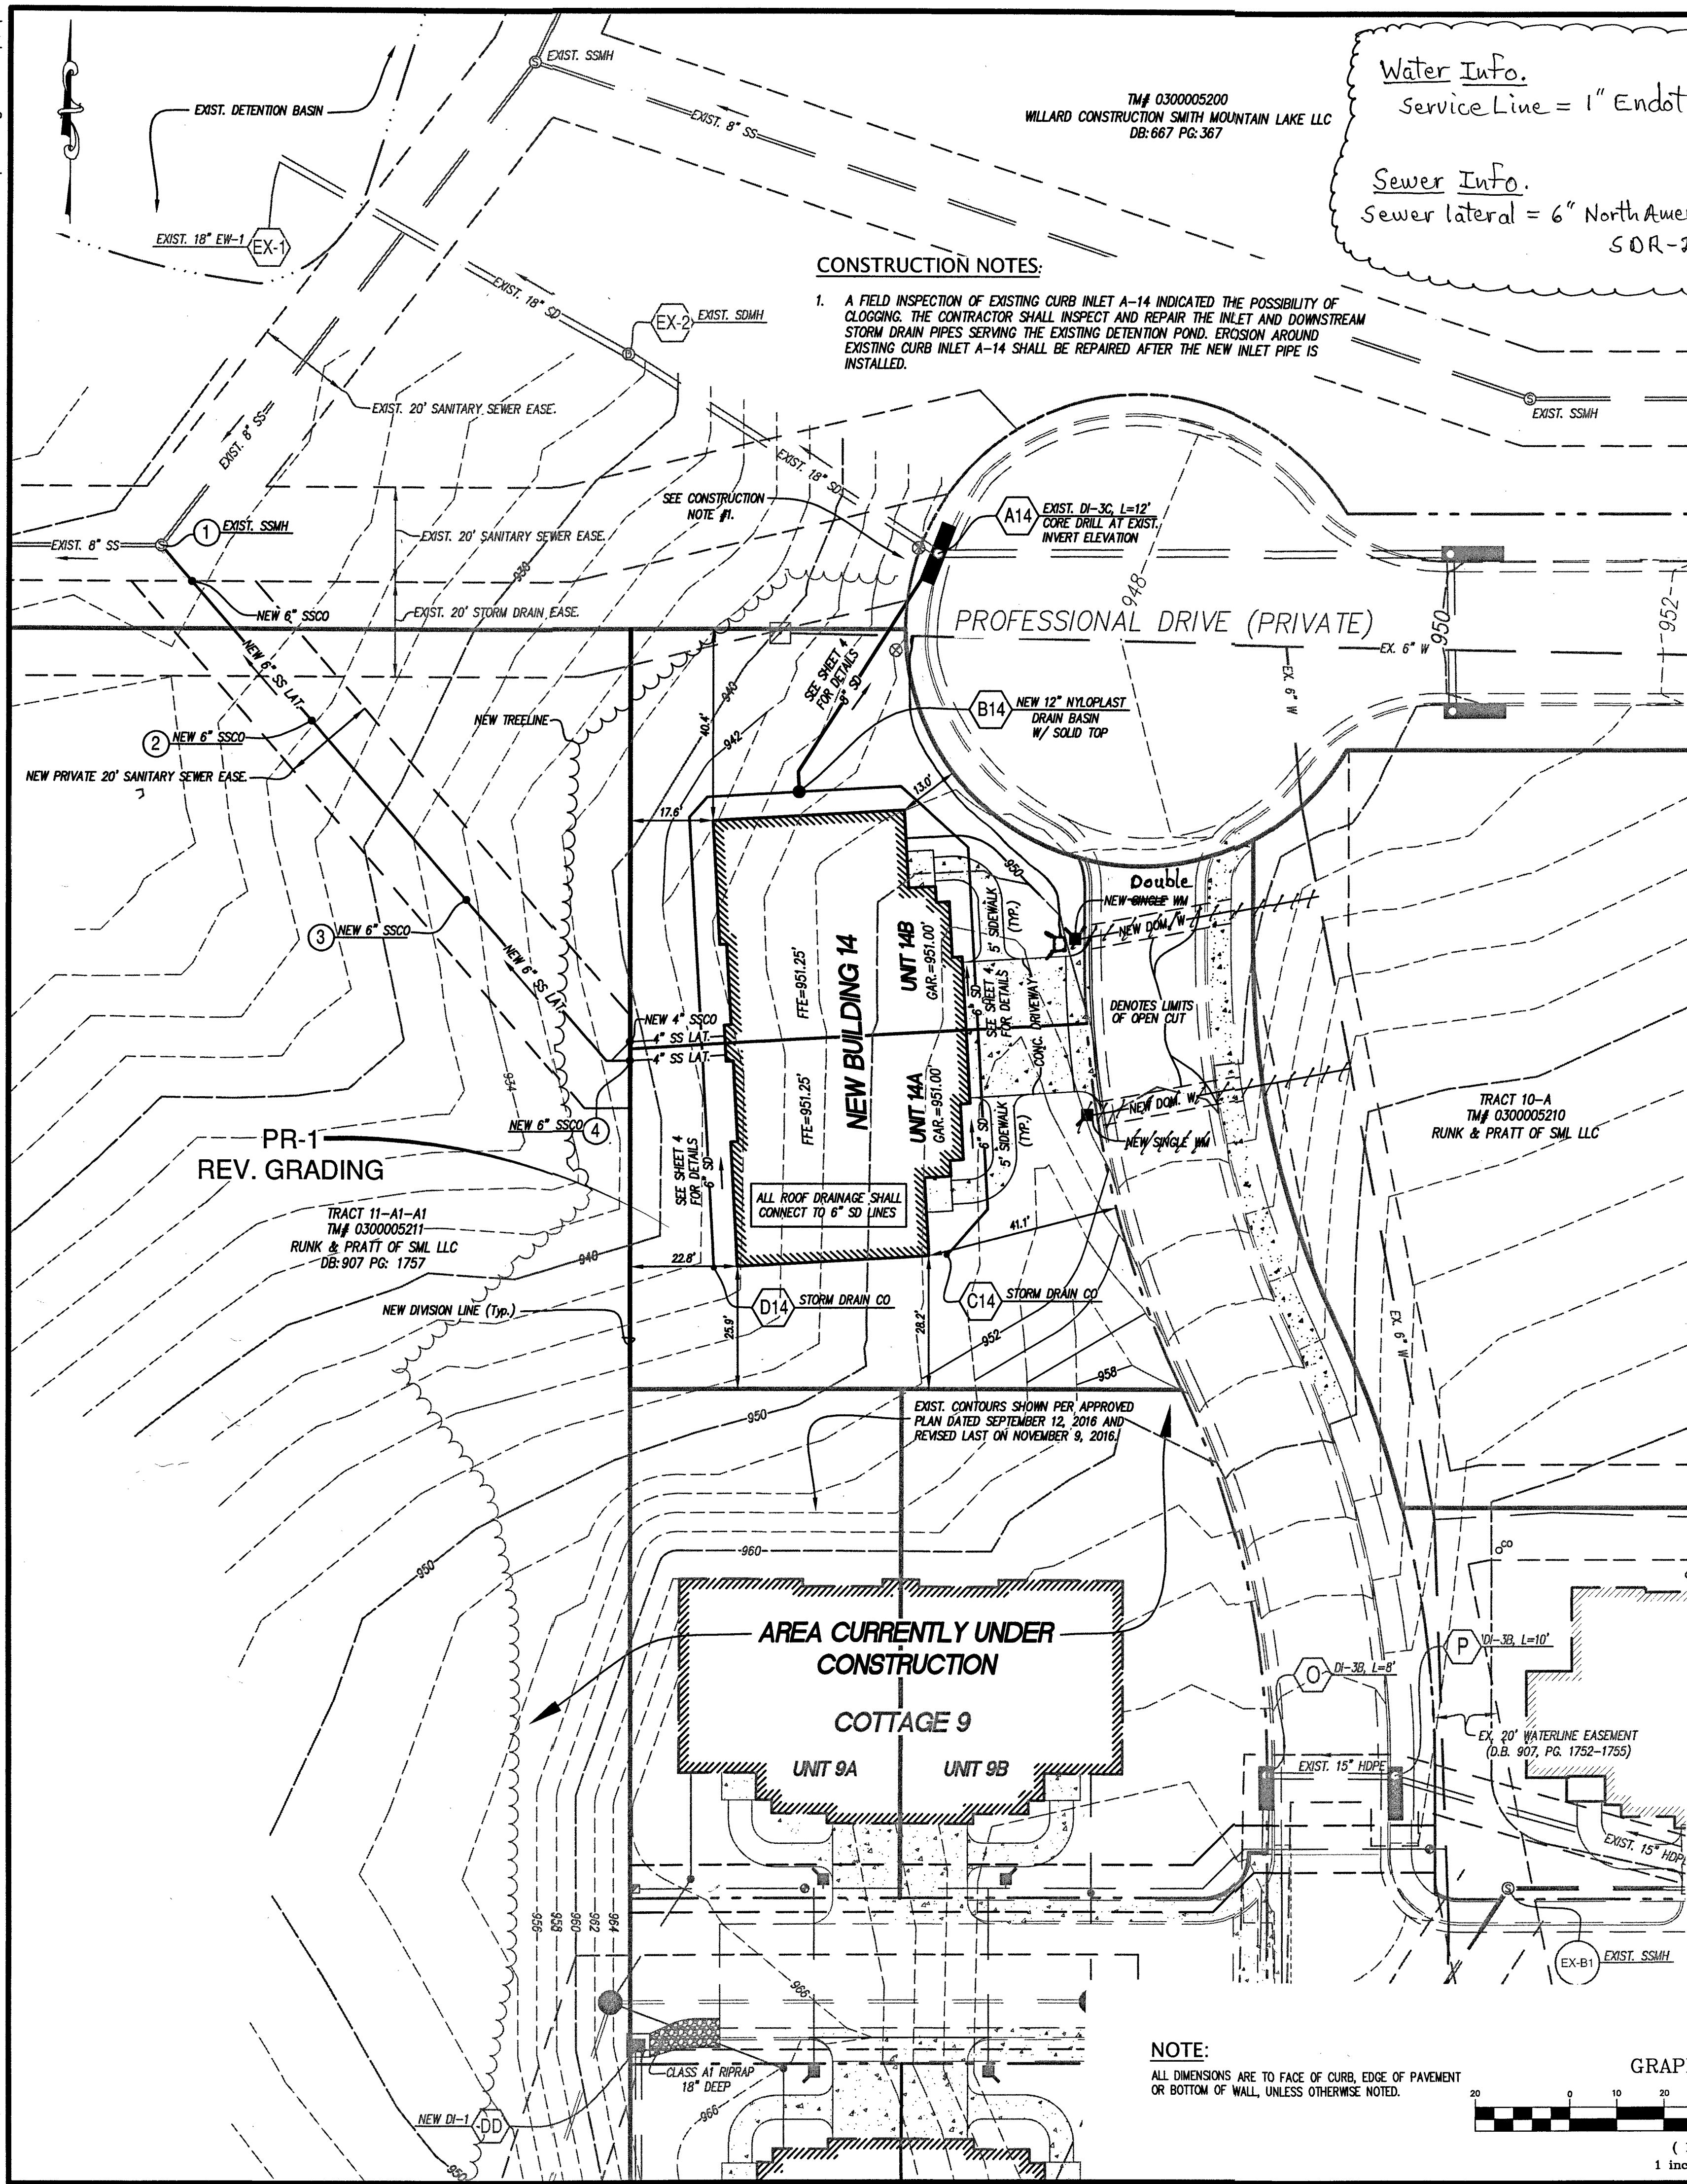

| SYMBOL & KEY                                                                          |    | SCIENTIFIC NAME                        | COMMON NAME            | SIZE (MIN.) | CONTAINER | QUANTITY |
|---------------------------------------------------------------------------------------|----|----------------------------------------|------------------------|-------------|-----------|----------|
| TREES                                                                                 |    |                                        |                        |             |           |          |
|  | AS | <i>Acer saccharum</i> 'Bonfire'        | 'BONFIRE' SUGAR MAPLE  | 1-1/2" CAL. | B&B       | 1        |
|  | BN | <i>Betula nigra</i> 'Heritage'         | 'HERITAGE' RIVER BIRCH | 1-1/2" CAL. | B&B       | 1        |
|  | CK | <i>Cornus kousa</i>                    | KOUSA DOGWOOD          | 1" CAL.     | B&B       | 2        |
| SHRUBS                                                                                |    |                                        |                        |             |           |          |
|  | BM | <i>Buxus microphylla</i> 'Wintergreen' | WINTERGREEN BOXWOOD    | 18"-24"     | #3        | 9        |
|  | EA | <i>Euonymus alatus</i> 'Compactus'     | DWARF BURNING BUSH     | 18"-24"     | #3        | 3        |

| REVISIONS |                                        |
|-----------|----------------------------------------|
| NO.       | DATE DESCRIPTION                       |
| 1         | 3/15/2017 REV. GRADING AROUND BLDG 14. |
| 2         |                                        |
| 3         |                                        |
| 4         |                                        |
| 5         |                                        |

DATE: February 14, 2017

SCALE: 1" = 20'

COMMISSION NO: 15-168

SHEET 3 OF 8

As-Built 1.18.18 K. Winslow