


AS-BUILT WATER AND SEWER PLAN
FOR
**WESTLAKE ASSISTED LIVING CENTER
COTTAGES 15 & 16 AND
QUADPLEX 1, 2 & 3**

SITUATED IN
GILL CREEK MAGISTERIAL DISTRICT
FRANKLIN COUNTY, VIRGINIA

DATE: October 27, 2020

PREPARED FOR
RUNK & PRATT SENIOR LIVING COMMUNITIES

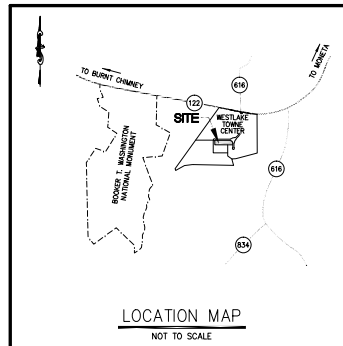

--INDEX OF DRAWINGS--
SHEET No. DESCRIPTION

1. LUMSDEN ASSOCIATES COVER SHEET
2. WATER & SEWER AS-BUILT DATA
3. WATER & SEWER AS-BUILT PLAN

AS-BUILT
AS-BUILT INFORMATION SHOWN ON
THIS PLAN IS THE RESULT OF A
FIELD SURVEY PERFORMED
BY LUMSDEN ASSOCIATES, P.C. OR
AS SUPPLIED BY FALWELL
CORPORATION (CONTRACTOR)
FIELD MARKUPS.



LUMSDEN ASSOCIATES, P.C.
ENGINEERS-SURVEYORS-PLANNERS

4664 BRAMBLETON AVENUE, SW
P.O. BOX 20669
ROANOKE, VIRGINIA 24018

PHONE: (540) 774-4411
FAX: (540) 772-9445
E-MAIL: MAIL@LUMSDENPC.COM



REVISIONS	
DATE	SHEETS
COMMISSION NO. 15-185	
SHEET 1 OF 3	