
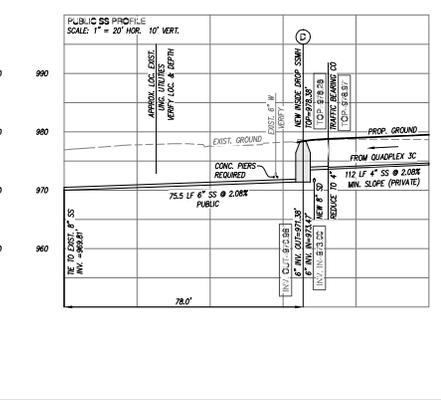
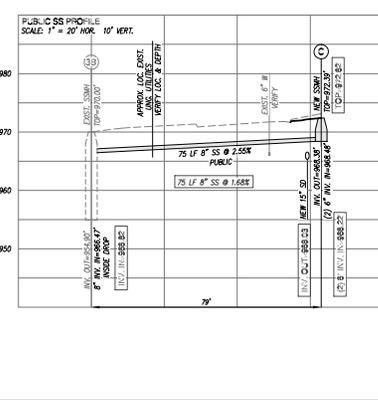
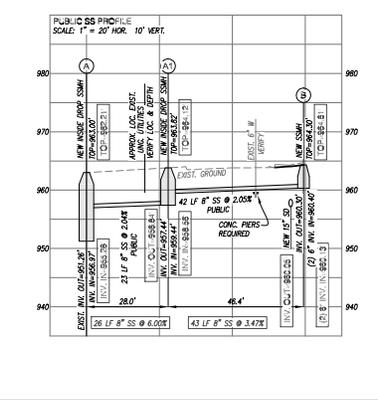


NOTE:  
CONTRACTOR AS-BUILT FIELD MARKUPS AS SUPPLIED BY FALLWELL CORPORATION INDICATED NO VERTICAL DEVIATIONS FROM THE ORIGINAL PLANS. SEE SHEET 2 FOR FIELD SURVEYED INDIVIDUAL WATERLINE & SANITARY SEWER APPURTENANCE ELEVATIONS.

**AS-BUILT**  
AS-BUILT INFORMATION SHOWN ON THIS PLAN IS THE RESULT OF A FIELD SURVEY PERFORMED BY LUMSDEN ASSOCIATES, P.C. OR AS SUPPLIED BY FALLWELL CORPORATION (CONTRACTOR) FIELD MARKUPS.

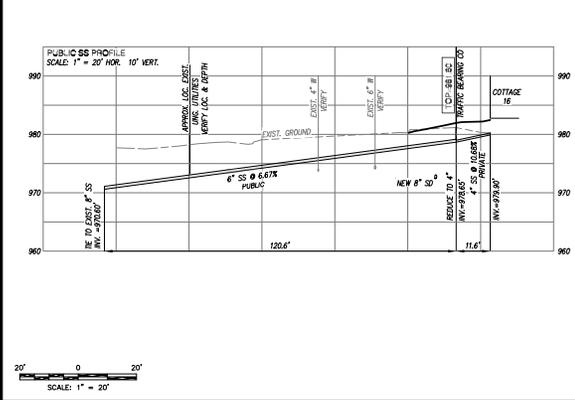

**LUMSDEN ASSOCIATES, P.C.**  
ENGINEERS-SURVEYORS-PLANNERS  
ROANOKE, VIRGINIA  
PHONE: 804-774-4411  
FAX: 804-774-4411  
466 BRIMBLETON AVENUE  
ROANOKE, VIRGINIA 24018  
E-MAIL: LUMS@LUMSDEN.COM

**STATE OF VIRGINIA**  
REGISTERED PROFESSIONAL ENGINEER  
ANDREW P. LUMSDEN  
Lic. No. 60228  
12/21/00

**WATER & SEWER PLAN**  
**AS-BUILT PLAN**

**AS-BUILT WATER AND SEWER PLAN**  
FOR  
**WESTLAKE ASSISTED LIVING**  
**NEW LOT 10 A COTTAGES**  
PREPARED FOR  
**RUNK & PRATT SENIOR LIVING COMMUNITIES**  
A COMMUNITY OF WESTLAKE

NO.	DATE	DESCRIPTION
1		
2		
3		
4		
5		

DATE: **OCTOBER 27, 2020**  
SCALE: 1" = 20'  
COMMISSION NO.: 15-185  
SHEET 3 OF 3