

ATTACHMENT "A"

WATERLINE AS-BUILT

FOR


WESTLAKE TOWNE CENTER

SITUATED IN

GILLS CREEK MAGISTERIAL DISTRICT

FRANKLIN COUNTY, VIRGINIA

DATE: 18 APRIL 2007

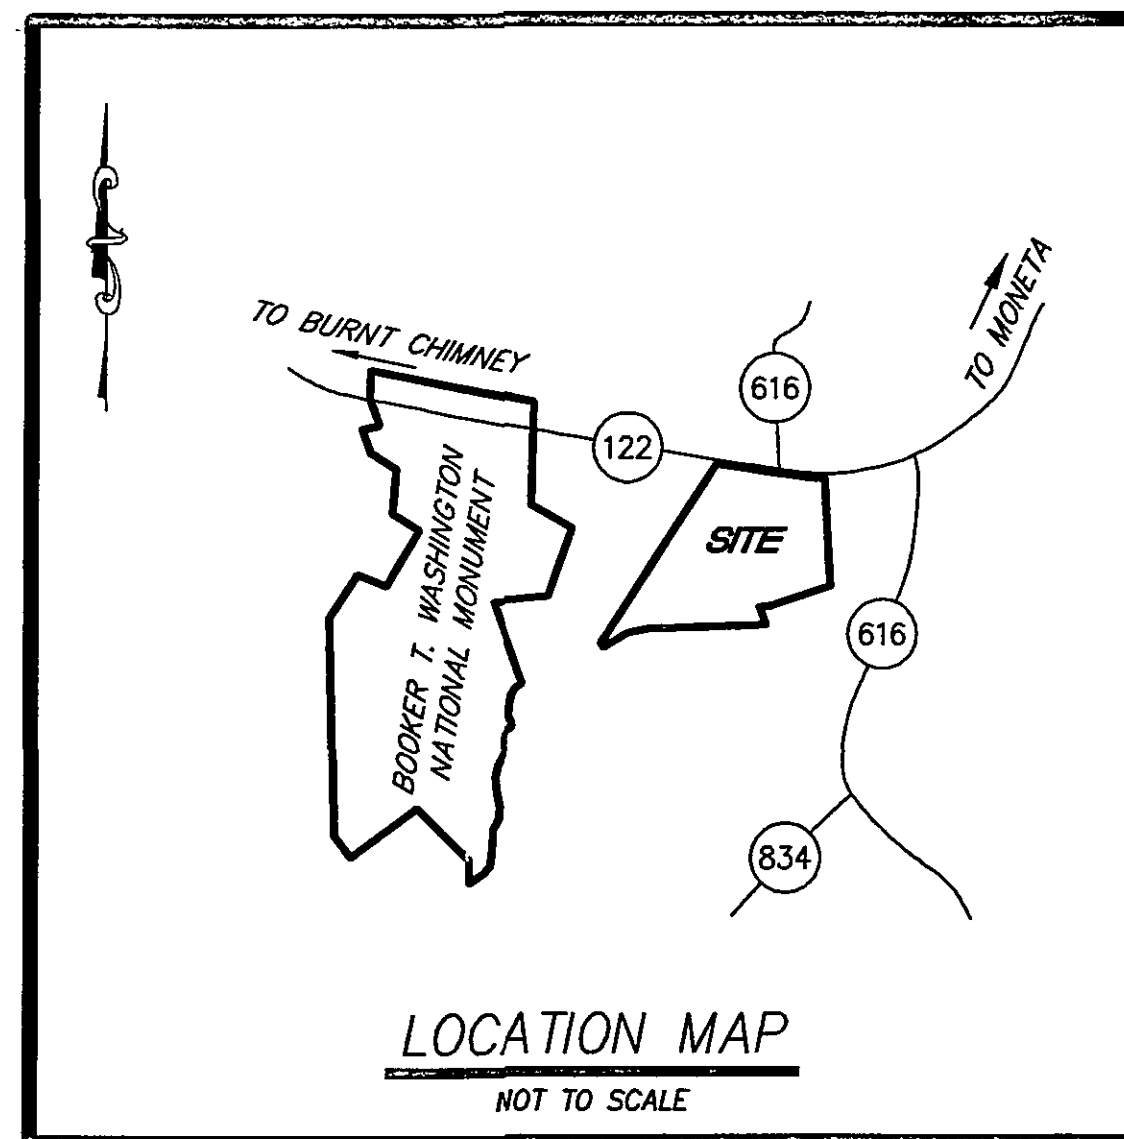

--INDEX OF DRAWINGS--

SHEET No.	DESCRIPTION
-----------	-------------

1. LUMSDEN ASSOCIATES COVER SHEET
2. COMPOSITE PLAT
- 2A. COMPOSITE PLAT
3. PHASE 2 - WESTLAKE TOWNE CENTER
4. KROGER AT WESTLAKE TOWNE CENTER
5. WENDY'S
6. RETAIL / OFFICE - TRACT 4
7. TRACTS 5 & 6
8. KROGER CENTER AT WESTLAKE
9. ASSISTED LIVING CENTER (PROPOSED)



LUMSDEN ASSOCIATES, P.C.
ENGINEERS-SURVEYORS-PLANNERS

4664 BRAMBLETON AVENUE, SW
P.O. BOX 20669
ROANOKE, VIRGINIA 24018

PHONE: (540) 774-4411
FAX: (540) 772-9445
E-MAIL: MAIL@LUMSDENPC.COM

REVISIONS	
DATE	SHEETS
4/18/07	ADDED SHEETS 2A & 9

COMMISSION NO: 00-050

SHEET 1 OF 9