


- NOTES:
1. THIS PLAT IS A COMPILATION OF DATUM PERTAINING TO WATERLINE AS INSTALLED THROUGHOUT THE WESTLAKE TOWNE CENTER PROJECT. THE INFORMATION SHOWN HEREON TAKEN FROM DEVELOPMENT PLANS, DATUM PROVIDED BY WILLARD CONSTRUCTION OF SMITH MOUNTAIN LAKE AND J.P. TURNER, INC.
 2. PROPERTY LINES AND TRACTS SHOWN HEREON TAKEN FROM EXISTING RECORDS AND DO NOT CONSTITUTE A BOUNDARY SURVEY.
 3. ADDITIONAL UTILITIES SHOWN HEREON I.E., STORM DRAIN, SEPTIC LINE DATUM NOT FIELD LOCATED AND SHOULD BE VERIFIED PRIOR TO ANY CONSTRUCTION.
 4. LEGAL REFERENCE: D.B. 766, PG. 1974-1976, D.B. 777, PG. 1855-1857, D.B. 876, PG. 813-814.

IMAC 1 /
D.B. 876 PG. 813-814

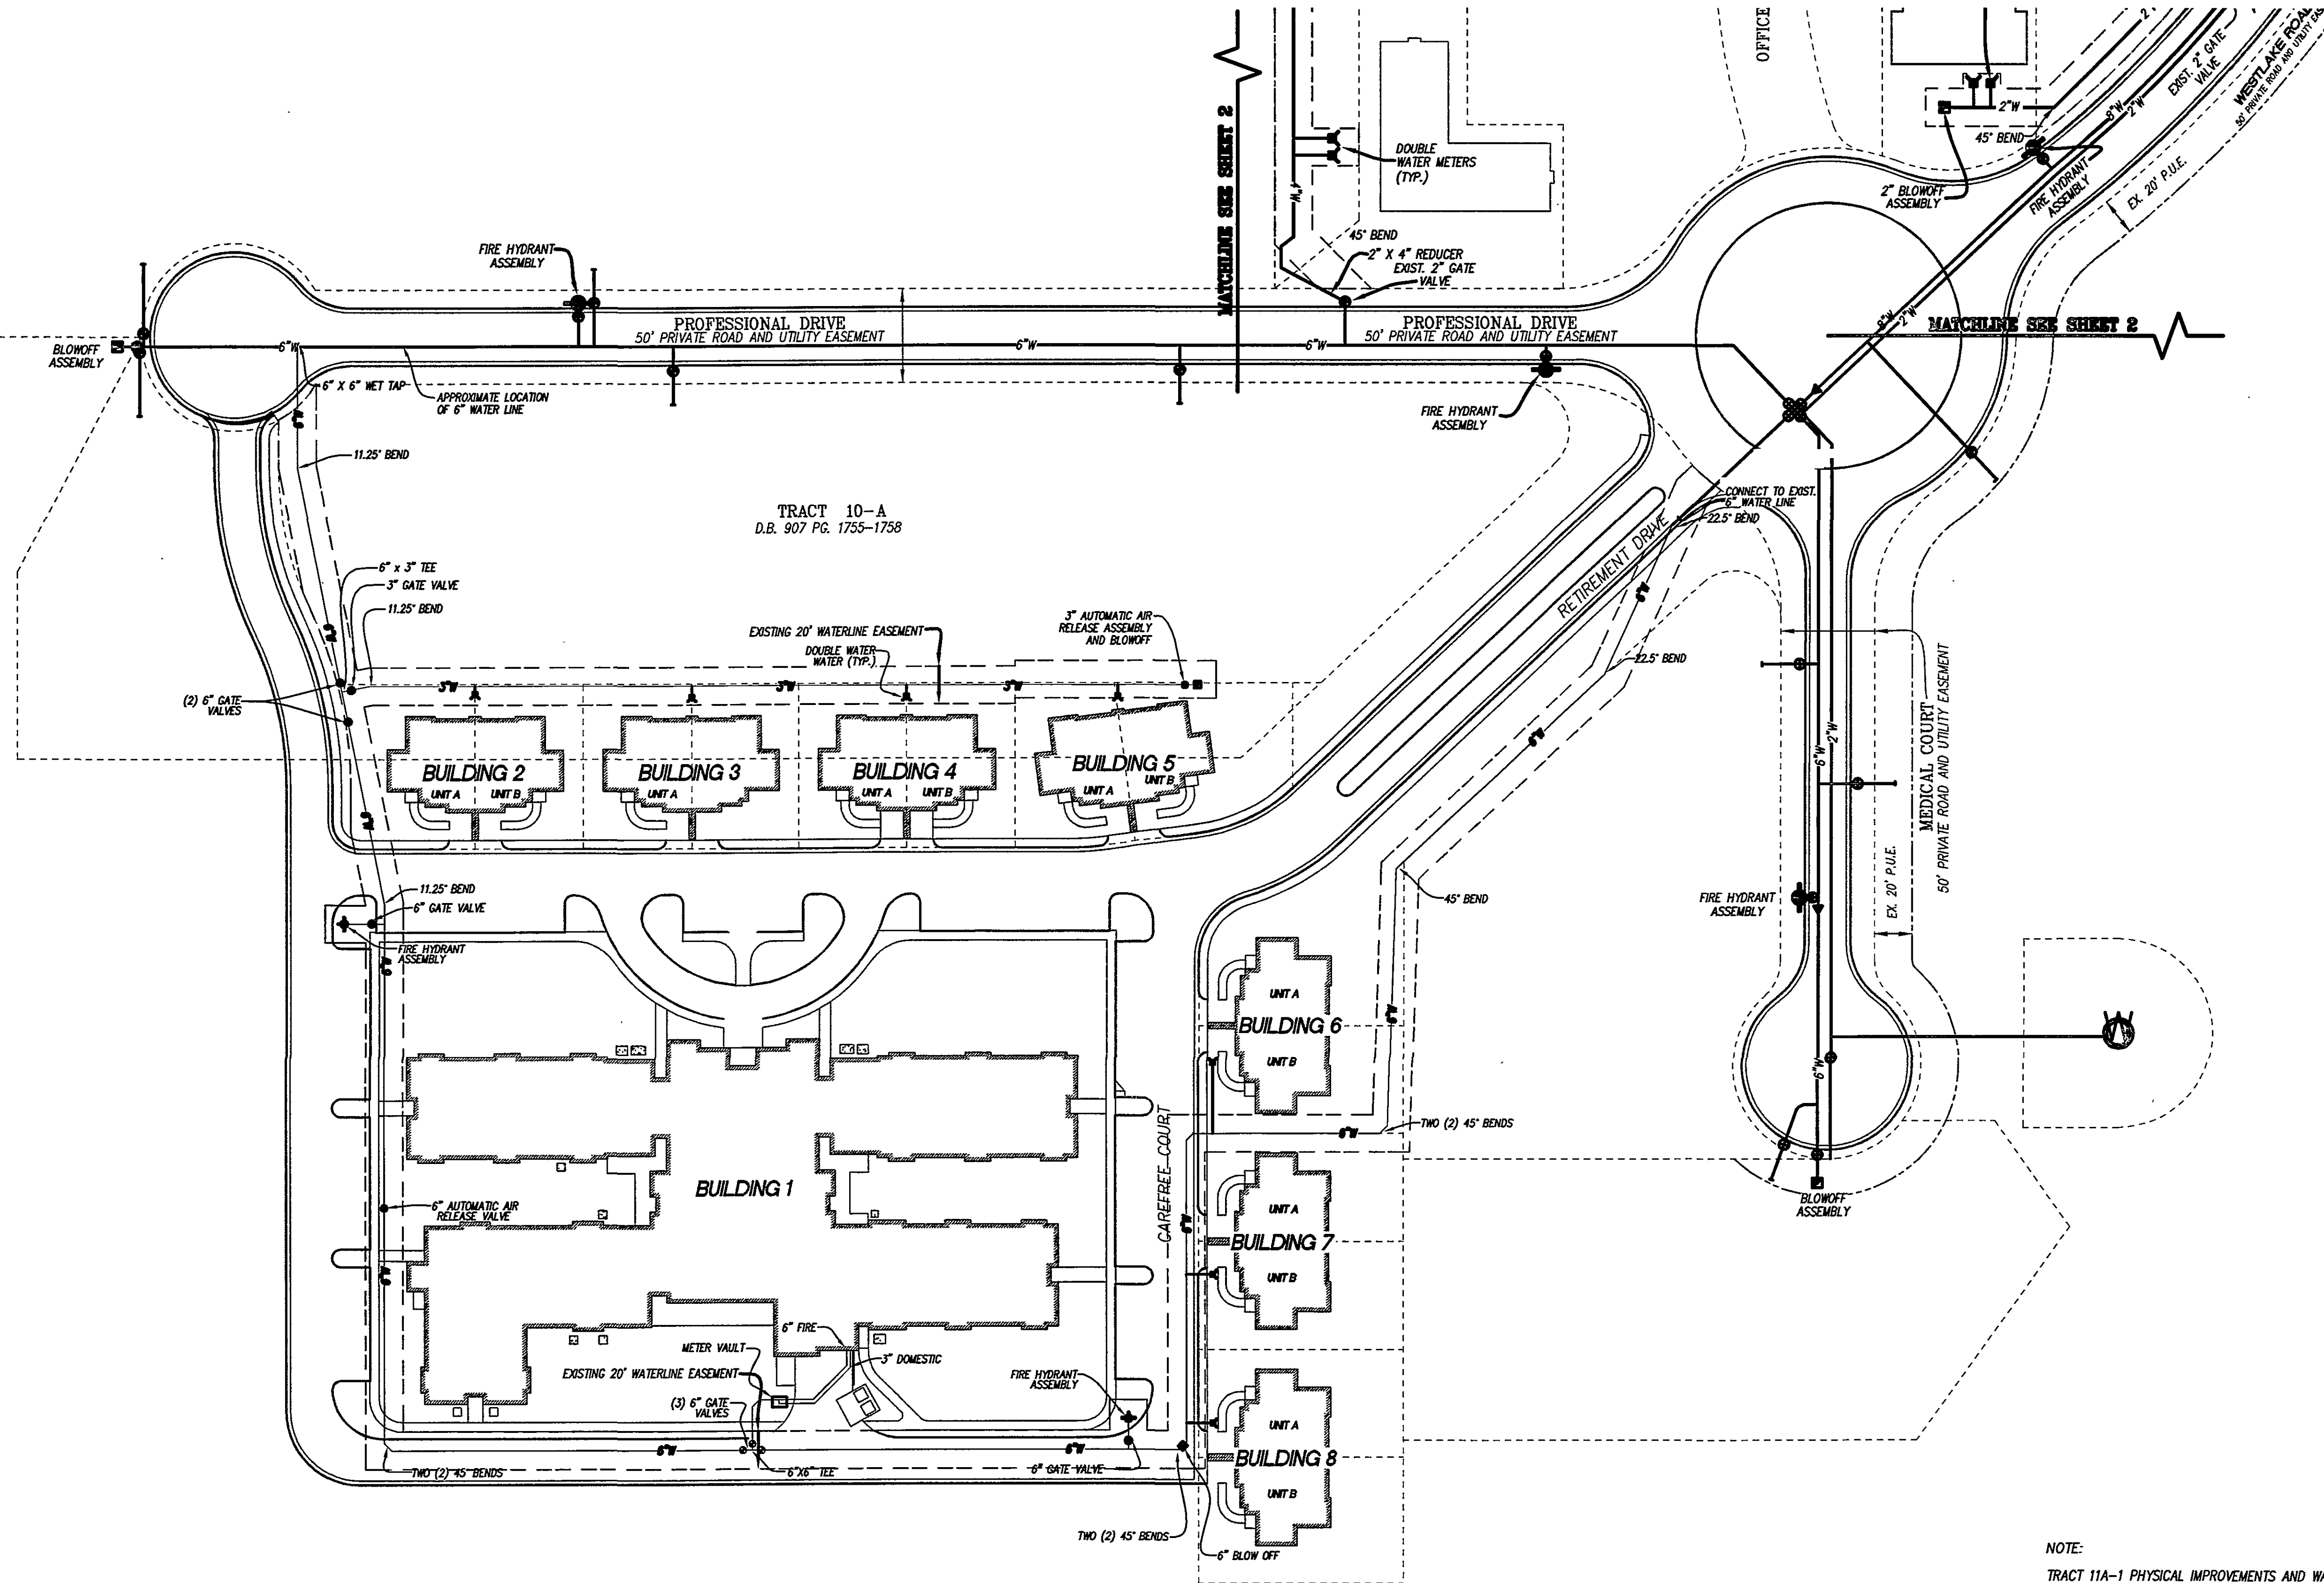

NOTE:
TRACT 11A-1 PHYSICAL IMPROVEMENTS AND WATERLINE AS SHOWN NOT
CONSTRUCTED AT THIS TIME AND IS BASED ON APPROVED SITE DEVELOPMENT
PLANS. SEE SHEET 9 OF 9 FOR DIMENSIONAL LAYOUT FROM APPROVED PLANS
SHOWN ABOVE.



LUMSDEN ASSOCIATES, P.C.
ENGINEERS-SURVEYORS-PLANNERS
ROANOKE, VIRGINIA

466 BRAVLETTON AVENUE
P.O. BOX 20669
ROANOKE, VIRGINIA 24018
PHONE (540) 774-4411
FAX (540) 772-9445
E-MAIL: MAL@LUMSDENPC.COM

COMPOSITE PLAT
SHOWING
WATERLINE AS-BUILT

WESTLAKE TOWNE CENTER
SITUATE ALONG WESTLAKE ROAD,
PROFESSIONAL DRIVE, BUILDERS PRIDE DRIVE
GILL'S CREEK MAGISTERIAL DISTRICT
FRANKLIN COUNTY, VIRGINIA

REVISIONS		DESCRIPTION
NO.	DATE	
1		
2		
3		
4		
5		
6		

DATE: April 18, 2007
SCALE: 1" = 50'
COMMISSION NO: 00-050
SHEET 2A OF 9