


WESTLAKE VILLAGE

BUSINESS PARK

PHASE I

WATER SYSTEM

FRANKLIN COUNTY, VIRGINIA

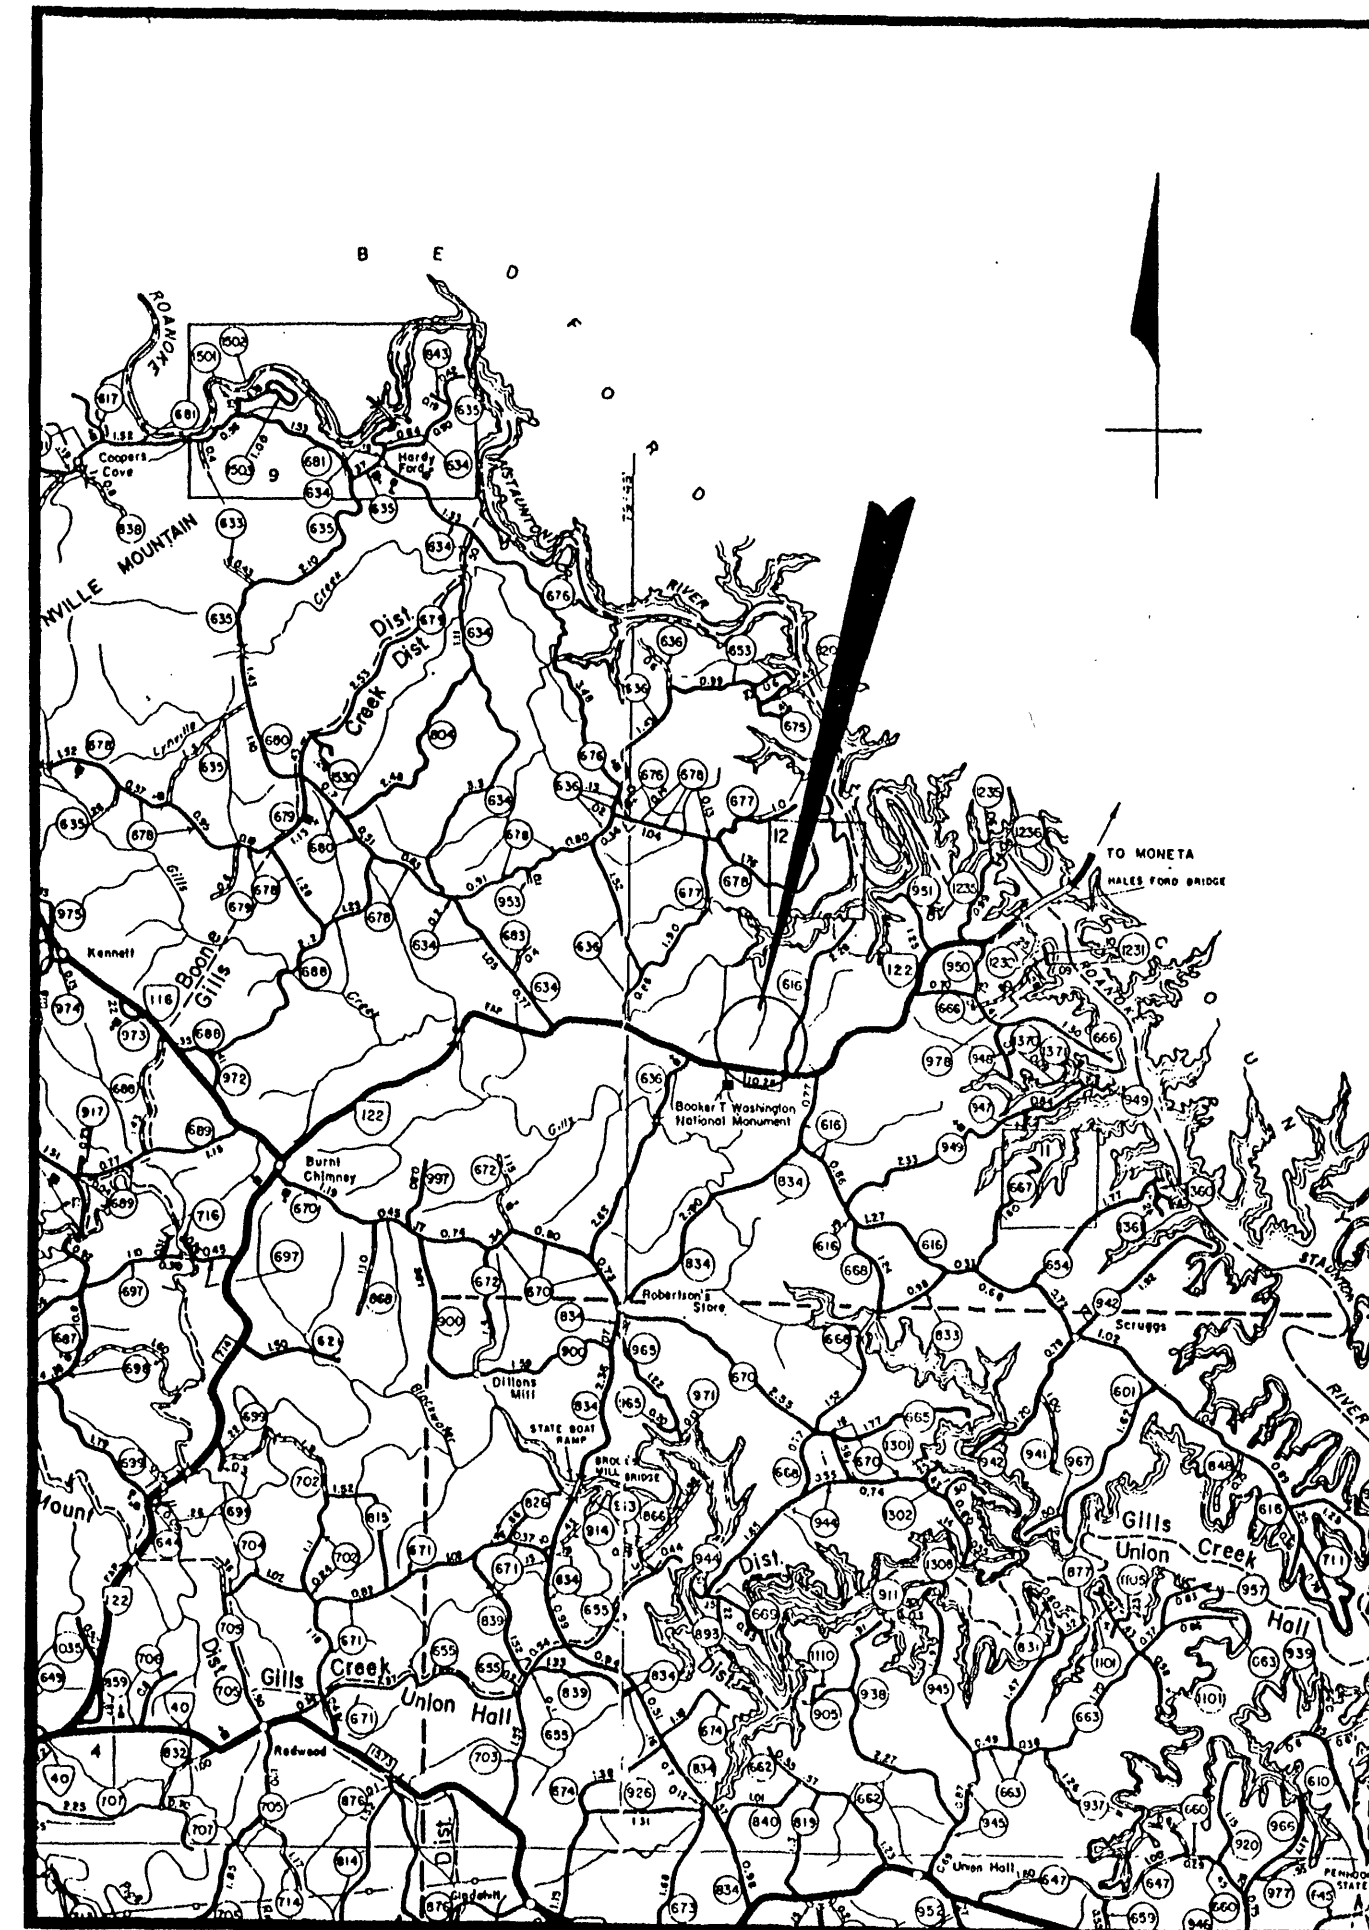


VICINITY MAP

General Waterline Notes


1. Plans and Specifications have been prepared in accordance with Franklin County Chapter 22 Water and Sewer Code.
2. Connection to County water main at intersection of Rt. 122 and Rt. 616 must be coordinated with County.
3. Valve boxes in traffic areas must be traffic bearing.

SHEET INDEX

- 1-COVER SHEET
- 2-PLAN & PROFILE
- 3-PLAN & PROFILE
- 4-PLAN & PROFILE
- 5-MASTER LAYOUT
- 6-DETAILS

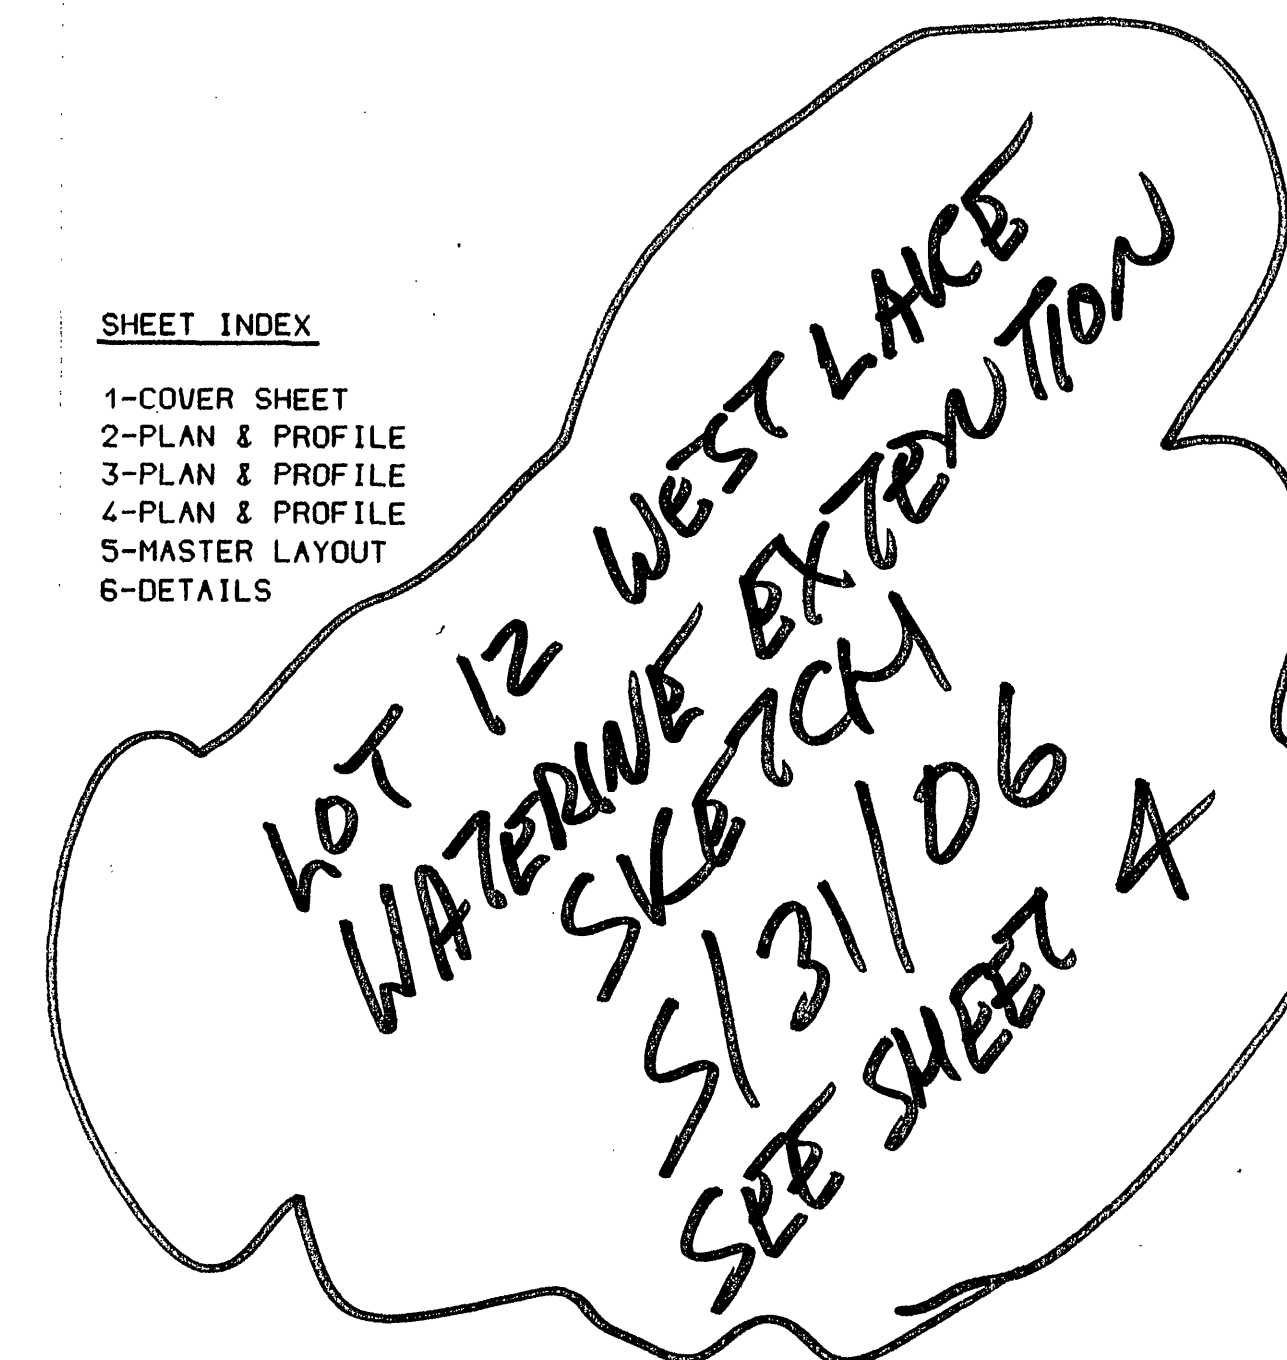

AS BUILT
7-26-05

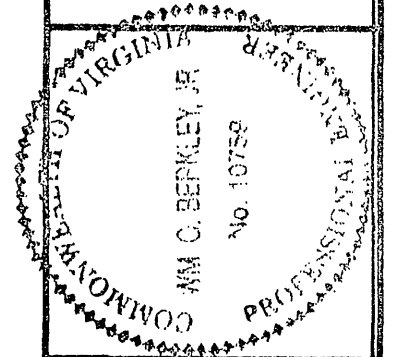

BERKLEY HOWELL & ASSOC., P.C.
ENGINEERS • SURVEYORS • PLANNERS
306 ENTERPRISE DRIVE, SUITE C
FOREST, VIRGINIA 24551
PH: (434) 385-7548 FAX: (434) 385-6178

WESTLAKE VILLAGE
BUSINESS PARK
PHASE I
WATER SYSTEM

GILLS CREEK DISTRICT FRANKLIN CO., VA.

DATE: 7-15-04	
TECHNICIAN:	
CHECKED BY:	
REVISIONS	
NO.	DATE
SCALES AS SHOWN	
PROJ. NO. 030066	DIV.
SHEET NO. 1 OF 6	
DRAWING NO.	

MANUSCRIPT DRAWING NUMBER: _____ VIEWS TO CREATE THIS DRAWING: _____ FIELDBOOK IDENTIFICATION: _____ SURVEY DATUM USED: _____