


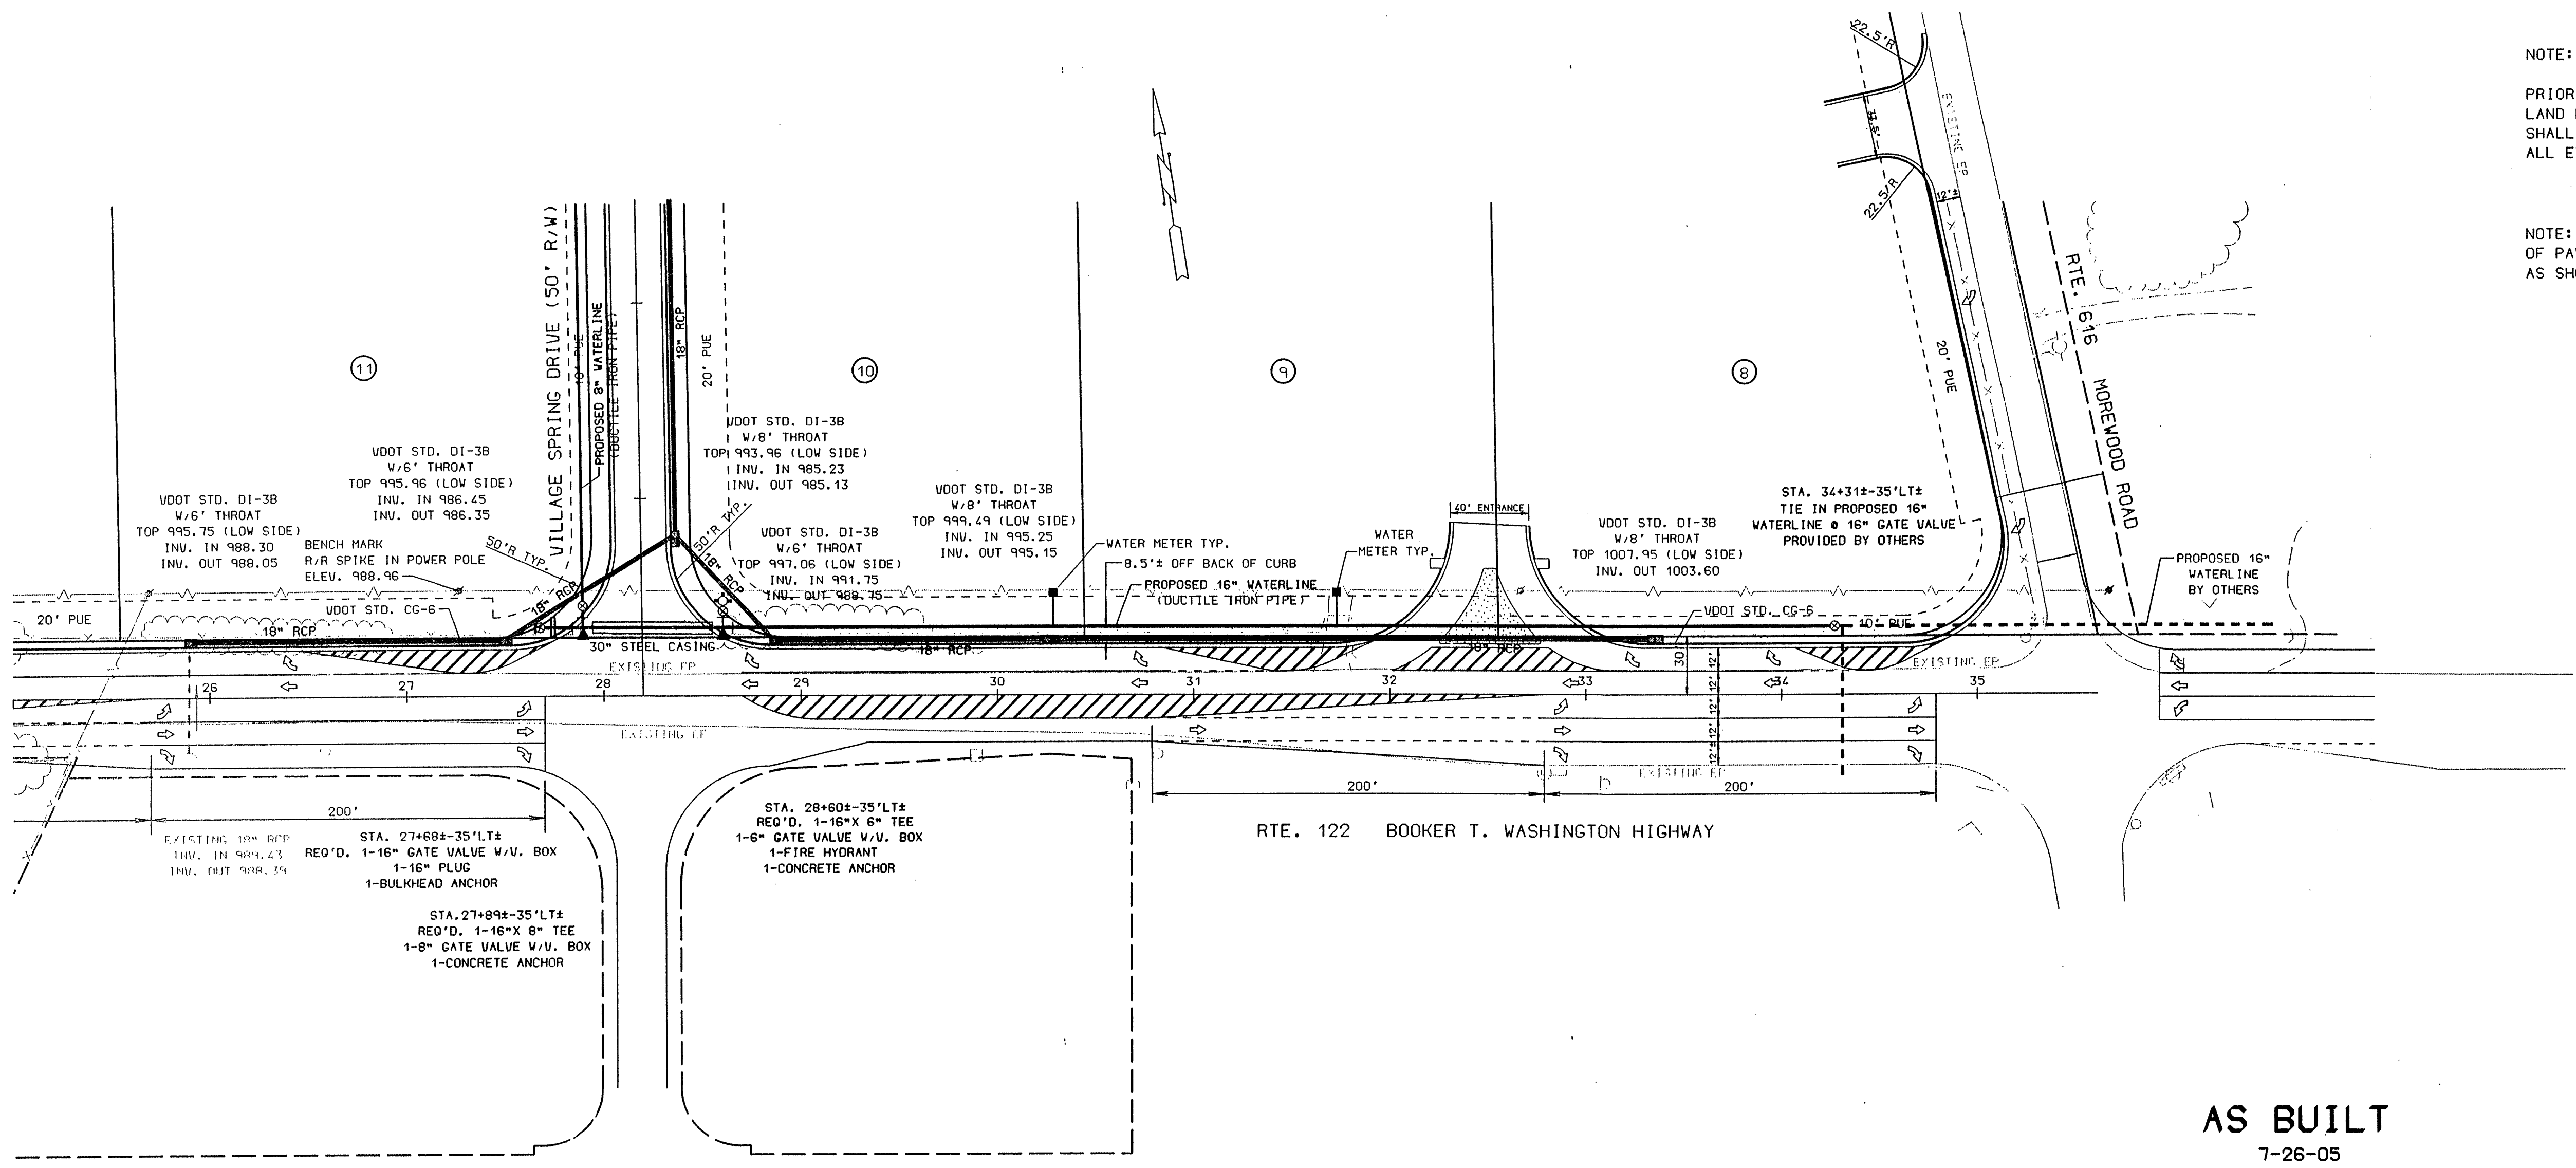


NOTE:  
PRIOR TO BEGINNING EXCAVATION OR ANY  
LAND DISTURBING ACTIVITY, THE CONTRACTOR  
SHALL CONTACT "MISS UTILITY" TO LOCATE  
ALL EXISTING UNDERGROUND UTILITIES.

NOTE: ALL AREAS OUTSIDE THE LIMITS  
OF PAVEMENT SHALL BE SEEDED AND MULCHED  
AS SHOWN ON DETAIL SHEET.

AS BUILT  
7-26-05

SCALE  
PLAN 1" = 50'  
PROFILE  
HORIZ 1" = 50'  
VERT 1" = 10'

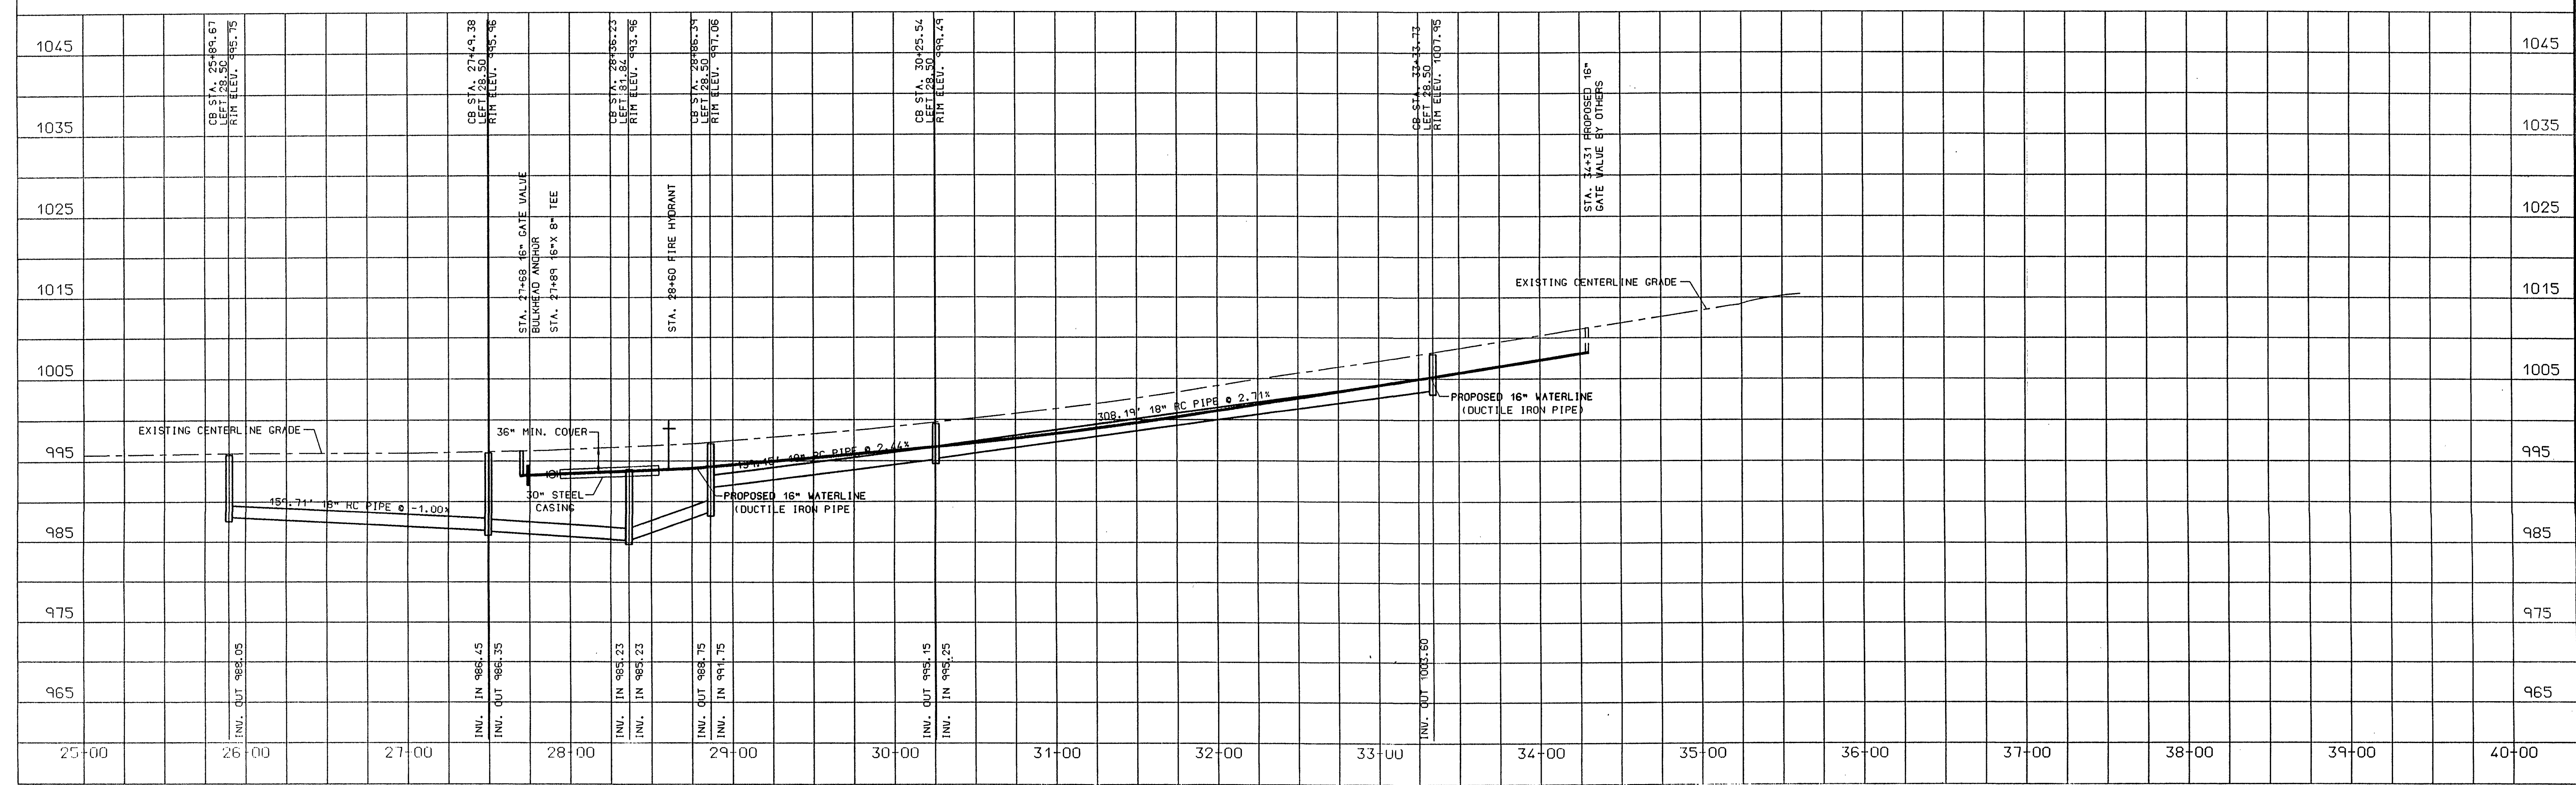

BERKLEY HOWELL & ASSOC., P.C.  
ENGINEERS • SURVEYORS • PLANNERS  
306 ENTERPRISE DRIVE, SUITE C  
FOREST, VIRGINIA 24551  
PH: (434) 385-7248 FAX: (434) 385-6178

WESTLAKE VILLAGE  
BUSINESS PARK  
PHASE I  
WATER SYSTEM

FRANKLIN CO., VA.  
GILLS CREEK DISTRICT

DATE: 7-15-04

TECHNICIAN:

CHECKED BY:

REVISIONS

NO. DATE

SCALES  
AS SHOWN

PROJ. NO. 030066 DIV.

SHEET NO. 2 OF 6

DRAWING NO. RTE1222

VIEWS TO CREATE THIS DRAWING: \_\_\_\_\_

MANUSCRIPT DRAWING NUMBER: \_\_\_\_\_

FIELDBOOK IDENTIFICATION: \_\_\_\_\_

SURVEY DATUM USED: \_\_\_\_\_