




AS BUILT  
7-26-05

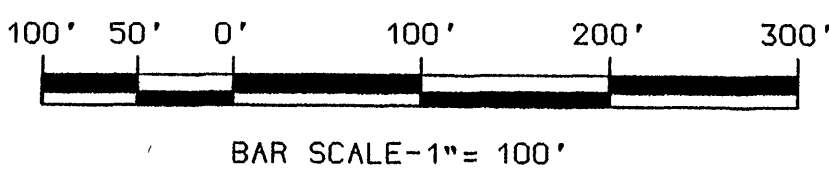

|                                                                                                                                                                        |  |                                                        |  |                                                                                                       |  |                               |  |                                             |  |
|------------------------------------------------------------------------------------------------------------------------------------------------------------------------|--|--------------------------------------------------------|--|-------------------------------------------------------------------------------------------------------|--|-------------------------------|--|---------------------------------------------|--|
| BERKLEY HOWELL & ASSOC., P.C.<br>ENGINEERS • SURVEYORS • PLANNERS<br>306 ENTERPRISE DRIVE, SUITE C<br>FOREST, VIRGINIA 24551<br>PH: (724) 385-7548 FAX: (724) 385-6178 |  |                                                        |  | WESTLAKE VILLAGE<br>BUSINESS PARK<br>PHASE I<br>WATER SYSTEM<br>GILLS CREEK DISTRICT FRANKLIN CO., VA |  | MASTER LAYOUT                 |  | DATE: 7-15-04<br>TECHNICIAN:<br>CHECKED BY: |  |
| PROJ. NO.<br>030066                                                                                                                                                    |  | DIV.<br>SHEET NO.<br>5 OF 6<br>DRAWING NO.<br>DILAYOUT |  | REVISIONS                                                                                             |  | NO.                           |  | DATE                                        |  |
| SCALES<br>AS SHOWN                                                                                                                                                     |  | MANUSCRIPT DRAWING NUMBER:                             |  | FIELDBOOK IDENTIFICATION:                                                                             |  | VIEWS TO CREATE THIS DRAWING: |  | SURVEY DATUM USED:                          |  |