

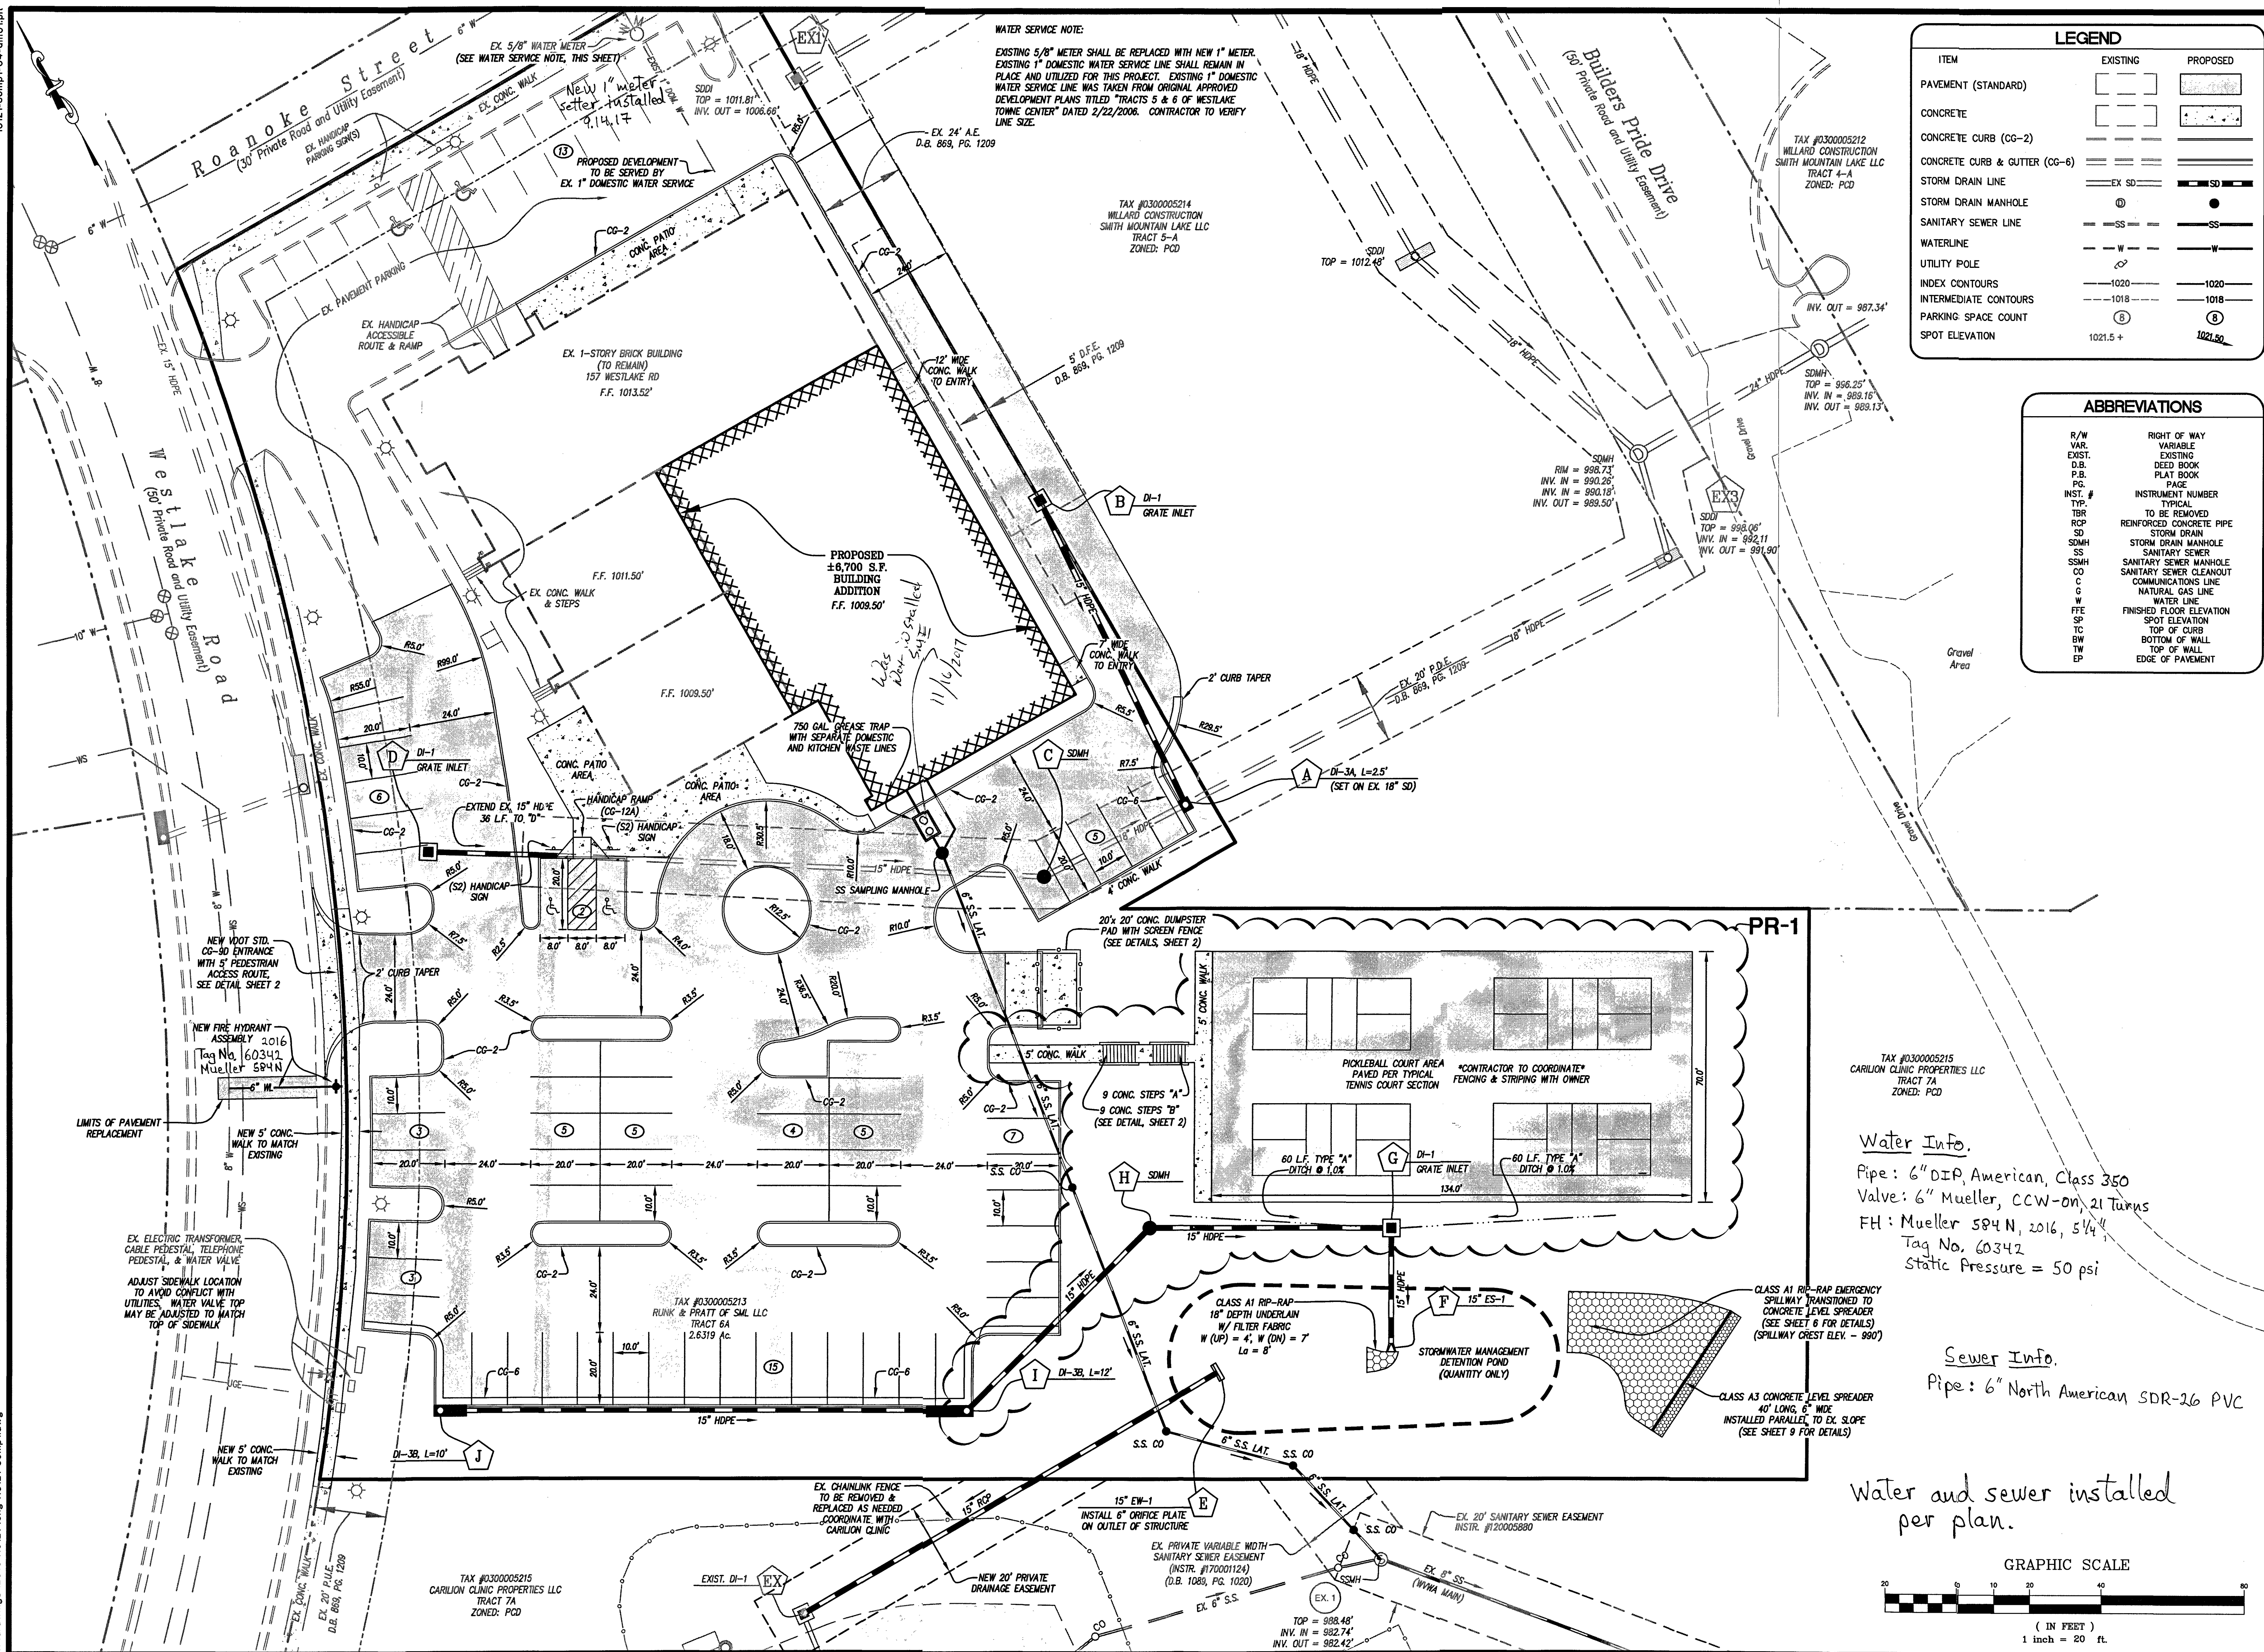


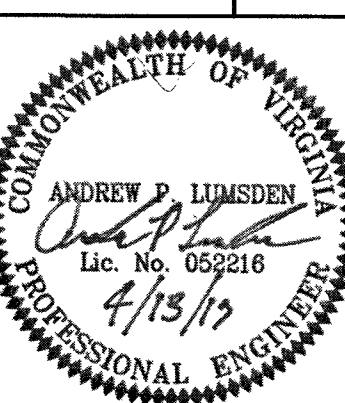

LUMSDEN ASSOCIATES, P.C.
ENGINEERS-SURVEYORS-PLANNERS
ROANOKE, VIRGINIA

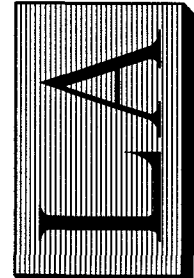

DIMENSIONAL LAYOUT

DEVELOPMENT PLAN
FOR
WESTLAKE WELLNESS CENTER
BUILDING ADDITION
PREPARED FOR
RUNK & PRATT OF SML, LLC
SITUATED ALONG CARBEE COURT
FRANKLIN COUNTY, VIRGINIA

REVISIONS		DESCRIPTION
NO.	DATE	DESCRIPTION
1	4/13/17	CHANGES ASSOCIATED WITH THE GRADING OF THE SURFACE ELEVATION OF THE PARCELS AND THE PARCELS.
2		
3		
4		
5		
6		

DATE: March 15, 2017
SCALE: 1" = 20'
COMMISSION NO.: 16-121
SHEET 4 OF 10

As-Built 10.18.17 K. Winslow