




- 17 SEPTICS
- 3 OVERFLOWS
- 2 GREASE PITS
- 9 PUMP STATIONS
- ⊗ 4 EXTRA 2" LINES FOR S/FORCED MAINS CAPPED OFF

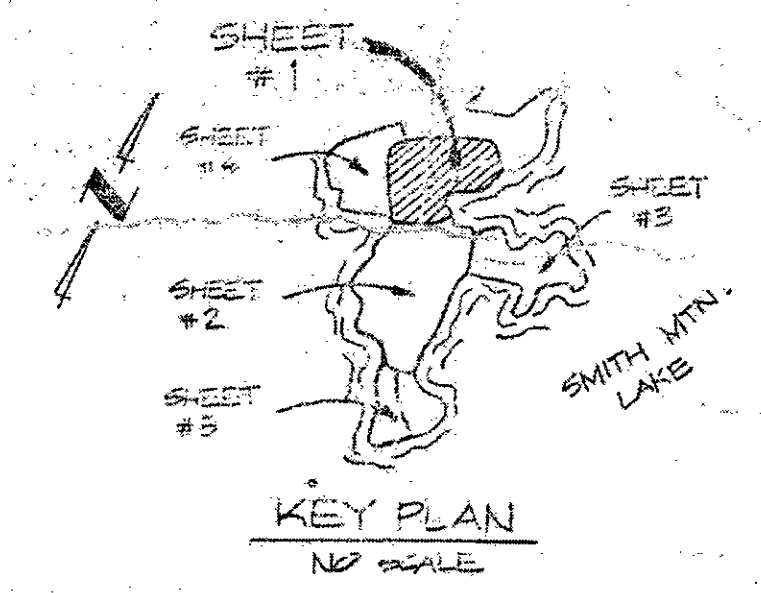

NOTE: SEE COVER SHEET FOR GENERAL NOTES AND LEGEND.

**UTILITY
AS BUILT
SITE PLANS
OF
BERNARD'S LANDING**
 GILLS CREEK MAGISTERIAL DISTRICT
 FRANKLIN COUNTY, VIRGINIA

SCALE: 1" = 50' DATE: 20 JANUARY 1987

BUFORD T. LUMSDEN & ASSOCIATES, P.C.
 CERTIFIED LAND SURVEYORS
 ROANOKE VIRGINIA

Note:
 11/8/2021 added
 extra information.
 (Street Names, Tax #s)