

SMITH MOUNTAIN LAKE

21 SEPTICS
1 OVERFLOW
5 PUMP STATIONS


"THE PENINSULA"

PENINSULA

DRIVE

SMITH MOUNTAIN LAKE

SMITH MOUNTAIN LAKE

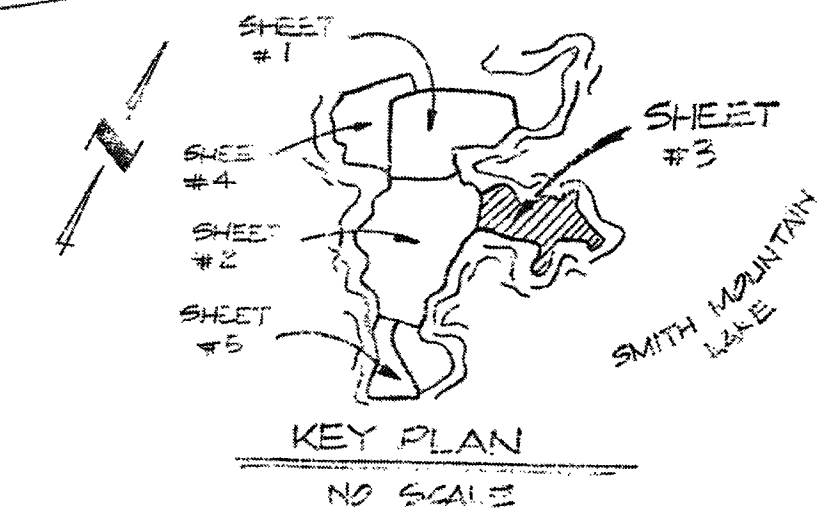

NOTE: SEE COVER SHEET FOR GENERAL NOTES AND LEGEND.

UTILITY
AS BUILT
SITE PLANS
OF
BERNARD'S LANDING

GILLS CREEK MAGISTERIAL DISTRICT
FRANKLIN COUNTY, VIRGINIA

SCALE: 1" = 50' DATE: 30 JANUARY 1987

BUFORD T. LUMSDEN & ASSOCIATES, P.C.
CERTIFIED LAND SURVEYORS
ROANOKE, VIRGINIA

Notes:
11/18/2021 added
extra information
(Street Names, Tax#s)

COMMA # 21-13

SHEET # 3 OF 5