
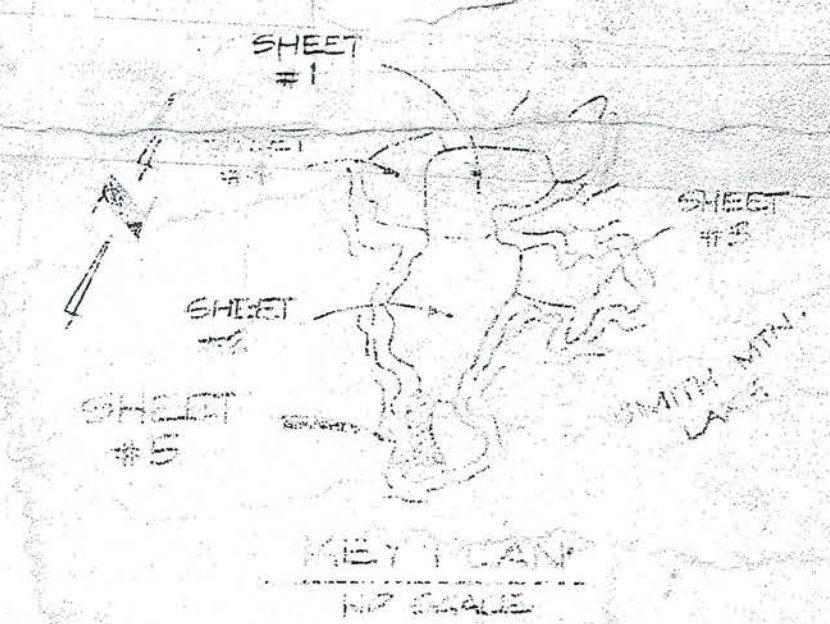


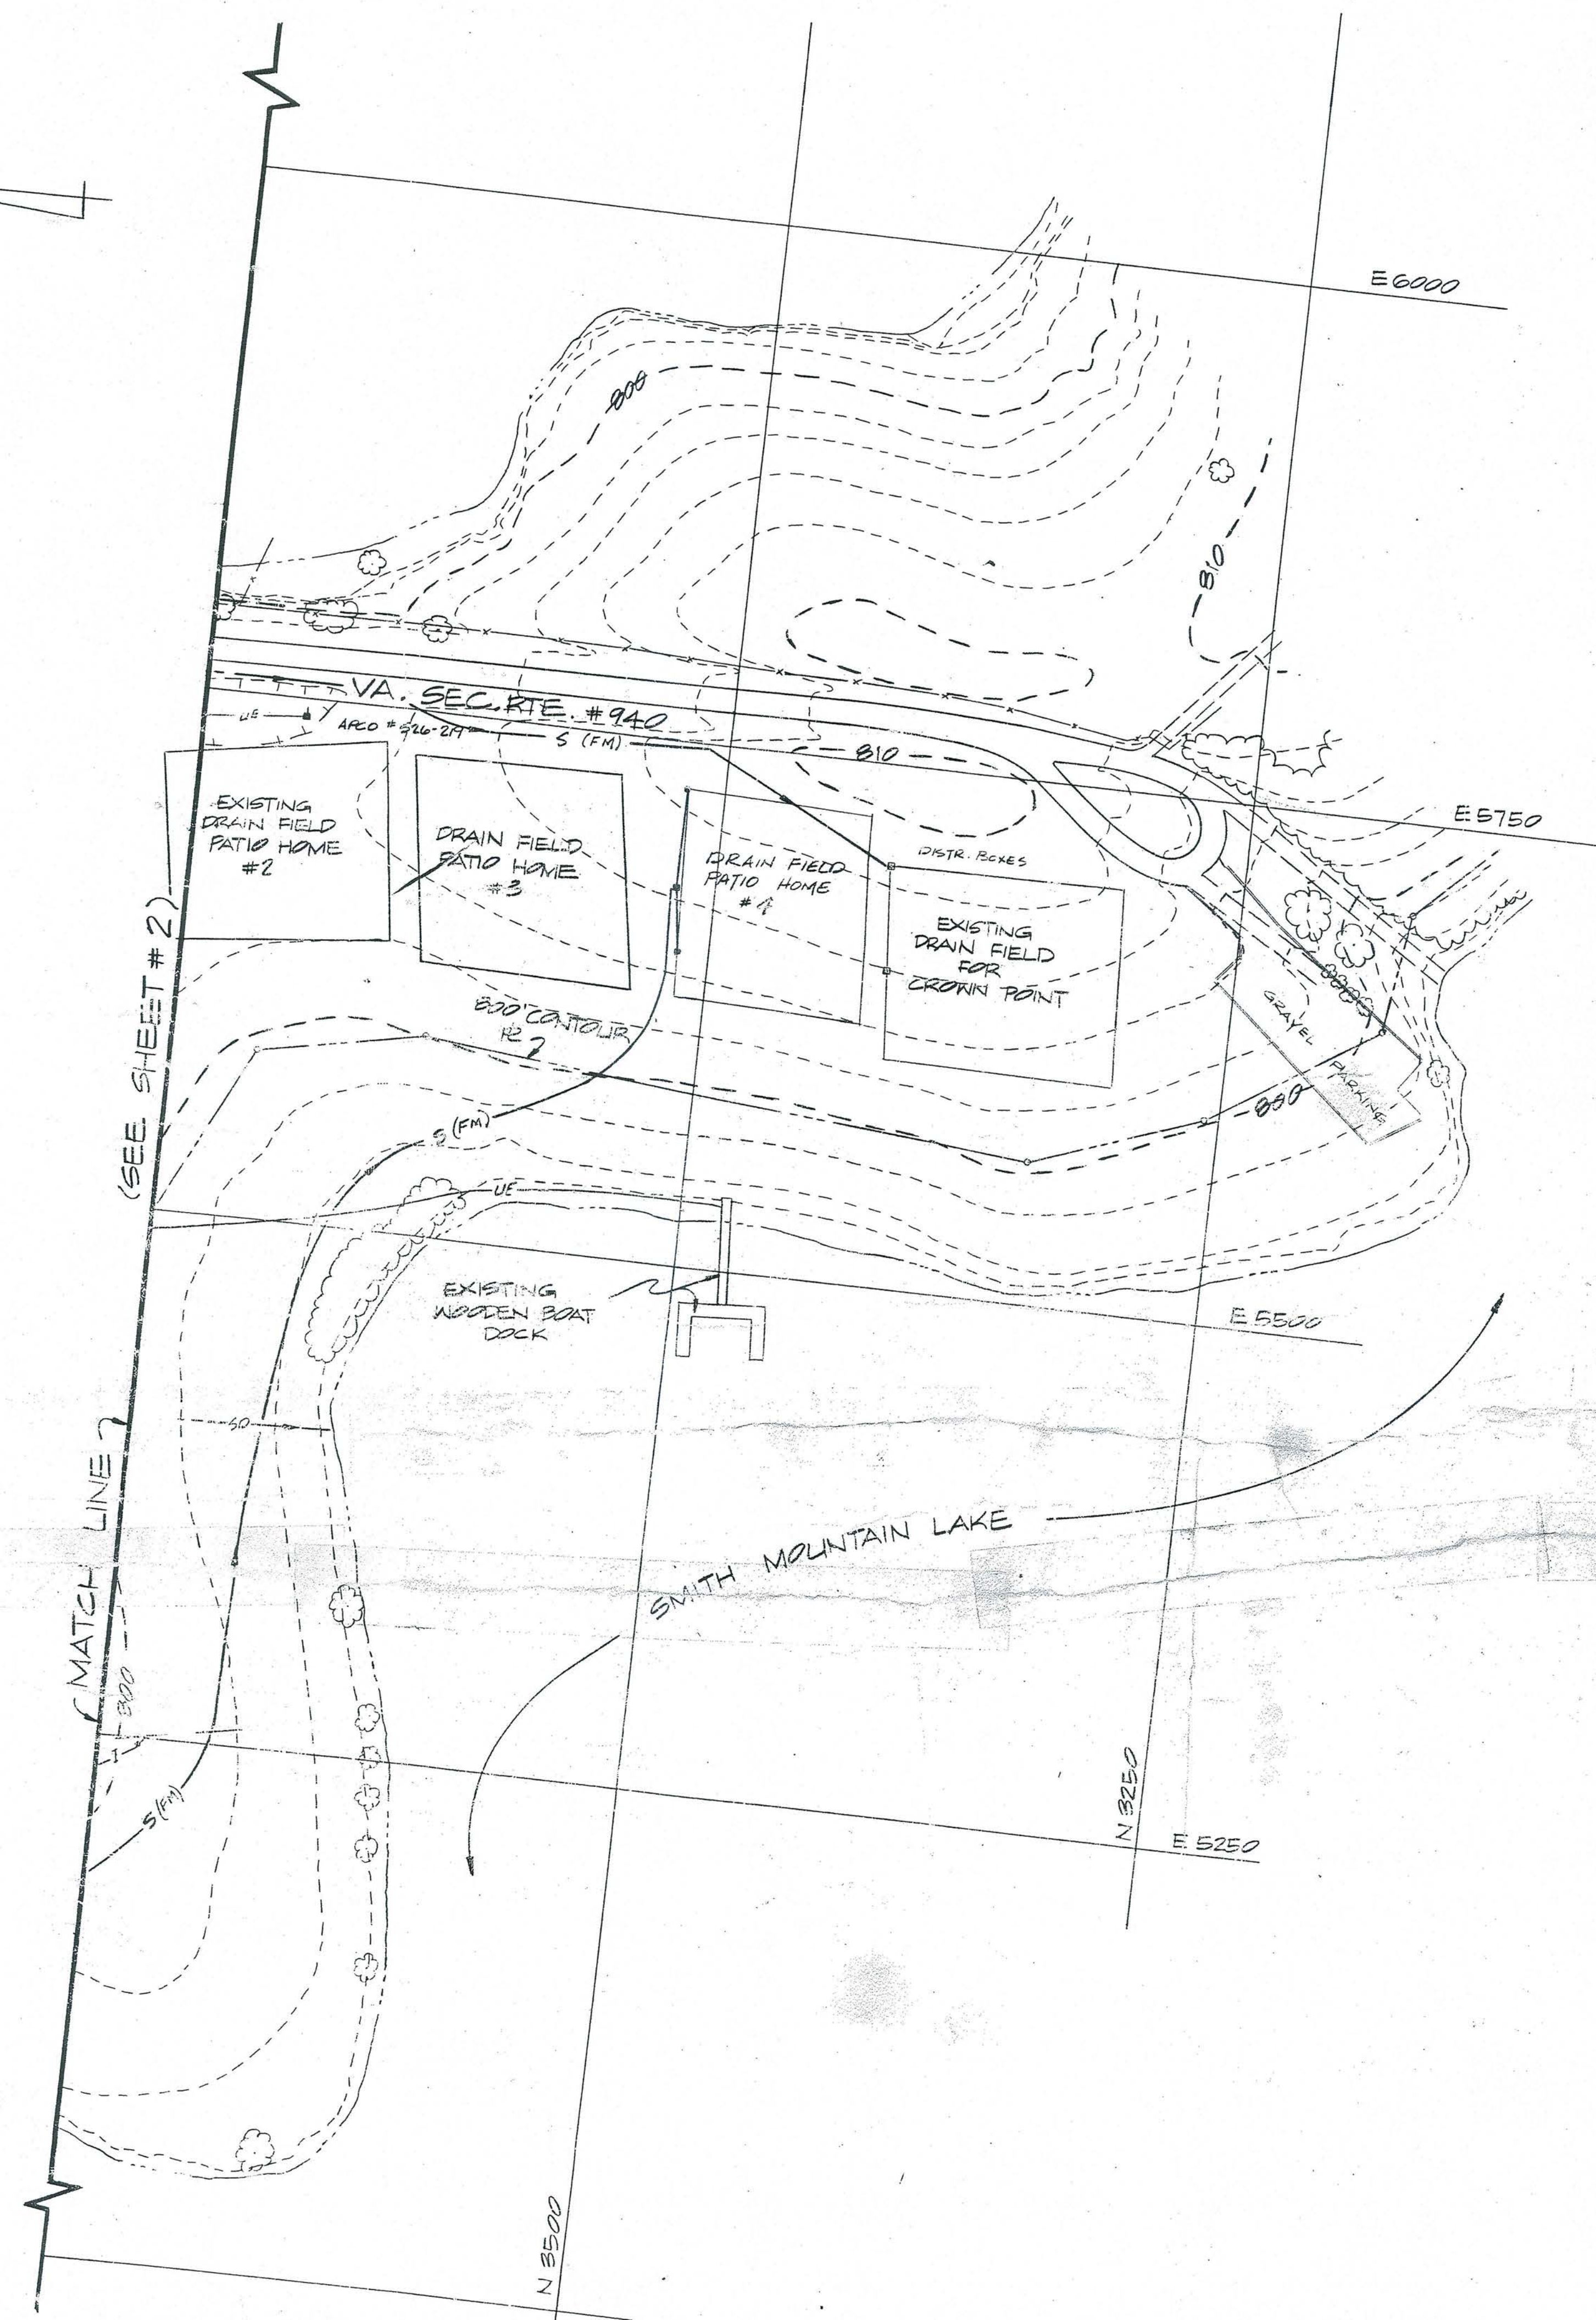

NOTE: SEE COVER SHEET FOR GENERAL NOTES AND LEGEND.

**UTILITY  
AS BUILT  
SITE PLANS**

OF  
**BERNARD'S LANDING**

GILLS CREEK MAGISTERIAL DISTRICT  
FRANKLIN COUNTY, VIRGINIA

SCALE: 1" = 50' DATE: 30 JANUARY 1986

BUFORD T. LUNDEN & ASSOCIATES, P.C.  
CERTIFIED LAND SURVEYORS  
ROANOKE, VIRGINIA

COMM# 81-15