


Bluewater Dr. Project As-Built 10.1.15 Substantial Completion

K. Winslow

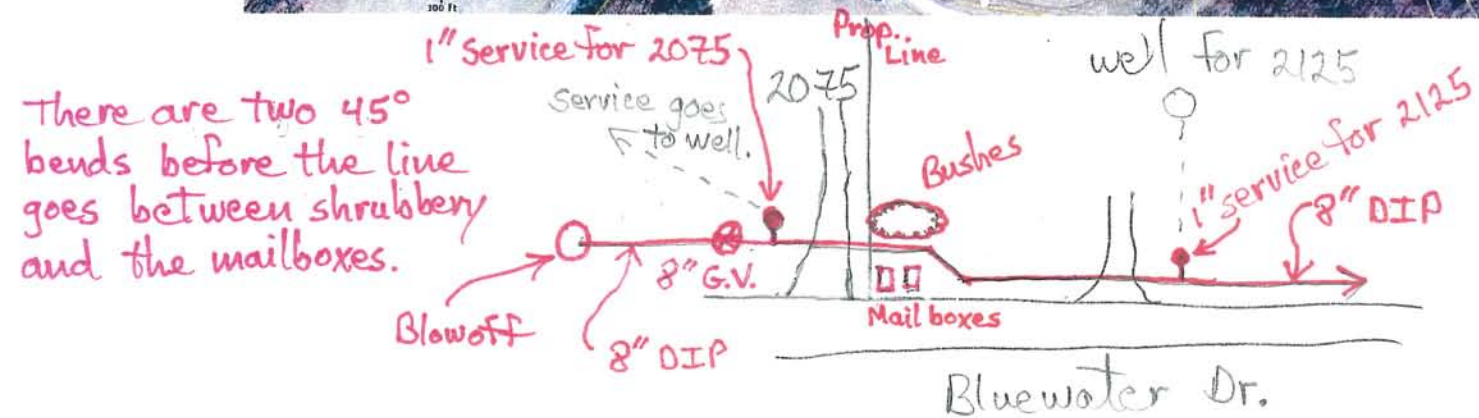

Pipe = U.S. Pipe 8" DIP
Valve = 8" American Flow Control (AFC)

ARV is located
511.5' from exist.
8" Gate Valve near
Scruggs Rd.

140' from B/O back toward Scruggs Rd. is restrained by locking gaskets.