


WEST LAKE
BREWERY
SUNSHINE CITY

DATE: AUGUST 15, 2012


PREPARED FOR
WILLARD CONSTRUCTION
OF SMITH MOUNTAIN LAKE, LLC

DEPARTMENT OF PLANNING AND COMMUNITY DEVELOPMENT
1255 FRANKLIN STREET, SUITE 103 PHONE: (540) 483-3027
ROCKY MOUNT, VIRGINIA 24151 FAX: (540) 483-3041

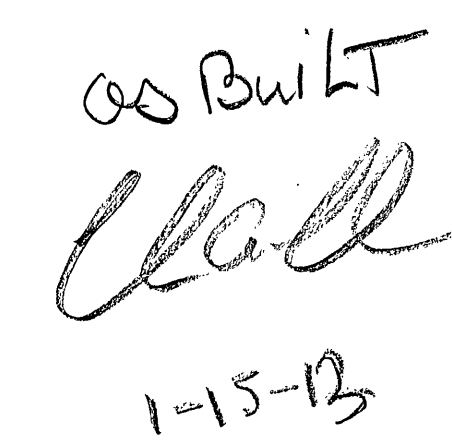

SHEET No.	DESCRIPTION
-----------	-------------


1. LUMSDEN ASSOCIATES COVER SHEET
2. FRANKLIN COUNTY STANDARD COVER SHEET
3. NOTES & DETAILS
4. EXISTING CONDITIONS & DEMOLITION PLAN
5. DIMENSIONAL LAYOUT
6. GRADING PLAN
7. STORM DRAIN PROFILES, NOTES AND DETAILS
8. WATER & SEWER DETAILS AND WATER PROFILE
9. EROSION AND SEDIMENT CONTROL PLAN
10. EROSION AND SEDIMENT CONTROL PLAN FOR OFFSITE
GRAVING AREA
11. EROSION AND SEDIMENT CONTROL NOTES AND DETAILS
12. LANDSCAPE PLAN
13. SIGN PLAN
14. EXTERIOR LIGHTING PLAN

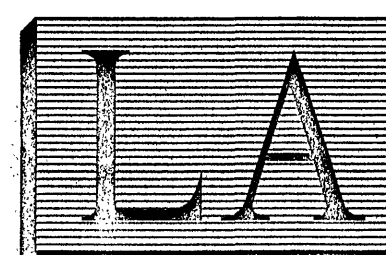

LUMSDEN ASSOCIATES, P.C.
ENGINEERS-SURVEYORS-PLANNERS

4664 BRAMBLETON AVENUE, SW
P.O. BOX 20669
ROANOKE, VIRGINIA 24018

PHONE: (540) 774-4411
FAX: (540) 772-9445
E-MAIL: MAIL@LUMSDENPC.COM

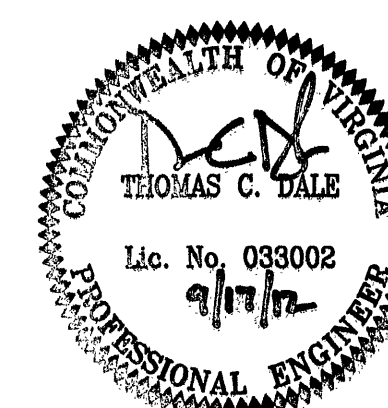

REVISIONS	
DATE	SHEETS
8/21/12	5, 6, & 8
9/17/12	5, 6, 9, 10 & 11
COMMISSION NO: 11-021	
SHEET 1 OF 14	