



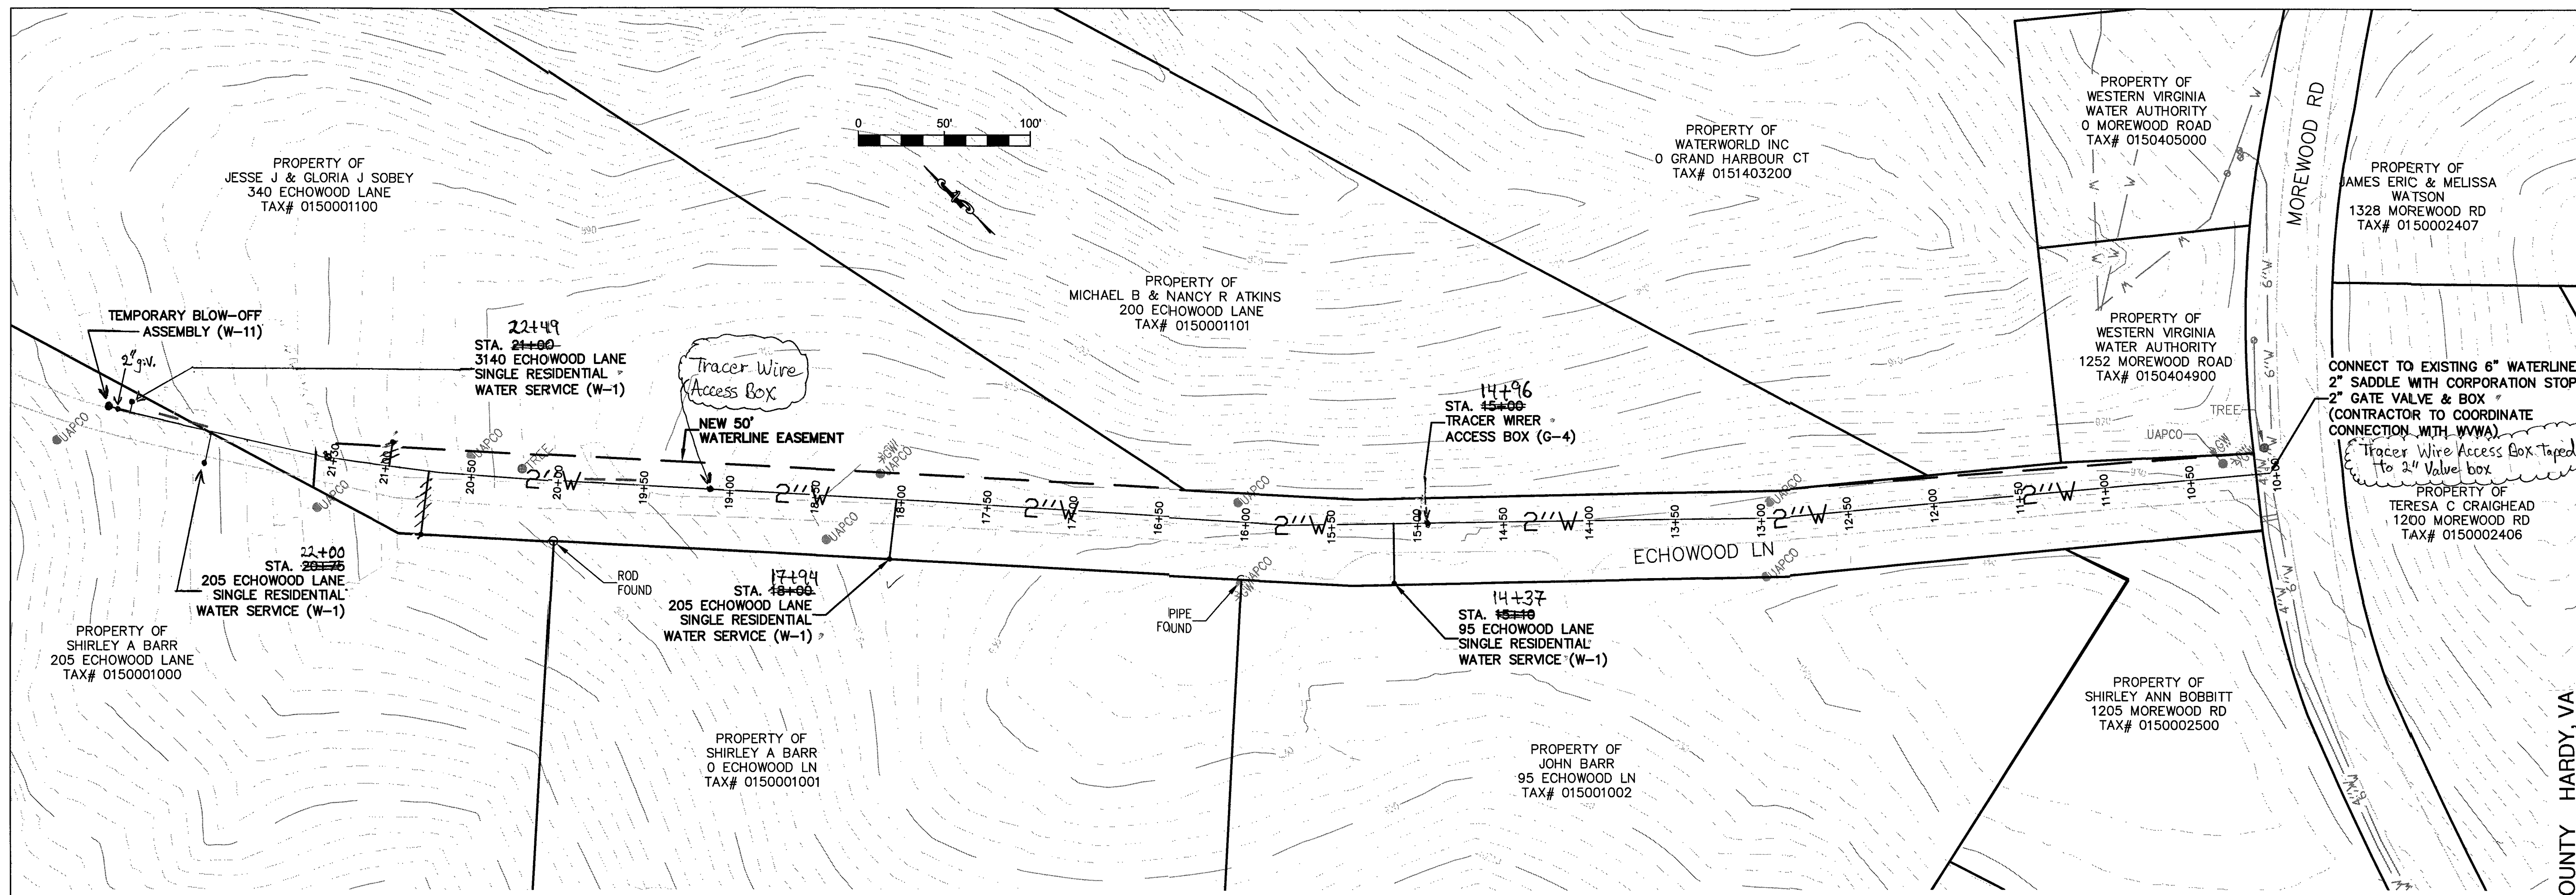

WATER INFO

Pipe: 2" Endot HDPE, SDR-9
Services: 1" Endot HDPE SDR-9, sleeved inside gray 2" sch. 80 plastic pipe
Valves: 2" Mueller valves, 9 turns - CCW on

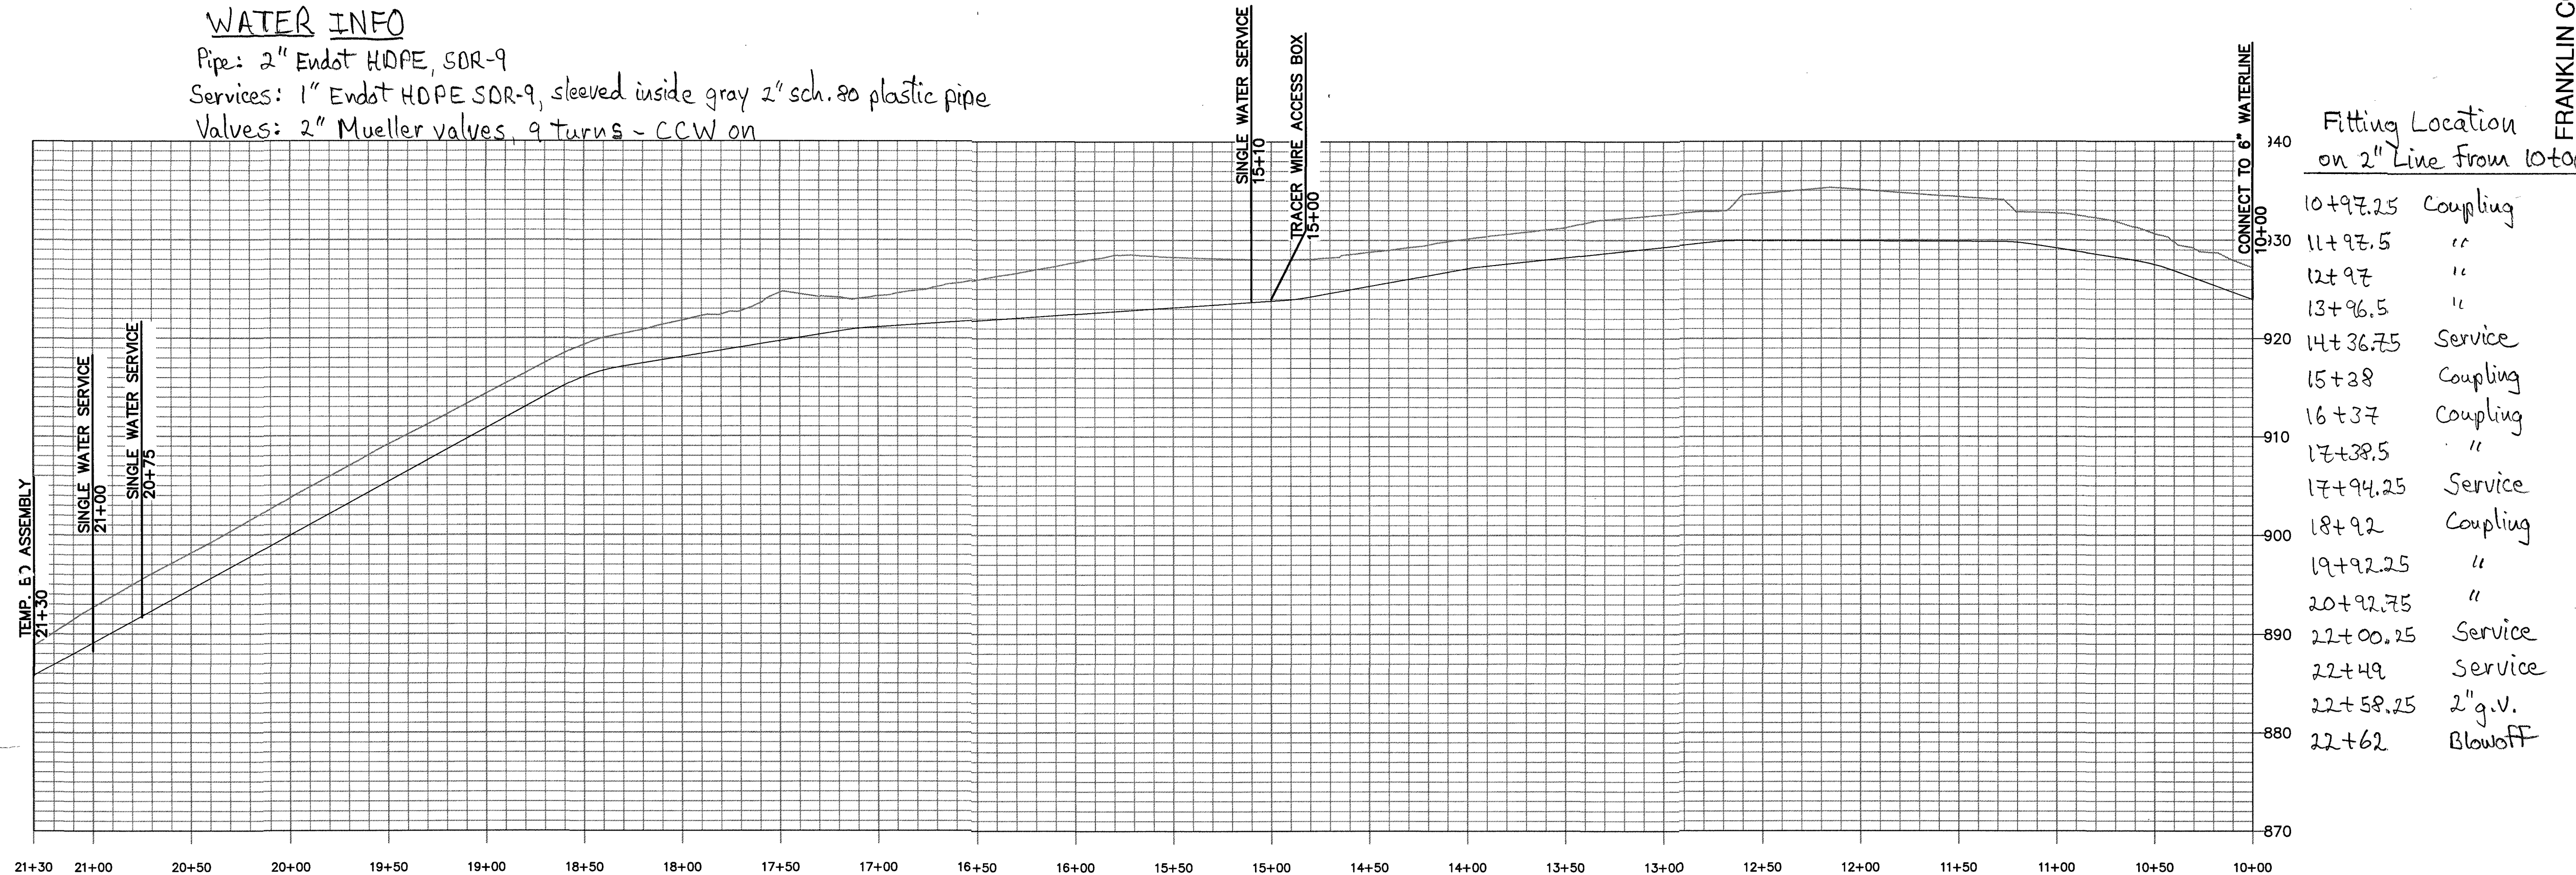

WATERLINE "A"
SCALE
VERTICAL: 1" = 10'
HORIZONTAL: 1" = 10'

WESTERN VIRGINIA
WATER AUTHORITY
ENGINEERING SERVICES
601 S JEFFERSON ST, SUITE 300
ROANOKE, VA 24011
540-853-5700

STATE OF VIRGINIA
NICHOLAS ROBERTSON
Lic. No. 0402052204
PROFESSIONAL ENGINEER

FRANKLIN COUNTY HARDY, VA

ECHWOOD / WATER

PLAN & PROFILE

Rev	Description	Date	By

Designed: AAS
Drawn: AAS
Checked: DRJ
Approved:
Date: 7/24/17
Project:

1
Sheet 1 of 1

As-Built Substantial Completion 10.11.17 K.Winslow