
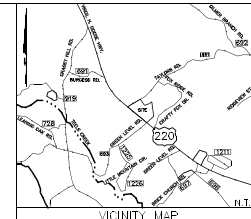


1. THIS WATERLINE ASBUILT HAS BEEN PREPARED FROM AN ACTUAL FIELD SURVEY AND IS SOLELY INTENDED TO BE USED TO SHOW GEOGRAPHIC LOCATIONS OF WATER UTILITY FEATURES. THIS MAP SHOULD NOT BE USED FOR AN OTHER PURPOSE.

LINE	BEARING	DISTANCE
L1	N 47°04'44" W	11.51'
L2	N 49°23'43" W	74.91'
L3	S 55°39'03" E	30.23'
L4	N 79°42'25" E	67.27'
L5	S 83°51'46" E	45.82'
L6	N 62°06'26" E	21.82'
L7	S 89°30'21" E	55.48'
L8	N 79°37'43" E	88.02'
L9	S 72°28'22" E	21.31'
L10	N 61°13'21" E	68.15'
L11	N 80°01'10" E	71.83'
L12	N 59°31'06" E	50.57'
L13	N 68°48'49" W	80.17'

CURVE	DELTA ANGLE	RADIUS	ARC LENGTH	CHORD BEARING	CHORD LENGTH
C1	17°38'59"	693.02'	213.48'	N 70°07'58" E	212.64'
C2	19°28'04"	1429.43'	485.89'	N 69°13'24" E	483.36'

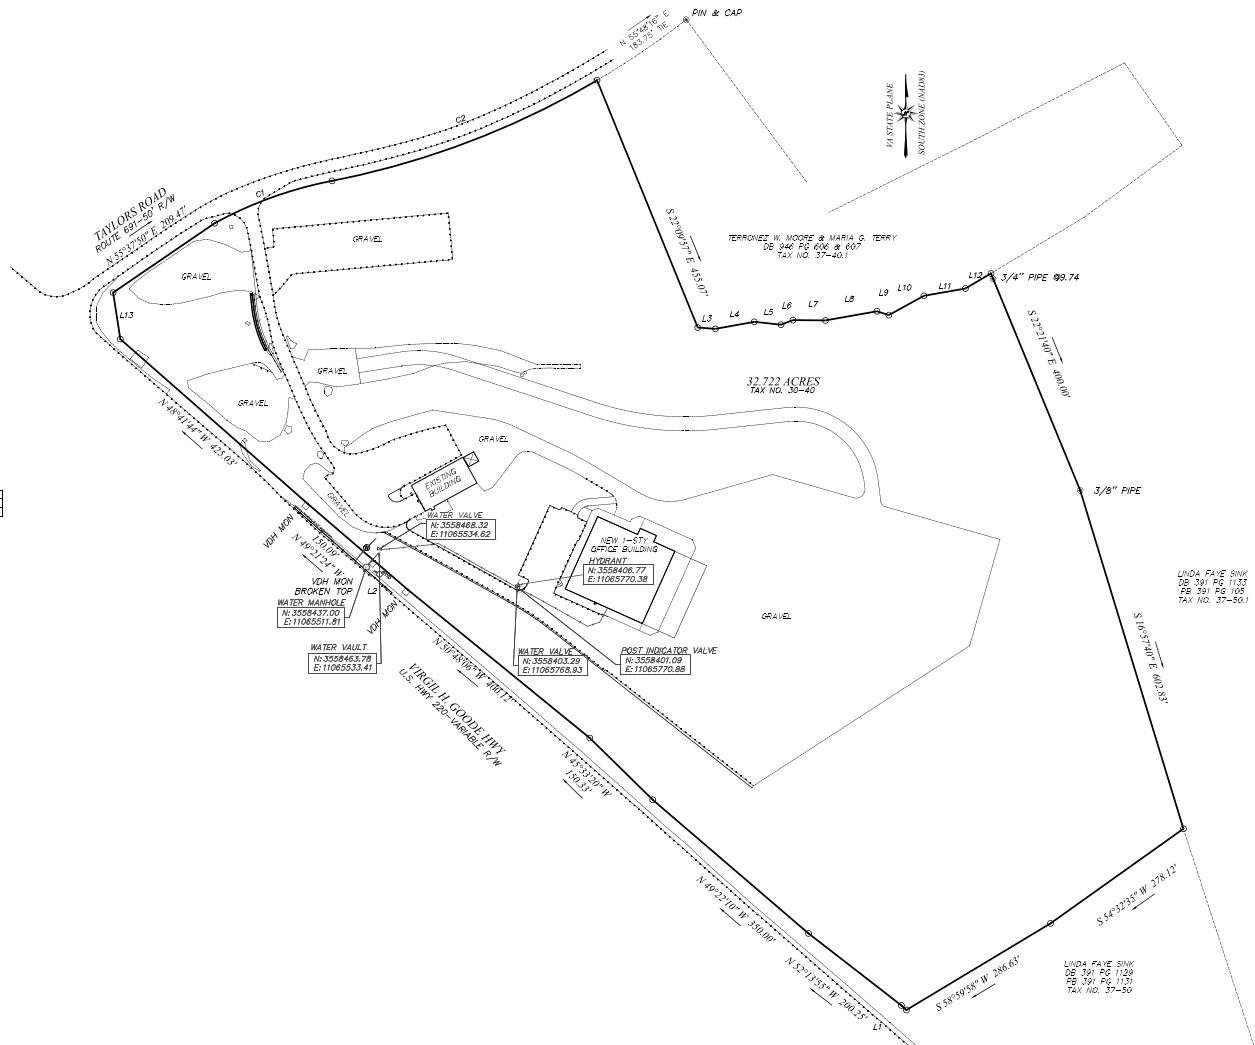

105 NORTH MAIN ST.
GRETNA, PA 15357
412-662-1001

**ARMSTRONG
& ASSOCIATES**
SURVEYING PLANNING DEVELOPMENT

ARMSTRONGANDASSOCIATES.NET
RICH@ARMSTRONGANDASSOCIATES.NET

MAP SHOWING WATERLINE ASBUILT FOR
JAMES RIVER EQUIPMENT
FRANKLIN COUNTY, VIRGINIA

PROJECT#:200119

DATE: 08-11-2021

DRAWN BY:RBA

SHEET 1 OF 1

