


Path: S:\2016 Projects\16-0047 Kennedy Shores\16-0047 E&S Phase 1.dwg

MATCHLINE: SEE SHEET C14

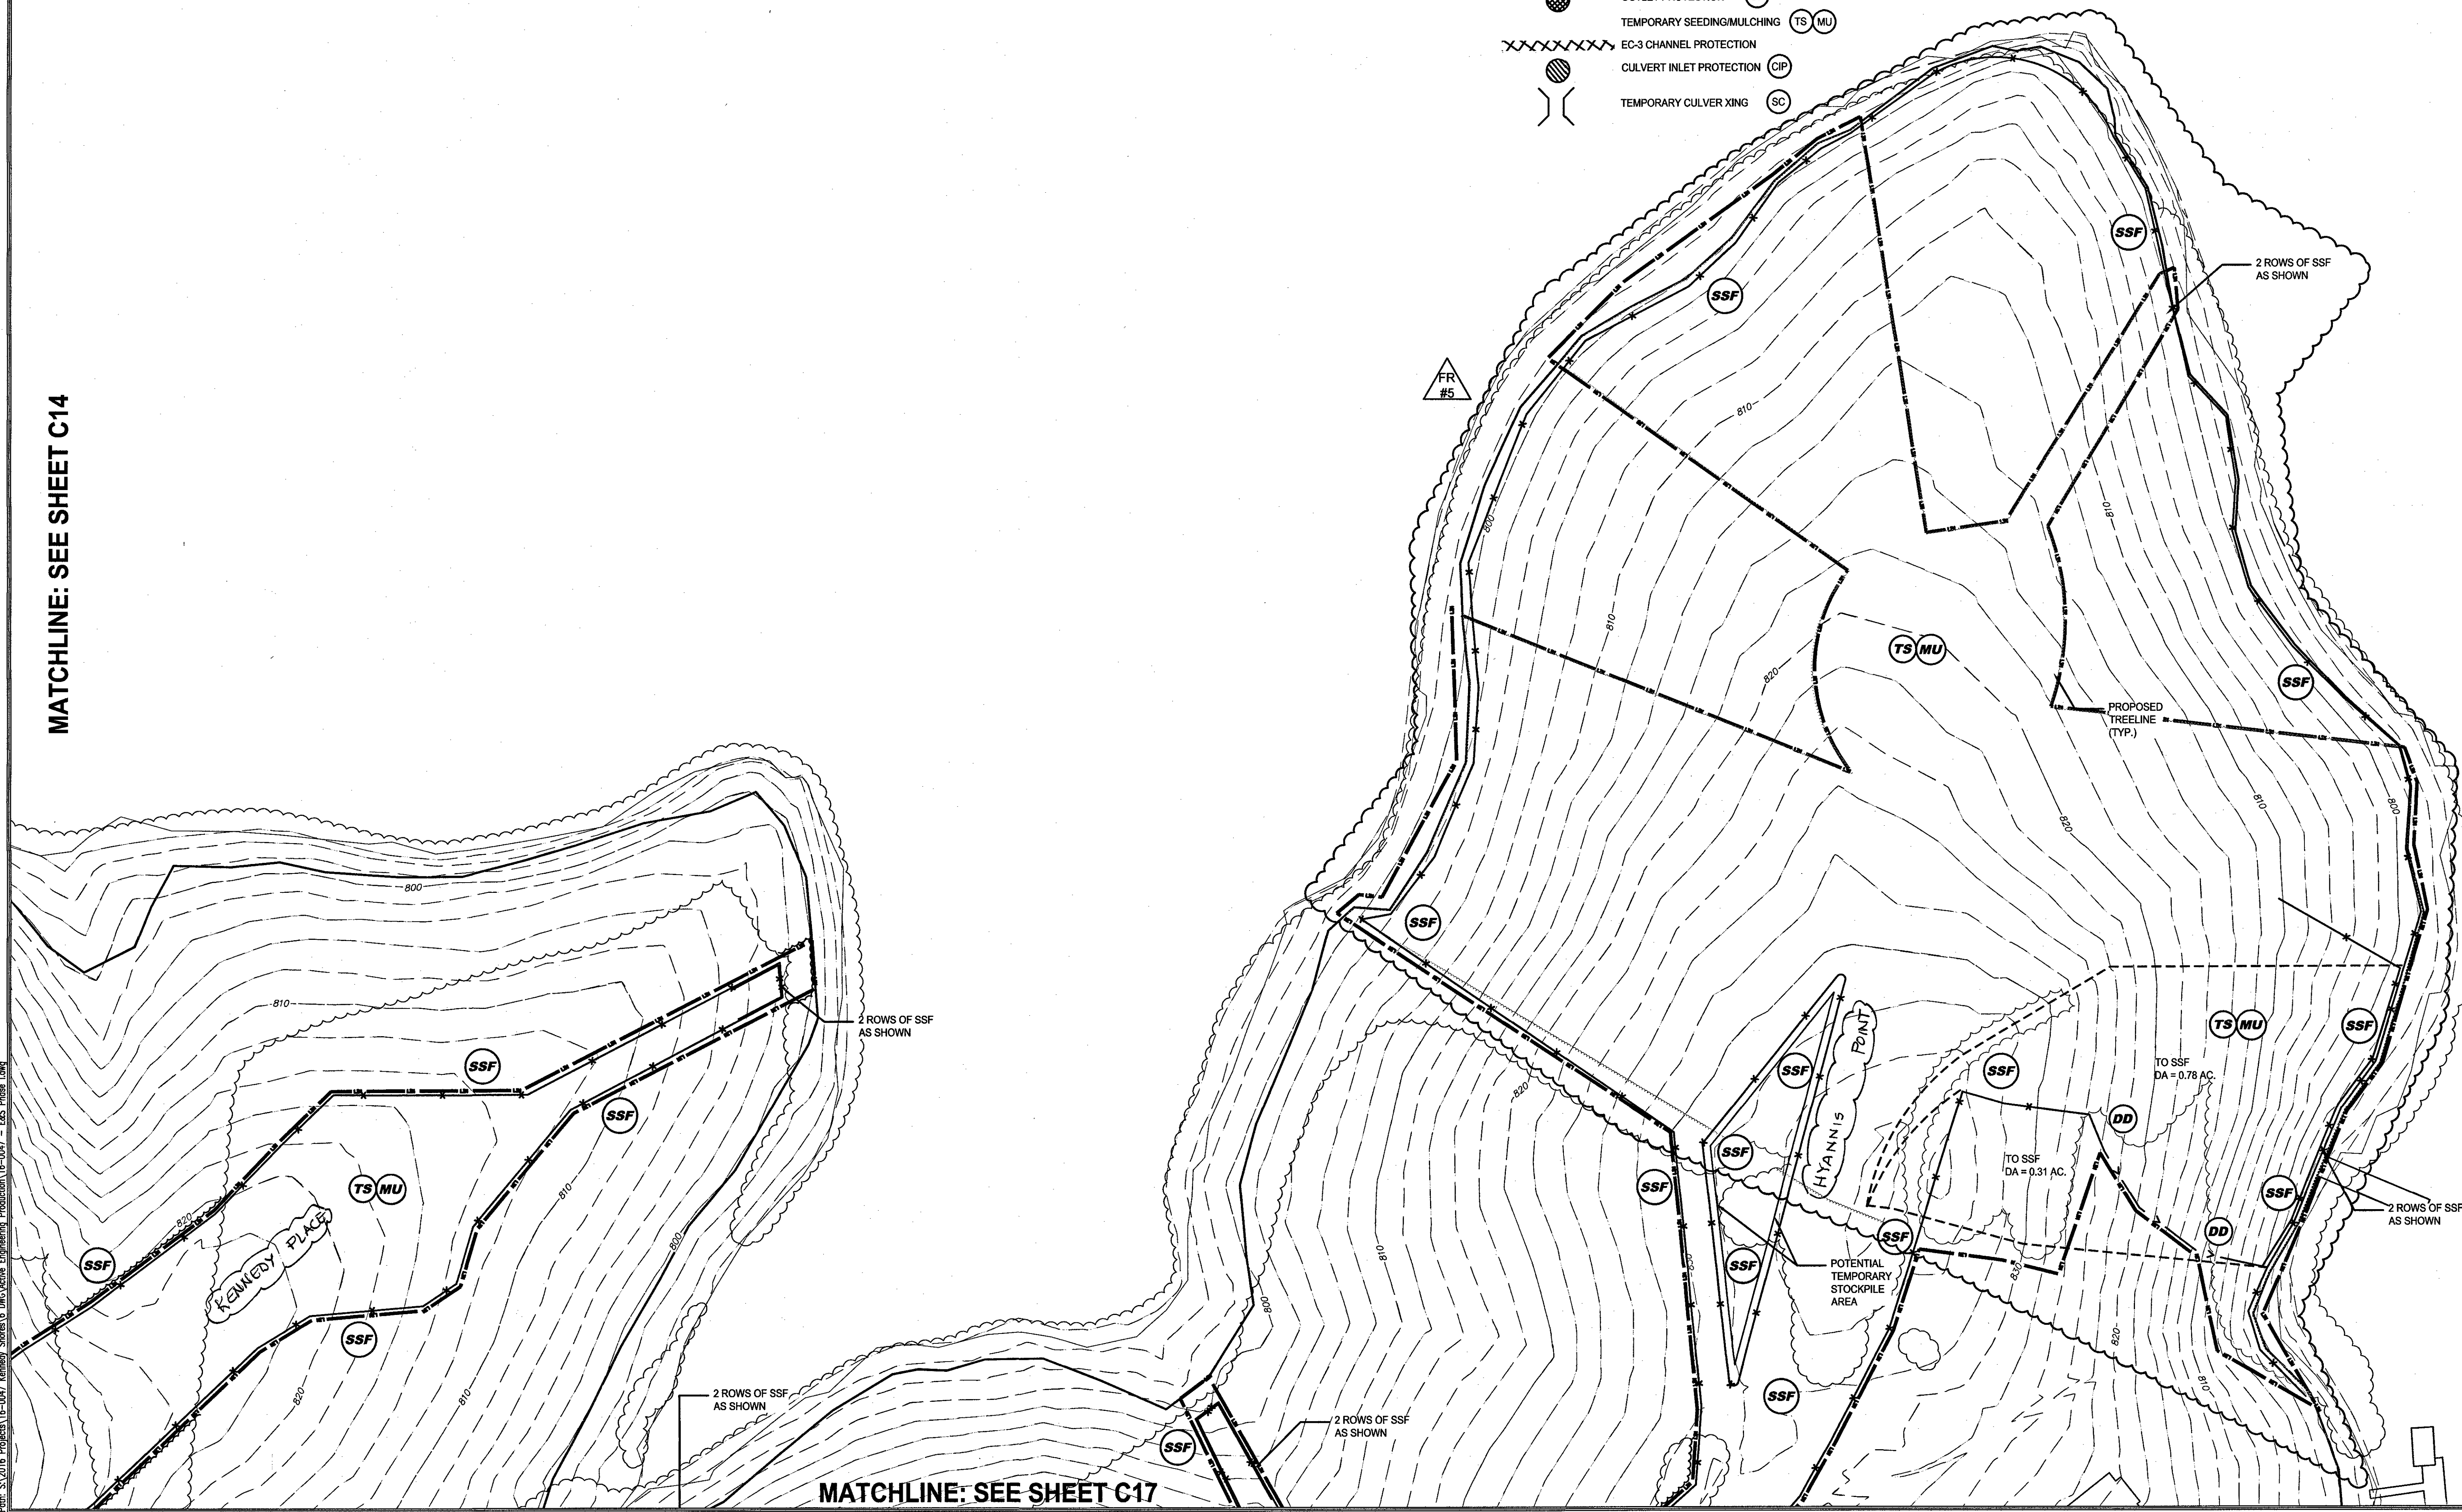

MATCHLINE: SEE SHEET C17

LEGEND

- DRAINAGE DIVIDE
- SUPER SILT FENCE
- DIVERSION DIKE
- DIVERSION
- TREE PROTECTION
- INLET PROTECTION
- OUTLET PROTECTION
- TEMPORARY SEEDING/MULCHING
- EC-3 CHANNEL PROTECTION
- CULVERT INLET PROTECTION
- TEMPORARY CULVERT XING

- SSF
- DD
- DV
- TP
- IP
- OP
- TS MU
- CIP
- SC


50' 25' 0' 50' 100'
GRAPHIC SCALE
1" = 50'



parker
DESIGN GROUP

2122 Carolina Ave. SW
Roanoke, VA 24014
Ph: 540-387-1153
Fax: 540-389-5767
1915-B W. Cary Street
Richmond, VA 23220
Phone: 804-358-2947
Fax: 804-359-9645
www.parkerdgd.com

These documents are the property of Parker Design Group (PDG) and may not be reproduced or used without the express permission of PDG. Any reuse of these documents without authorization of PDG will be at the sole risk of the individual or entity utilizing said documents.

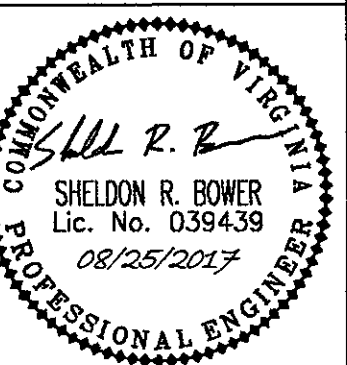

KENNEDY SHORES SUBDIVISION DEVELOPMENT PLAN

Tax # 0510001500
Franklin County, Virginia

REVISIONS:
2/10/2017 - 1ST SUB COMMENTS
2/14/2017 - 2ND SUB COMMENTS
4/14/2017 - 3RD SUB COMMENTS
6/23/2017 - FIELD REVISION #1
7/6/2017 - FIELD REVISION #2
8/4/2017 - FIELD REVISION #3
8/9/2017 - FIELD REVISION #4
8/25/2017 - FIELD REVISION #5

DESIGNED BY: JMM/SRB

DRAWN BY: JMM/JLK

CHECKED BY: SRB

DATE:
6 JANUARY, 2017

SHEET TITLE:
PHASE 1 E&S
CONTROL PLAN

SCALE:
1"=50'

SHEET NO.

C16