
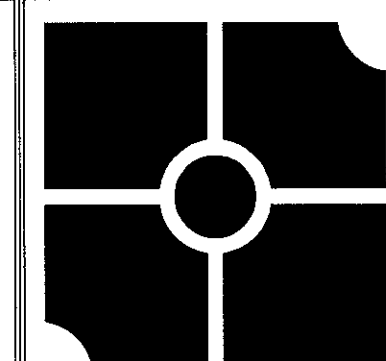
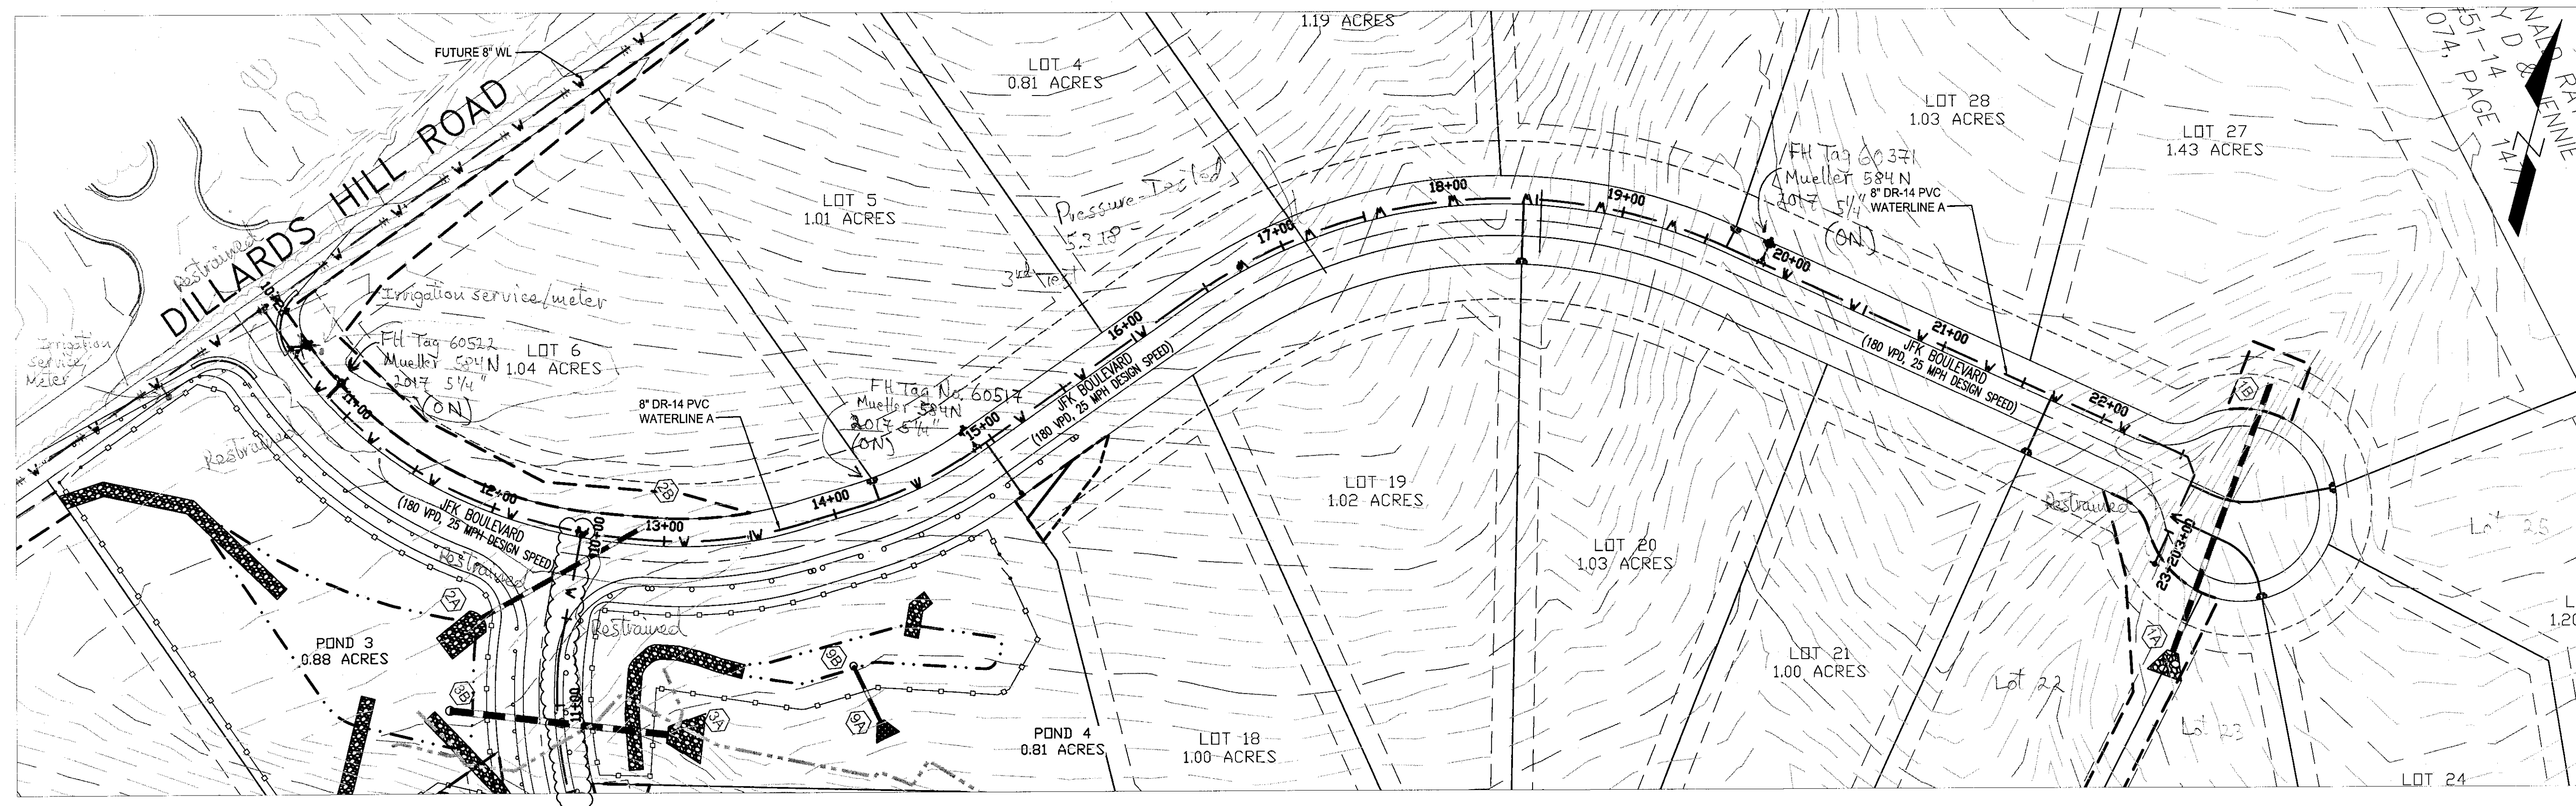


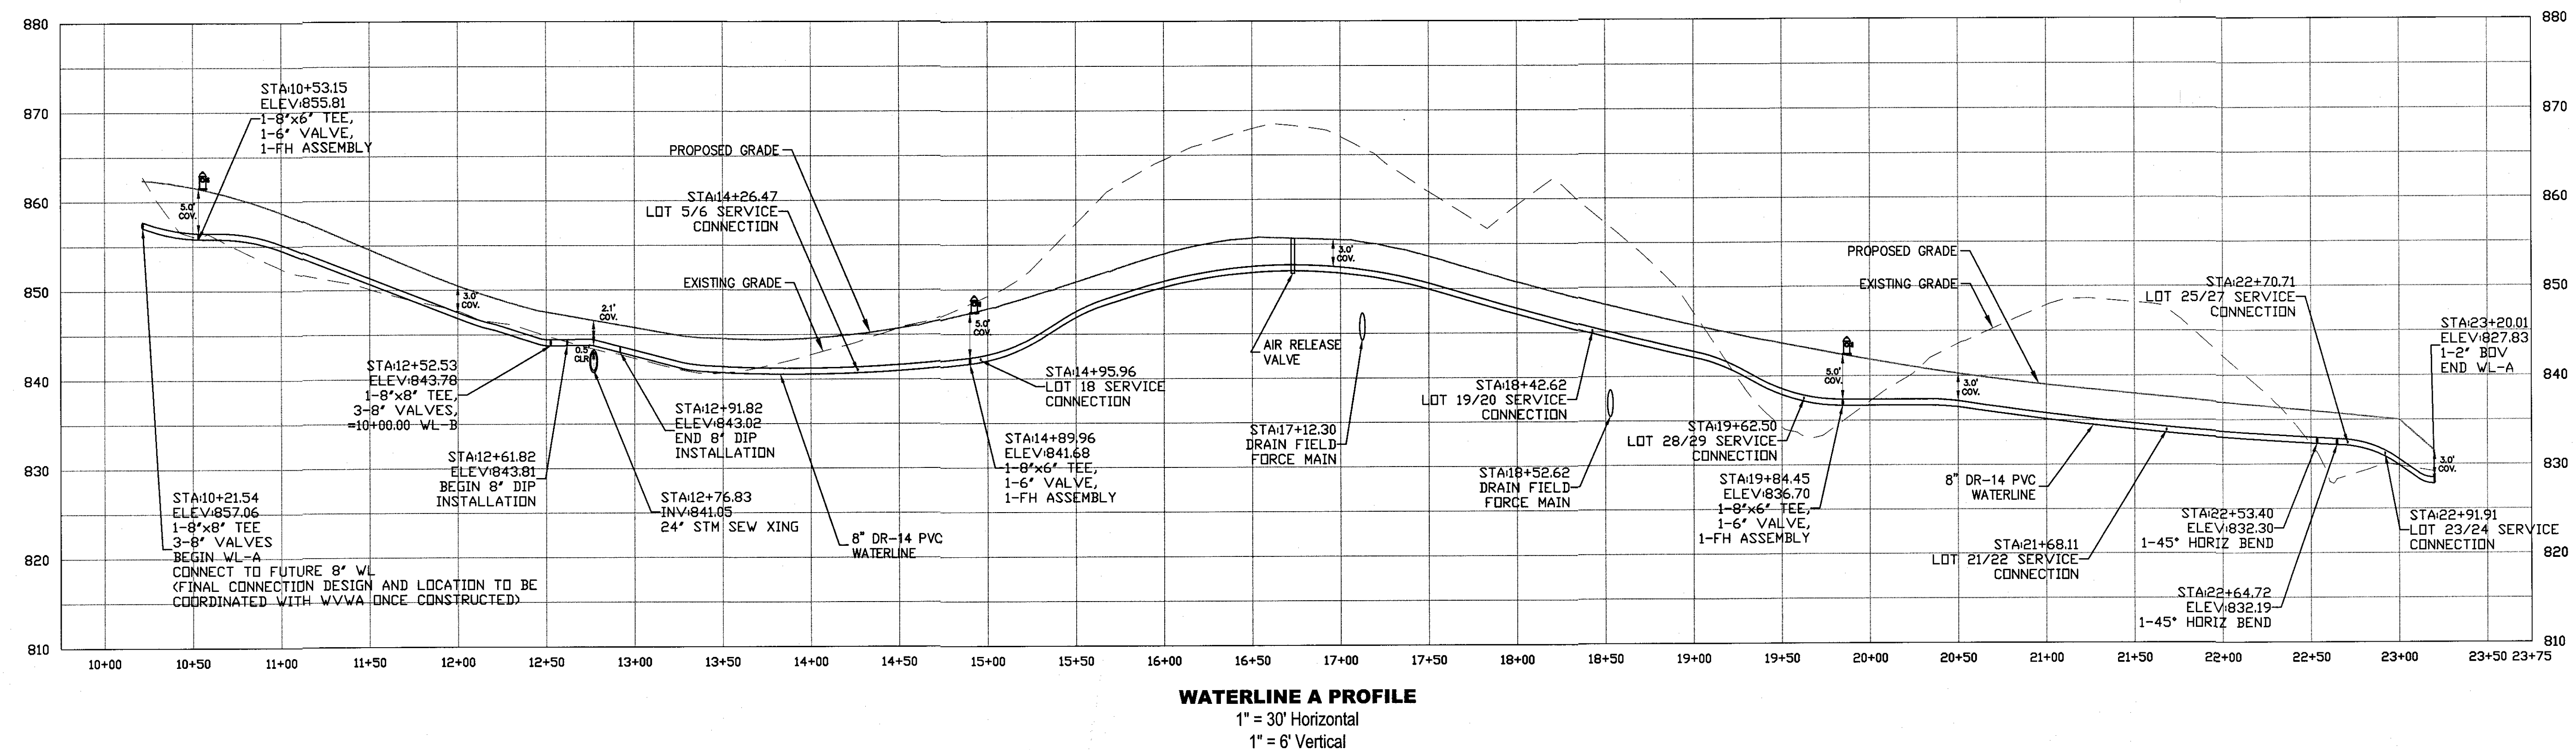


parker
DESIGN GROUP

2122 Carolina Ave, SW
Roanoke, VA 24014
Ph: 540-387-1153
Fax: 540-389-5767

1915-B W. Cary Street
Richmond, VA 23220
Phone: 804-358-2947
Fax: 804-359-9645

www.parkerdg.com

These documents are the property of Parker Design Group (PDG) and may not be reproduced or used without the express permission of PDG. Any reuse of these documents without authorization of PDG will be at the sole risk of the individual or entity utilizing said documents.

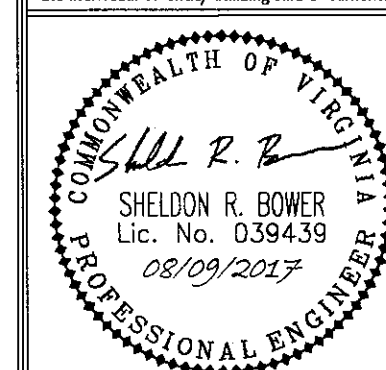

**KENNEDY SHORES
SUBDIVISION DEVELOPMENT PLAN**
Tax # 0510001500
Franklin County, Virginia

REVISIONS:
2/10/2017 - 1ST SUB COMMENT
3/21/2017 - 2ND SUB COMMENT
4/14/2017 - 3RD SUB COMMENT
6/23/2017 - FIELD REVISION
7/6/2017 - FIELD REVISION
8/4/2017 - FIELD REVISION
8/9/2017 - FIELD REVISION

DESIGNED BY: JMM/SR

DRAWN BY: JMM/JL

CHECKED BY: SR

DATE:
6 JANUARY, 2017

SHEET TITLE:
WATERLINE PLAN
AND PROFILES

SCALE:
1"=50'

SHEET NO.

C31