
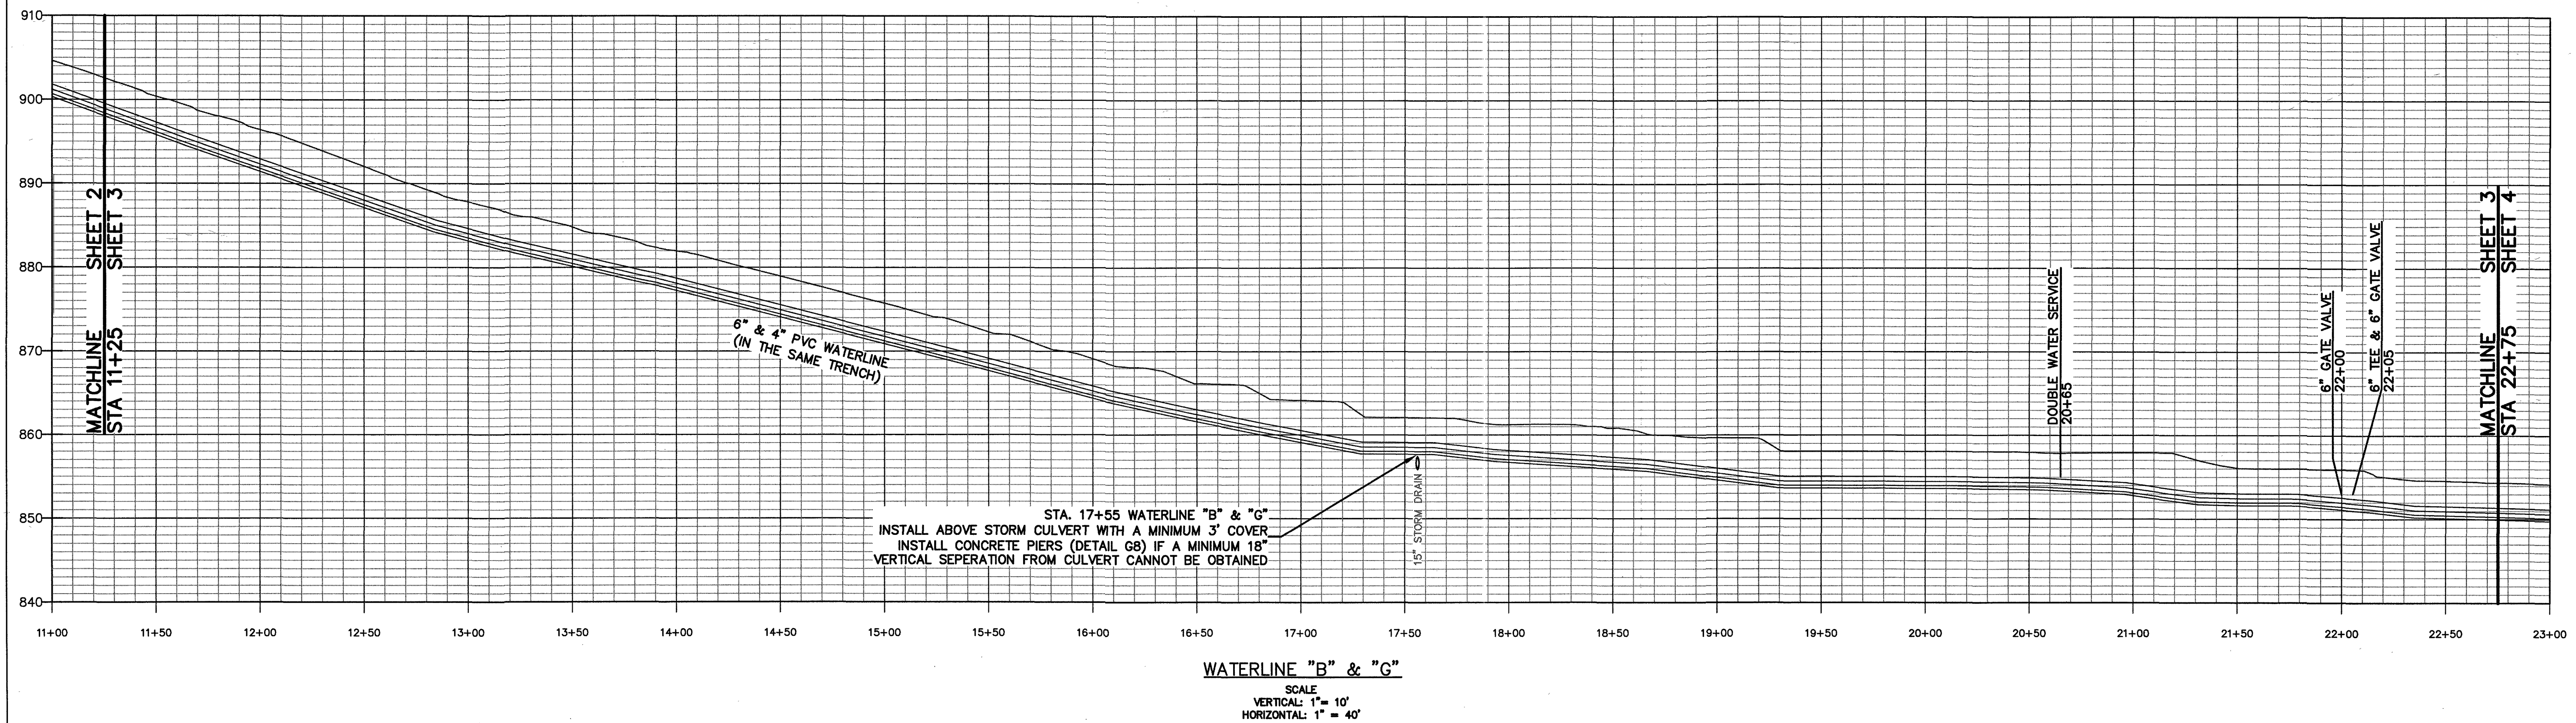


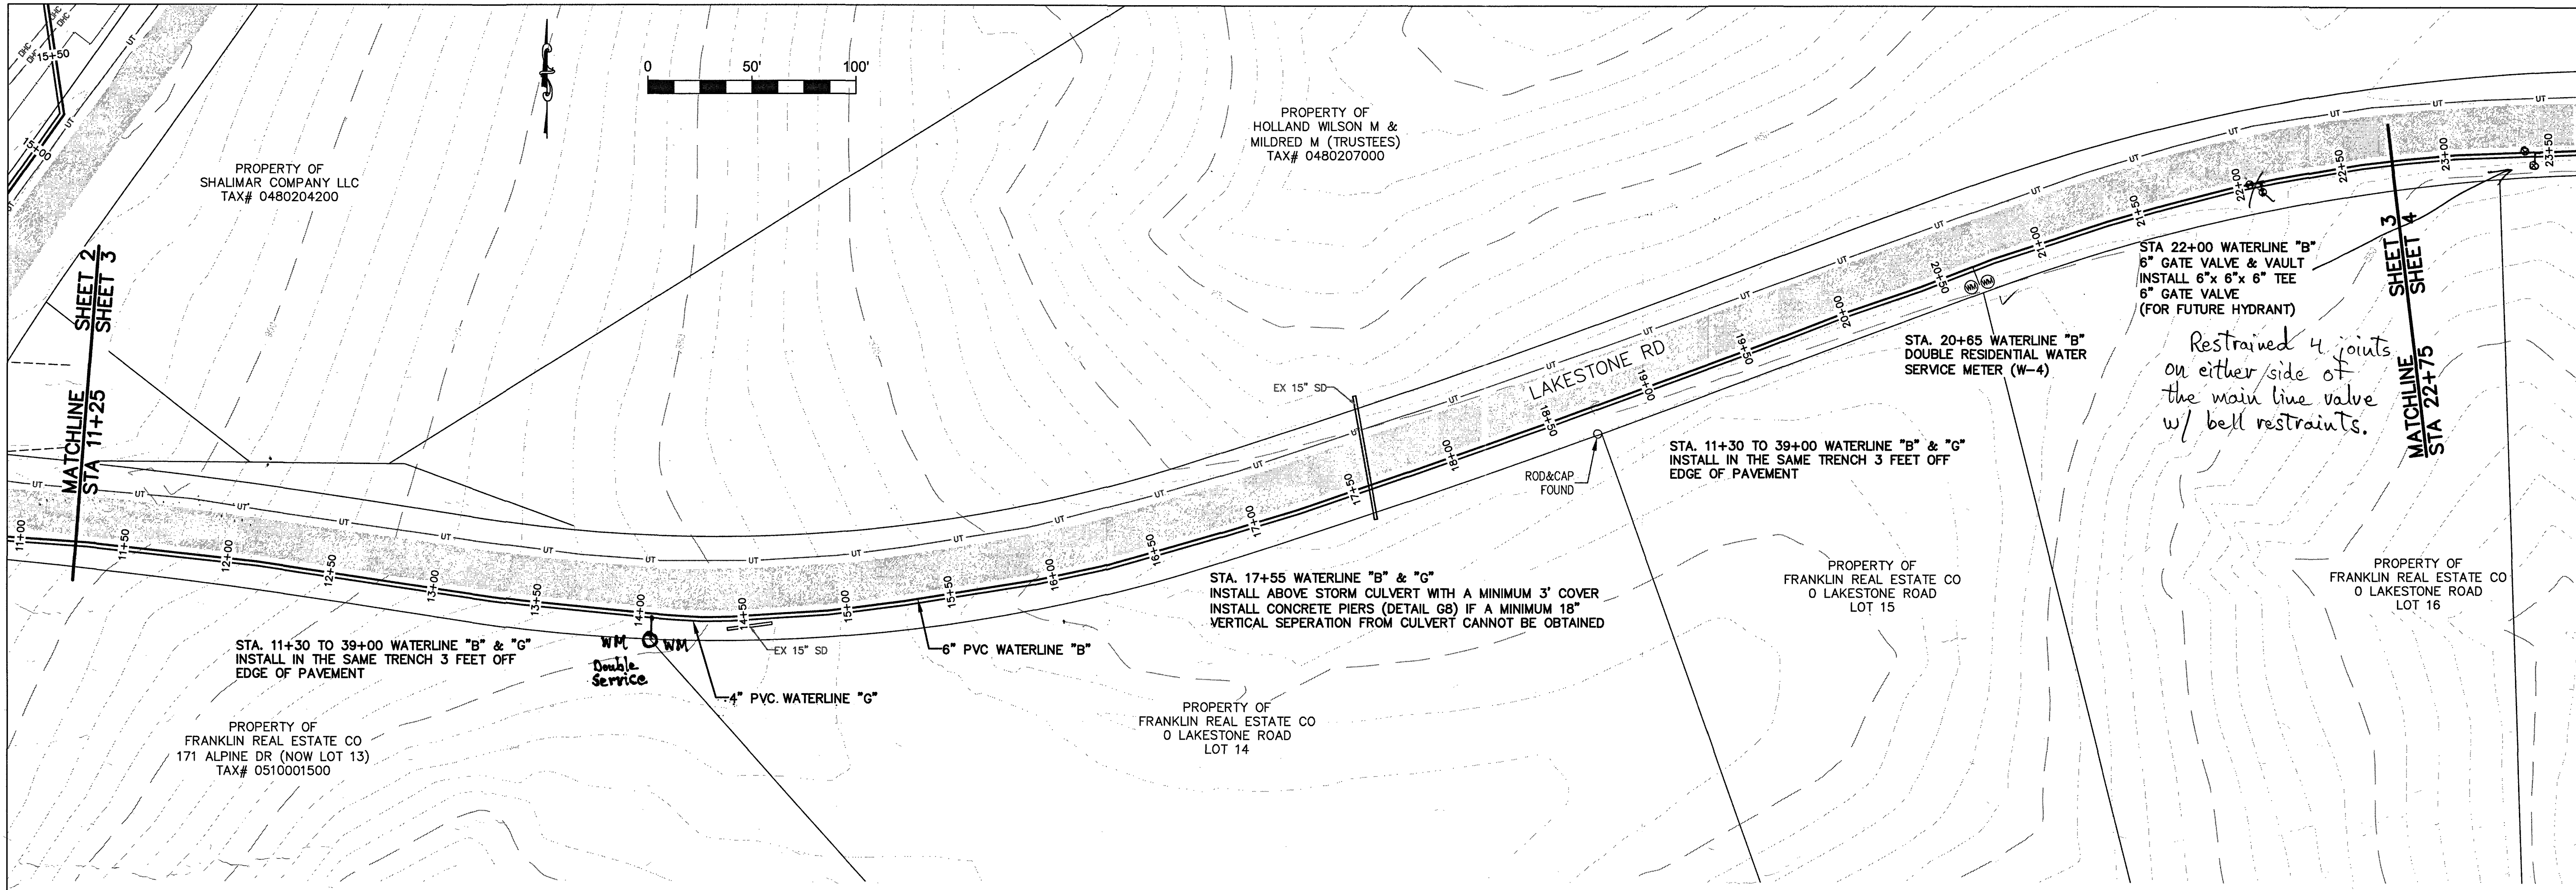

WESTERN VIRGINIA
WATER AUTHORITY
ENGINEERING SERVICES
601 S JEFFERSON ST, SUITE 300
ROANOKE, VA 24011
540-853-5641 or 540-853-5770

DAVID M. VOGELSONG
Lic. No. 023274
PROFESSIONAL ENGINEER
STATE OF VIRGINIA

LAKESTONE ROAD
WATER EXTENSION

PLAN & PROFILE

Rev	Description	Date	By
4"	WELL LINE CHANGE ORDER	3-30-16	DRJ

Designed: DMV
Drawn: DRJ
Checked:
Approved:
Date:
Project:

3
Sheet 3 of 7

As-Builts K. Winslow