

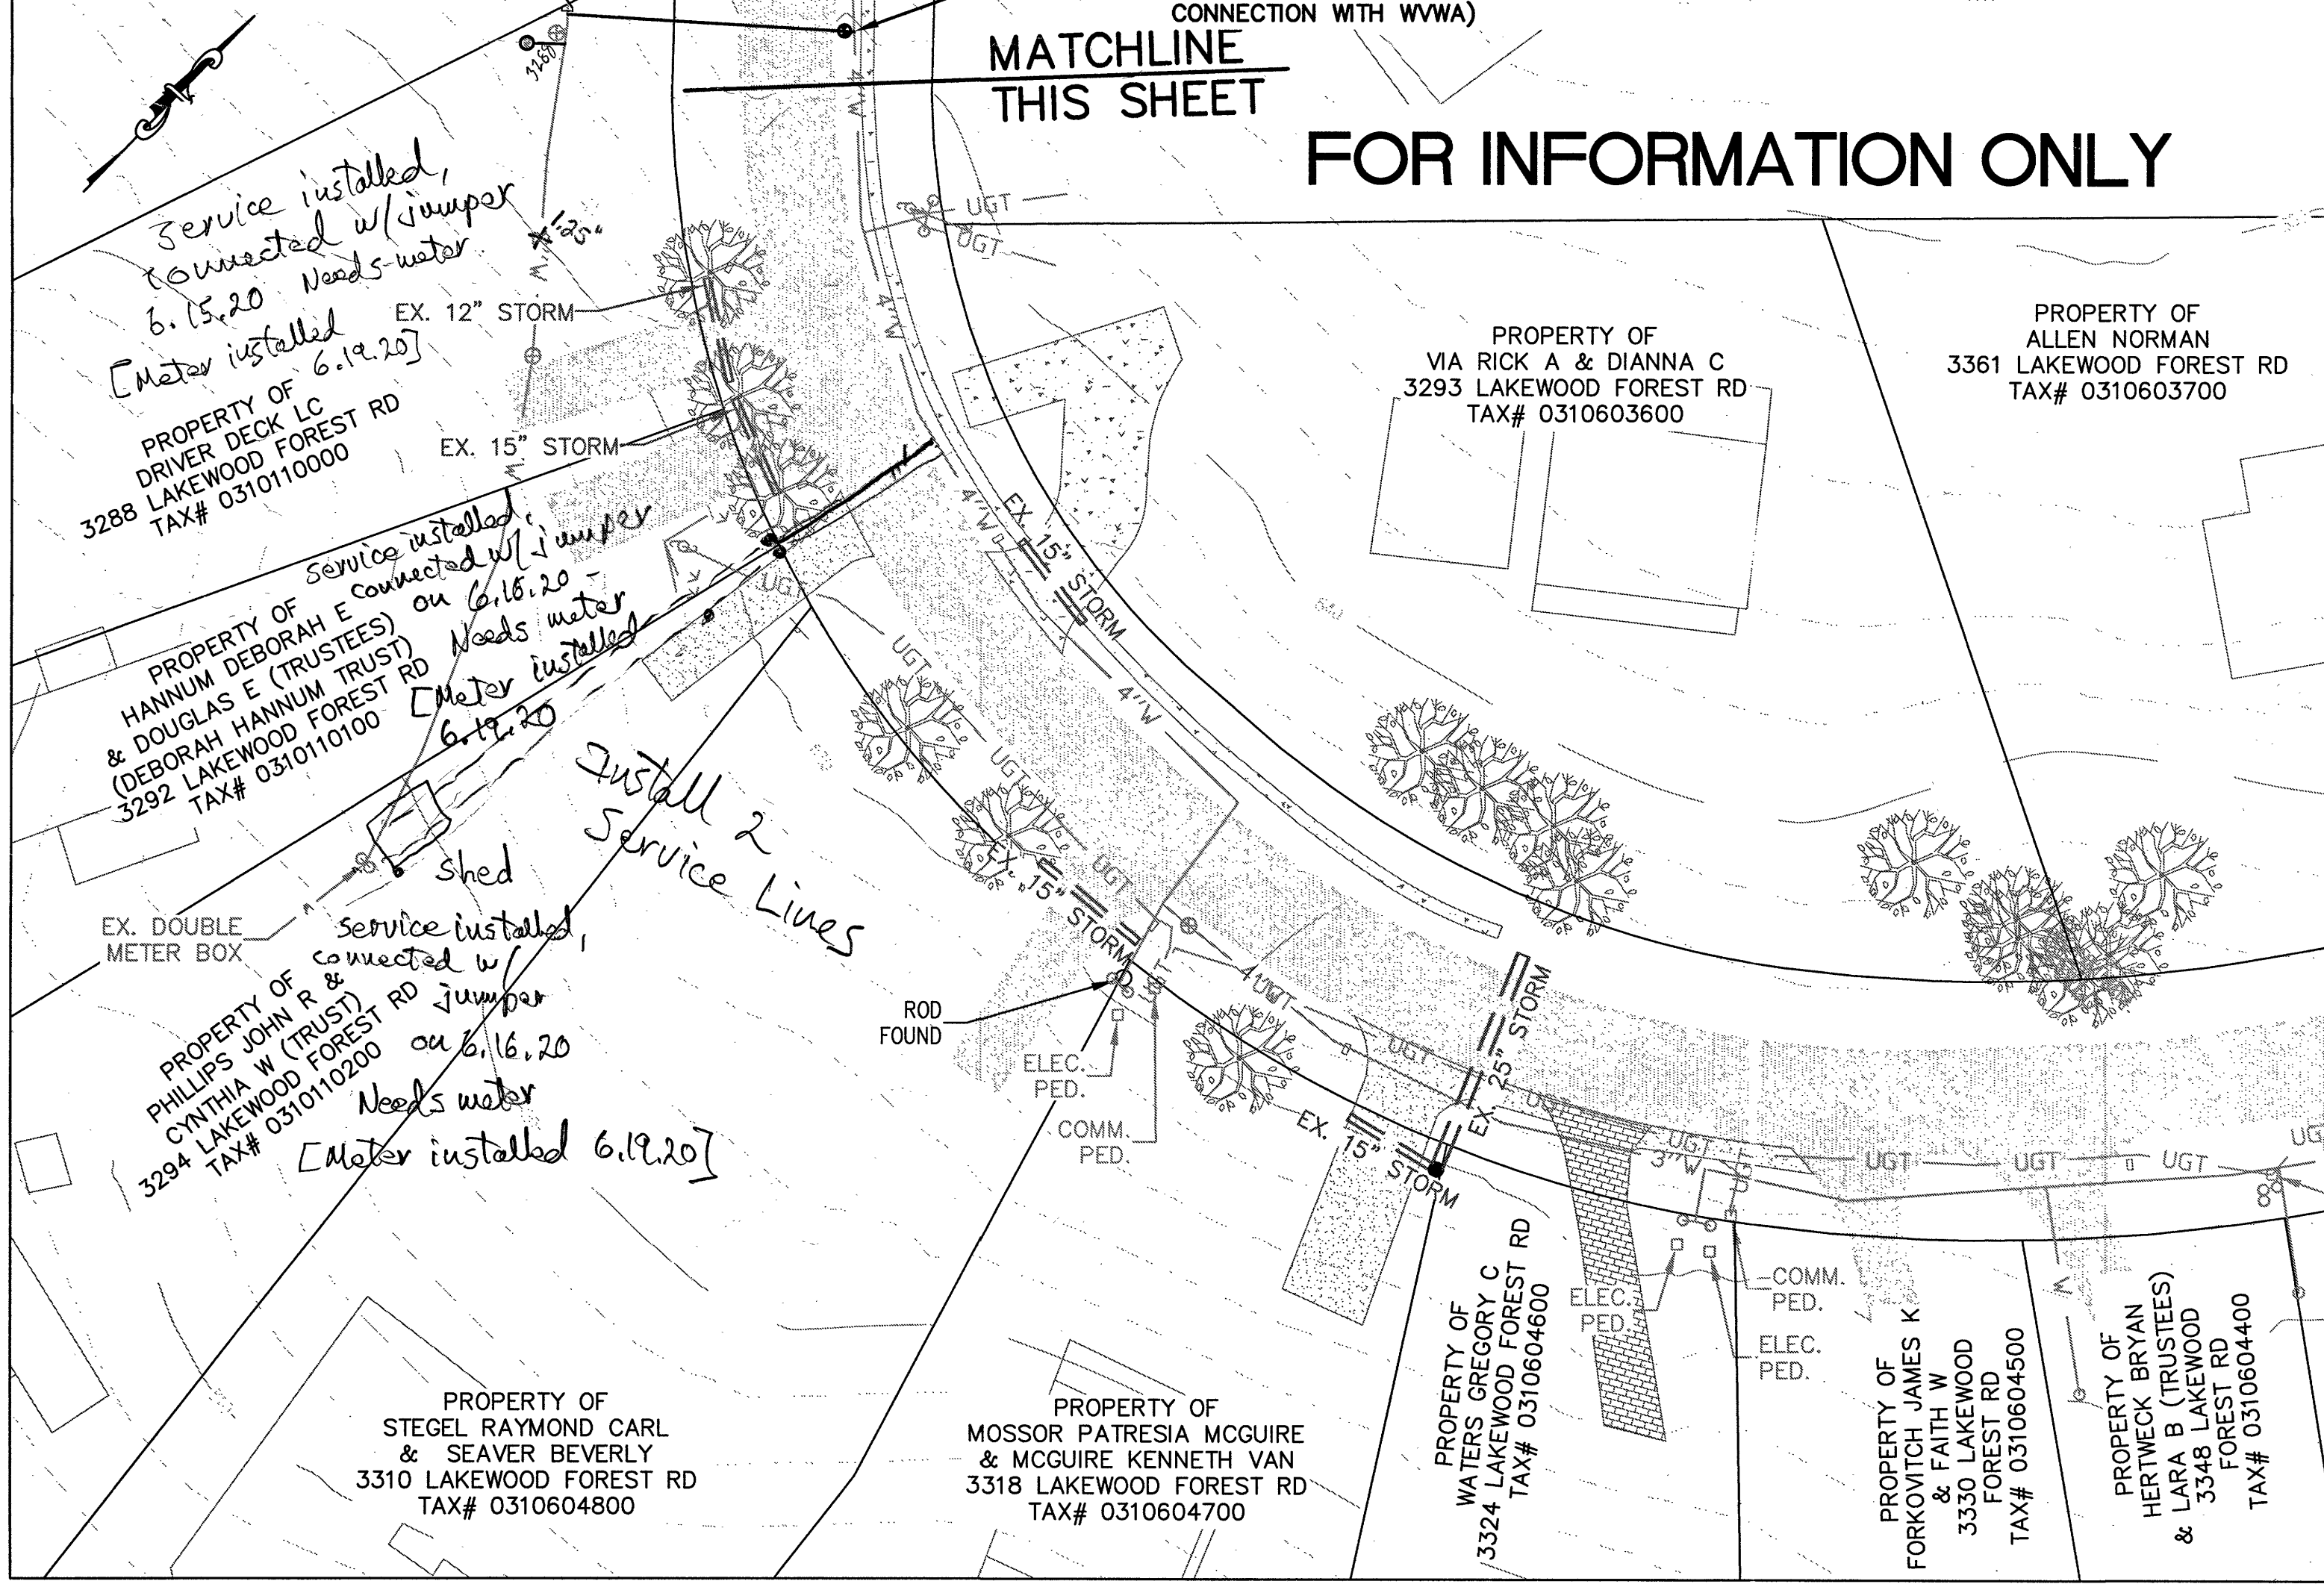


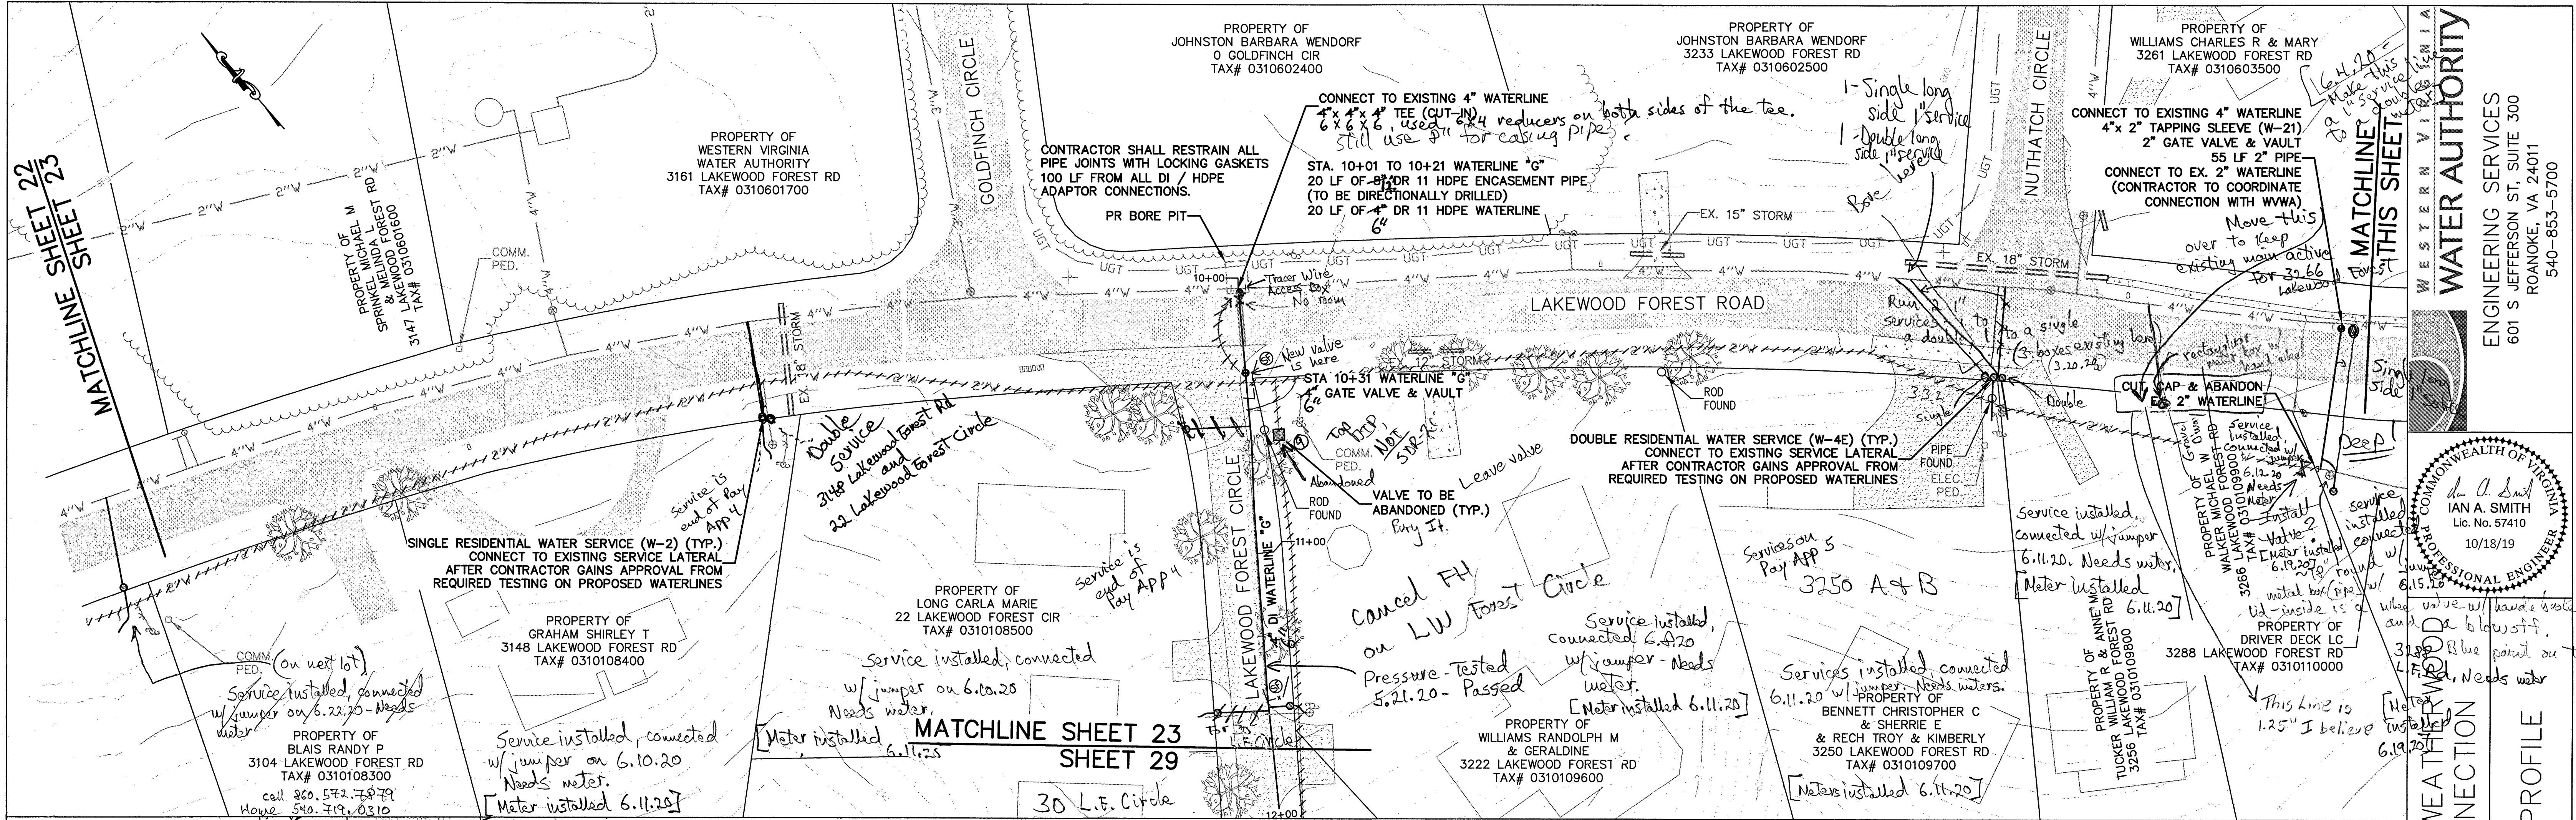

FOR INFORMATION ONLY

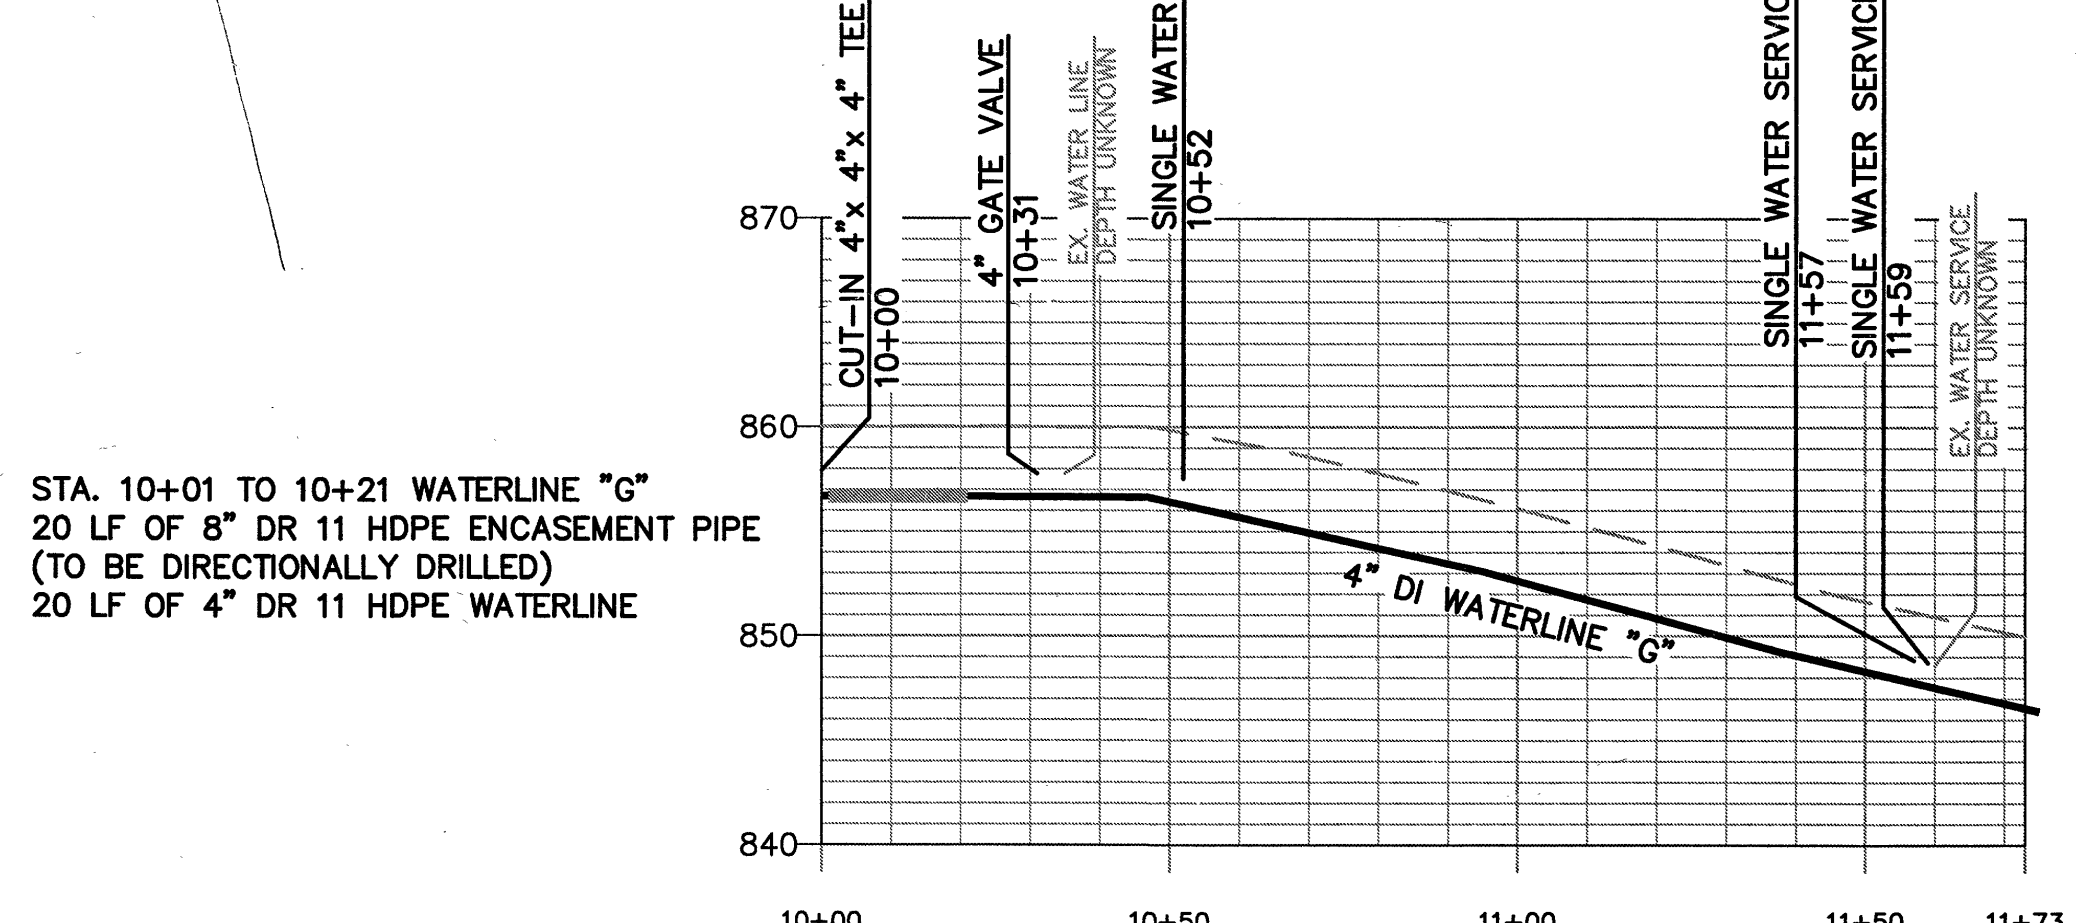

- GENERAL NOTES:**
1. PROPERTY LINES SHOWN ON THE PAGE ARE BASED ON GIS DATA AND HAVE NOT BEEN FIELD SURVEYED.
 2. MOST EXISTING WATER SERVICE LOCATIONS ARE UNKNOWN. CONTRACTOR TO COORD. WITH WVWA TO LOCATE EXISTING SERVICES.
 3. LOCATION OF EXISTING WATERLINES SHOWN ON THIS PLAN ARE ESTIMATED. CONTRACTOR TO POTHOLE & LOCATE EXISTING WATERLINES AS NEEDED.
- GENERAL NOTES:**
1. GENERALLY, ALL DRIVEWAY REPAIRS SHALL START FROM THE EDGE OF THE ROADWAY PAVEMENT SO THAT THERE WILL ONLY BE ONE REPAIR JOINT IN THE DRIVEWAY.
 2. THE CONTRACTOR SHALL STAGE EQUIPMENT OUTSIDE OF THE RIGHT OF WAY AND CLEAR ZONE DURING CONSTRUCTION.
 3. THE CONTRACTOR SHALL CONSTRUCT THE WATERLINE OUTSIDE THE LIMITS OF DEFINED DRAINAGE DITCH LINES THAT LIE WITHIN THE VDOT RIGHT OF WAY.
 4. THE WATERLINE SHALL GENERALLY BE INSTALLED 3 FEET OFF THE EDGE OF EXISTING PAVEMENT.

cut and install valve at left corner of property of 3256 Lakewood Forest Rd. instead of 3266 - 3266 may be tied into the main, and way need a new service - dig around the box for 3266 to see if it tees off for a service to 3266.

WESTERN VIRGINIA
WATER AUTHORITY
ENGINEERING SERVICES
601 S JEFFERSON ST, SUITE 300
ROANOKE, VA 24011
540-853-5700

LAKEWOOD & WEATHERWOOD
INTERCONNECTION

PLAN & PROFILE

Rev	Description	Date	By
1	REVISED PER 3RD PARTY REVIEW	8/22/19	NSS
2	VDOT COMMENTS	10/14/19	NSS

Designed: DRJ, NSS
Drawn: AAS, NSS
Checked: AJC, DRJ
Approved:
Date:
Project: WCIP-234

23
Sheet 23 of 32