

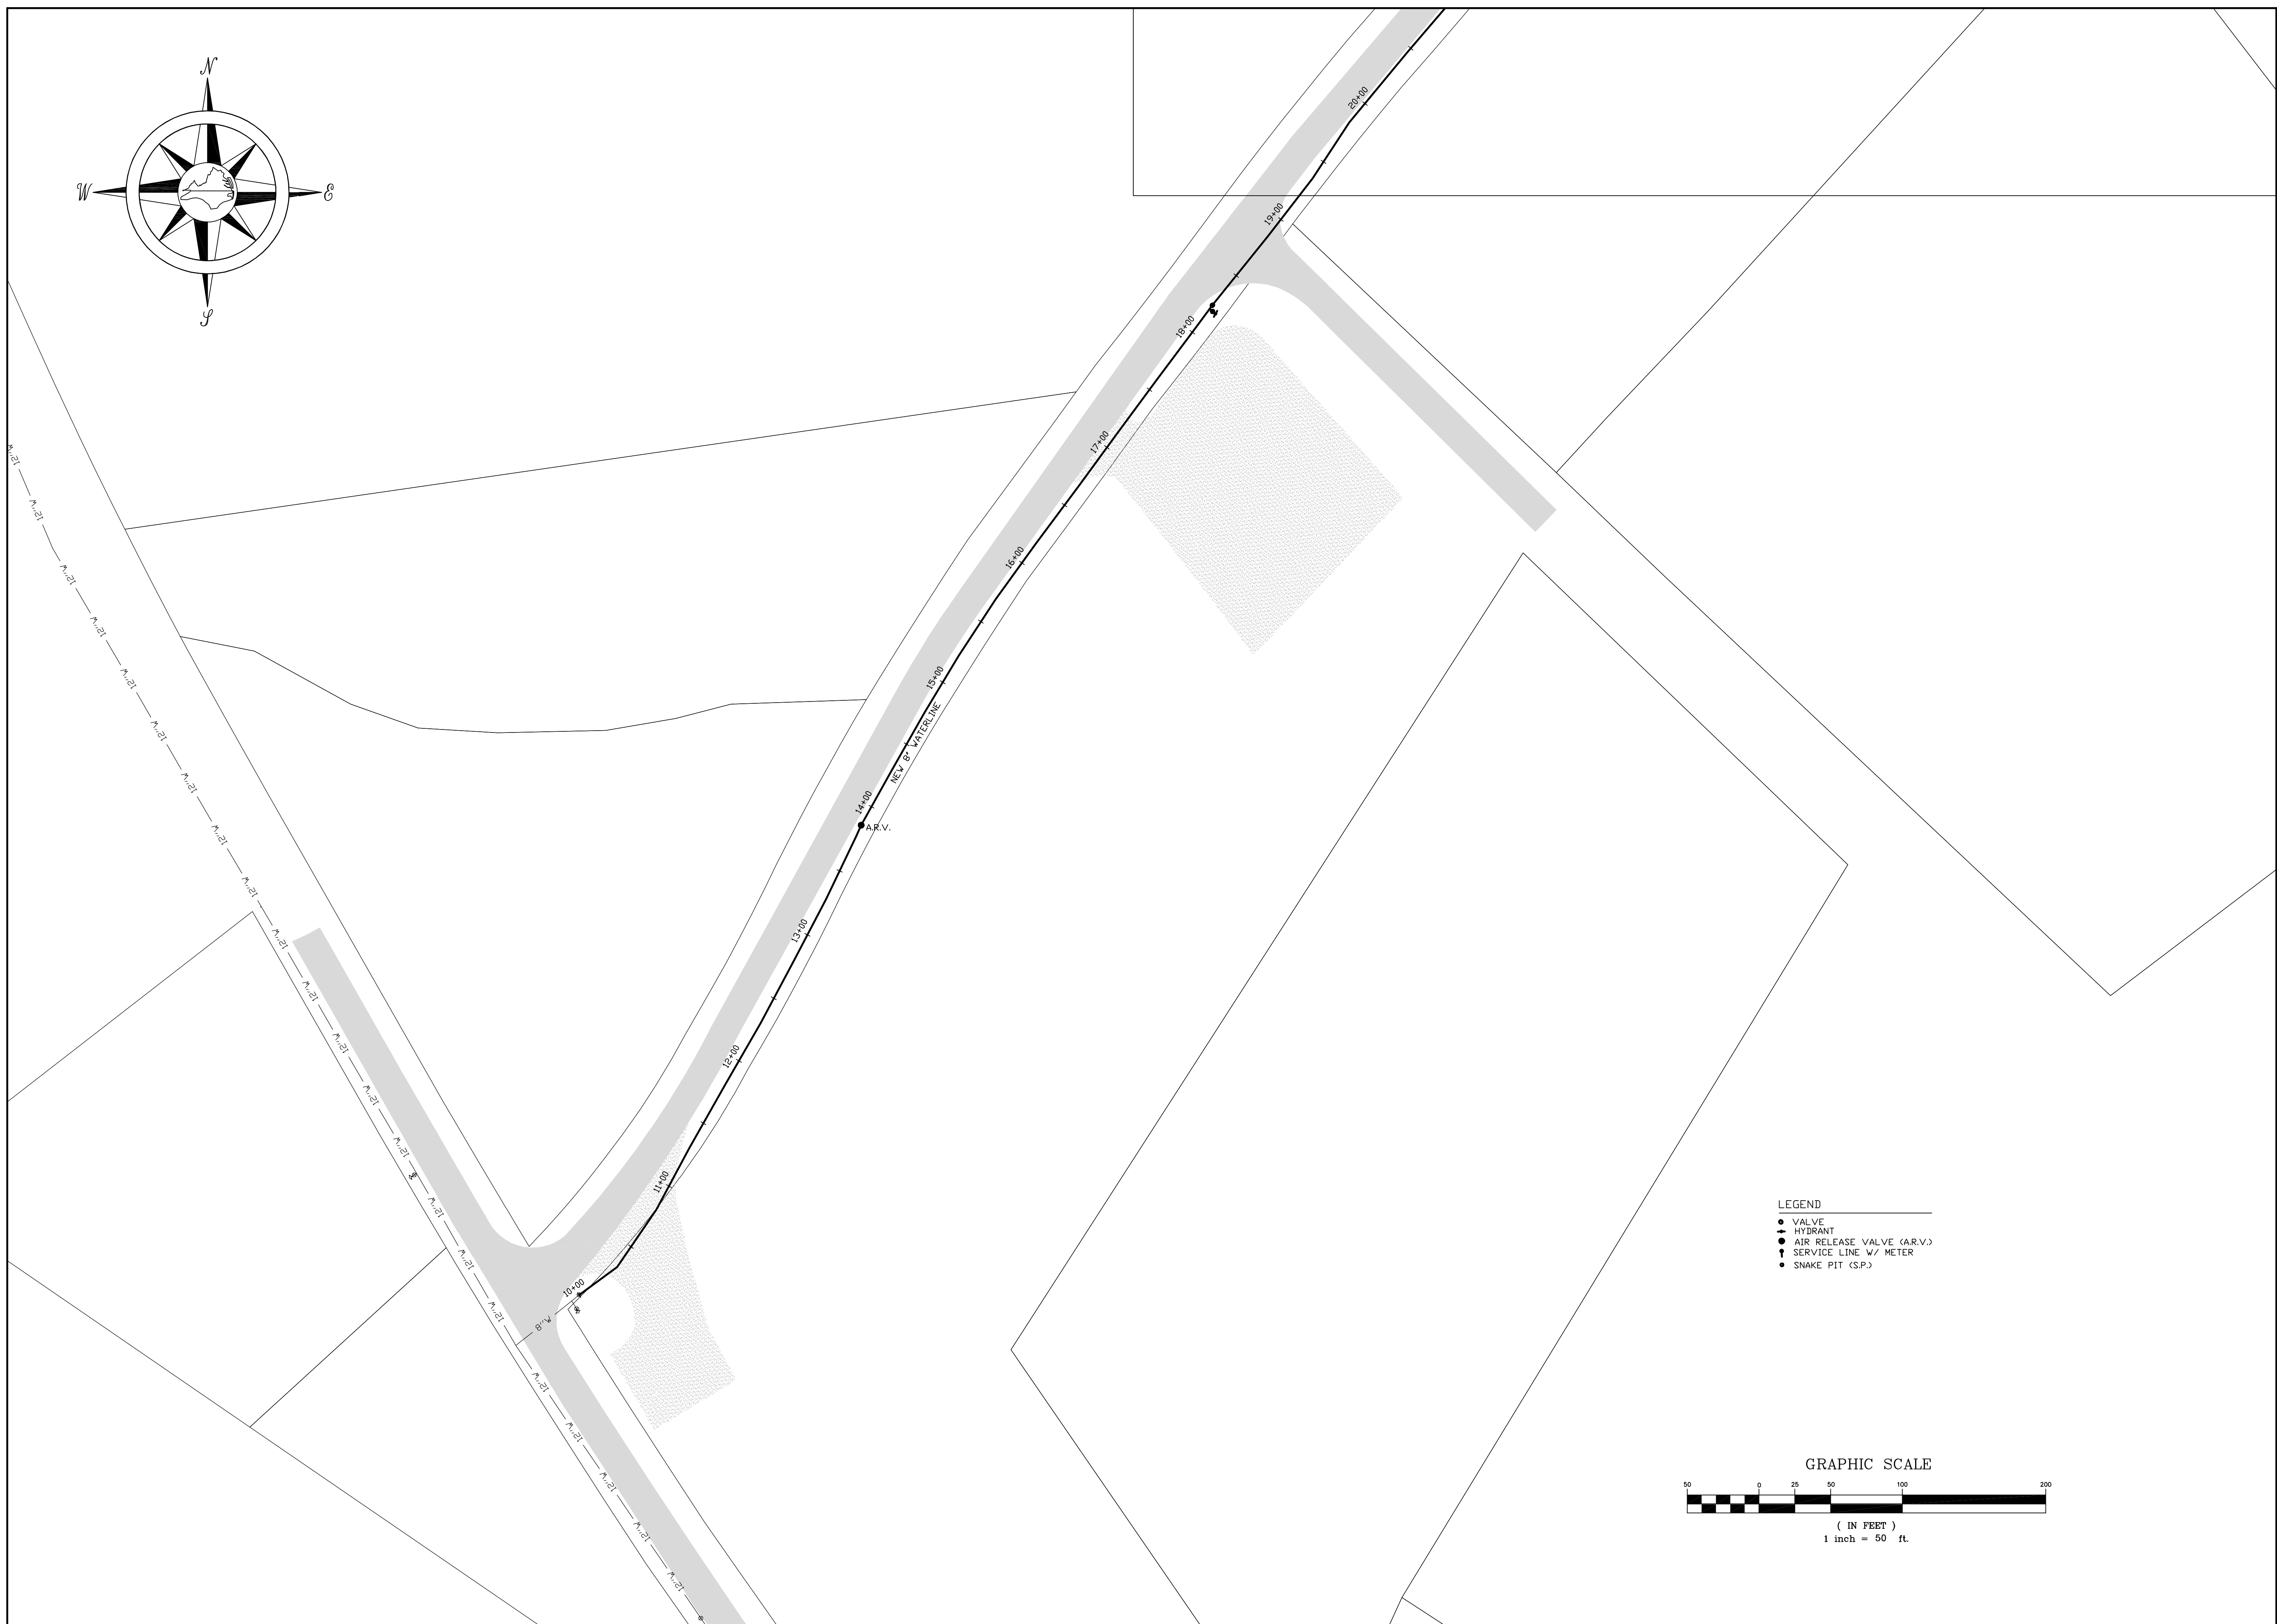


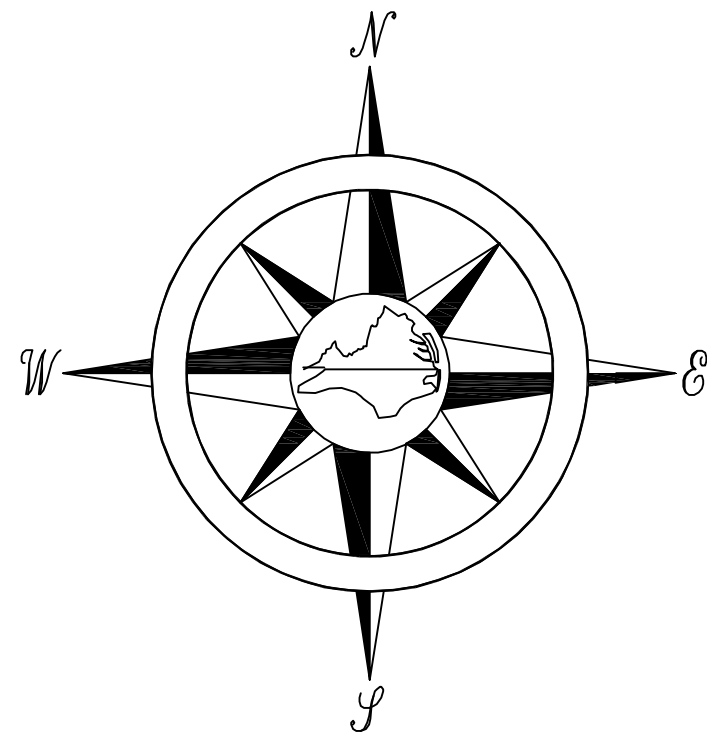


- LEGEND
- VALVE
 - HYDRANT
 - AIR RELEASE VALVE (A.R.V.)
 - SERVICE LINE W/ METER
 - SNAKE PIT (S.P.)

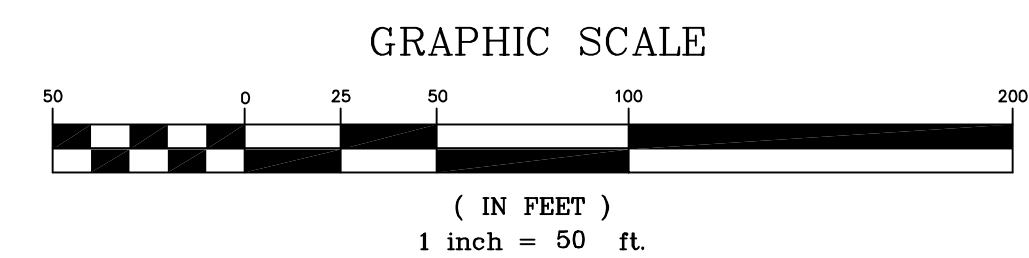

BENCHMARK Surveying & Design, PLC
5017 ARARAT HIGHWAY, ARARAT, VIRGINIA 24053
PATRICK N. HALL L.S. #2667 PH. (276) 251-5119

REVISIONS	
NO.	DATE DESCRIPTION

DATE 9/07/20

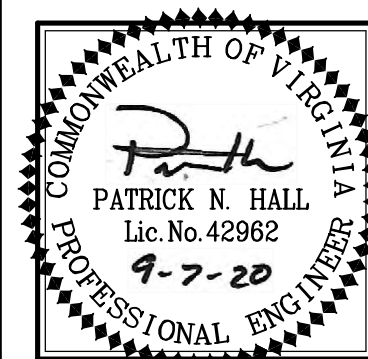

AS-BUILT SURVEY

LAKEWOOD FOREST & WEATHERWOOD INTERCONNECTION