

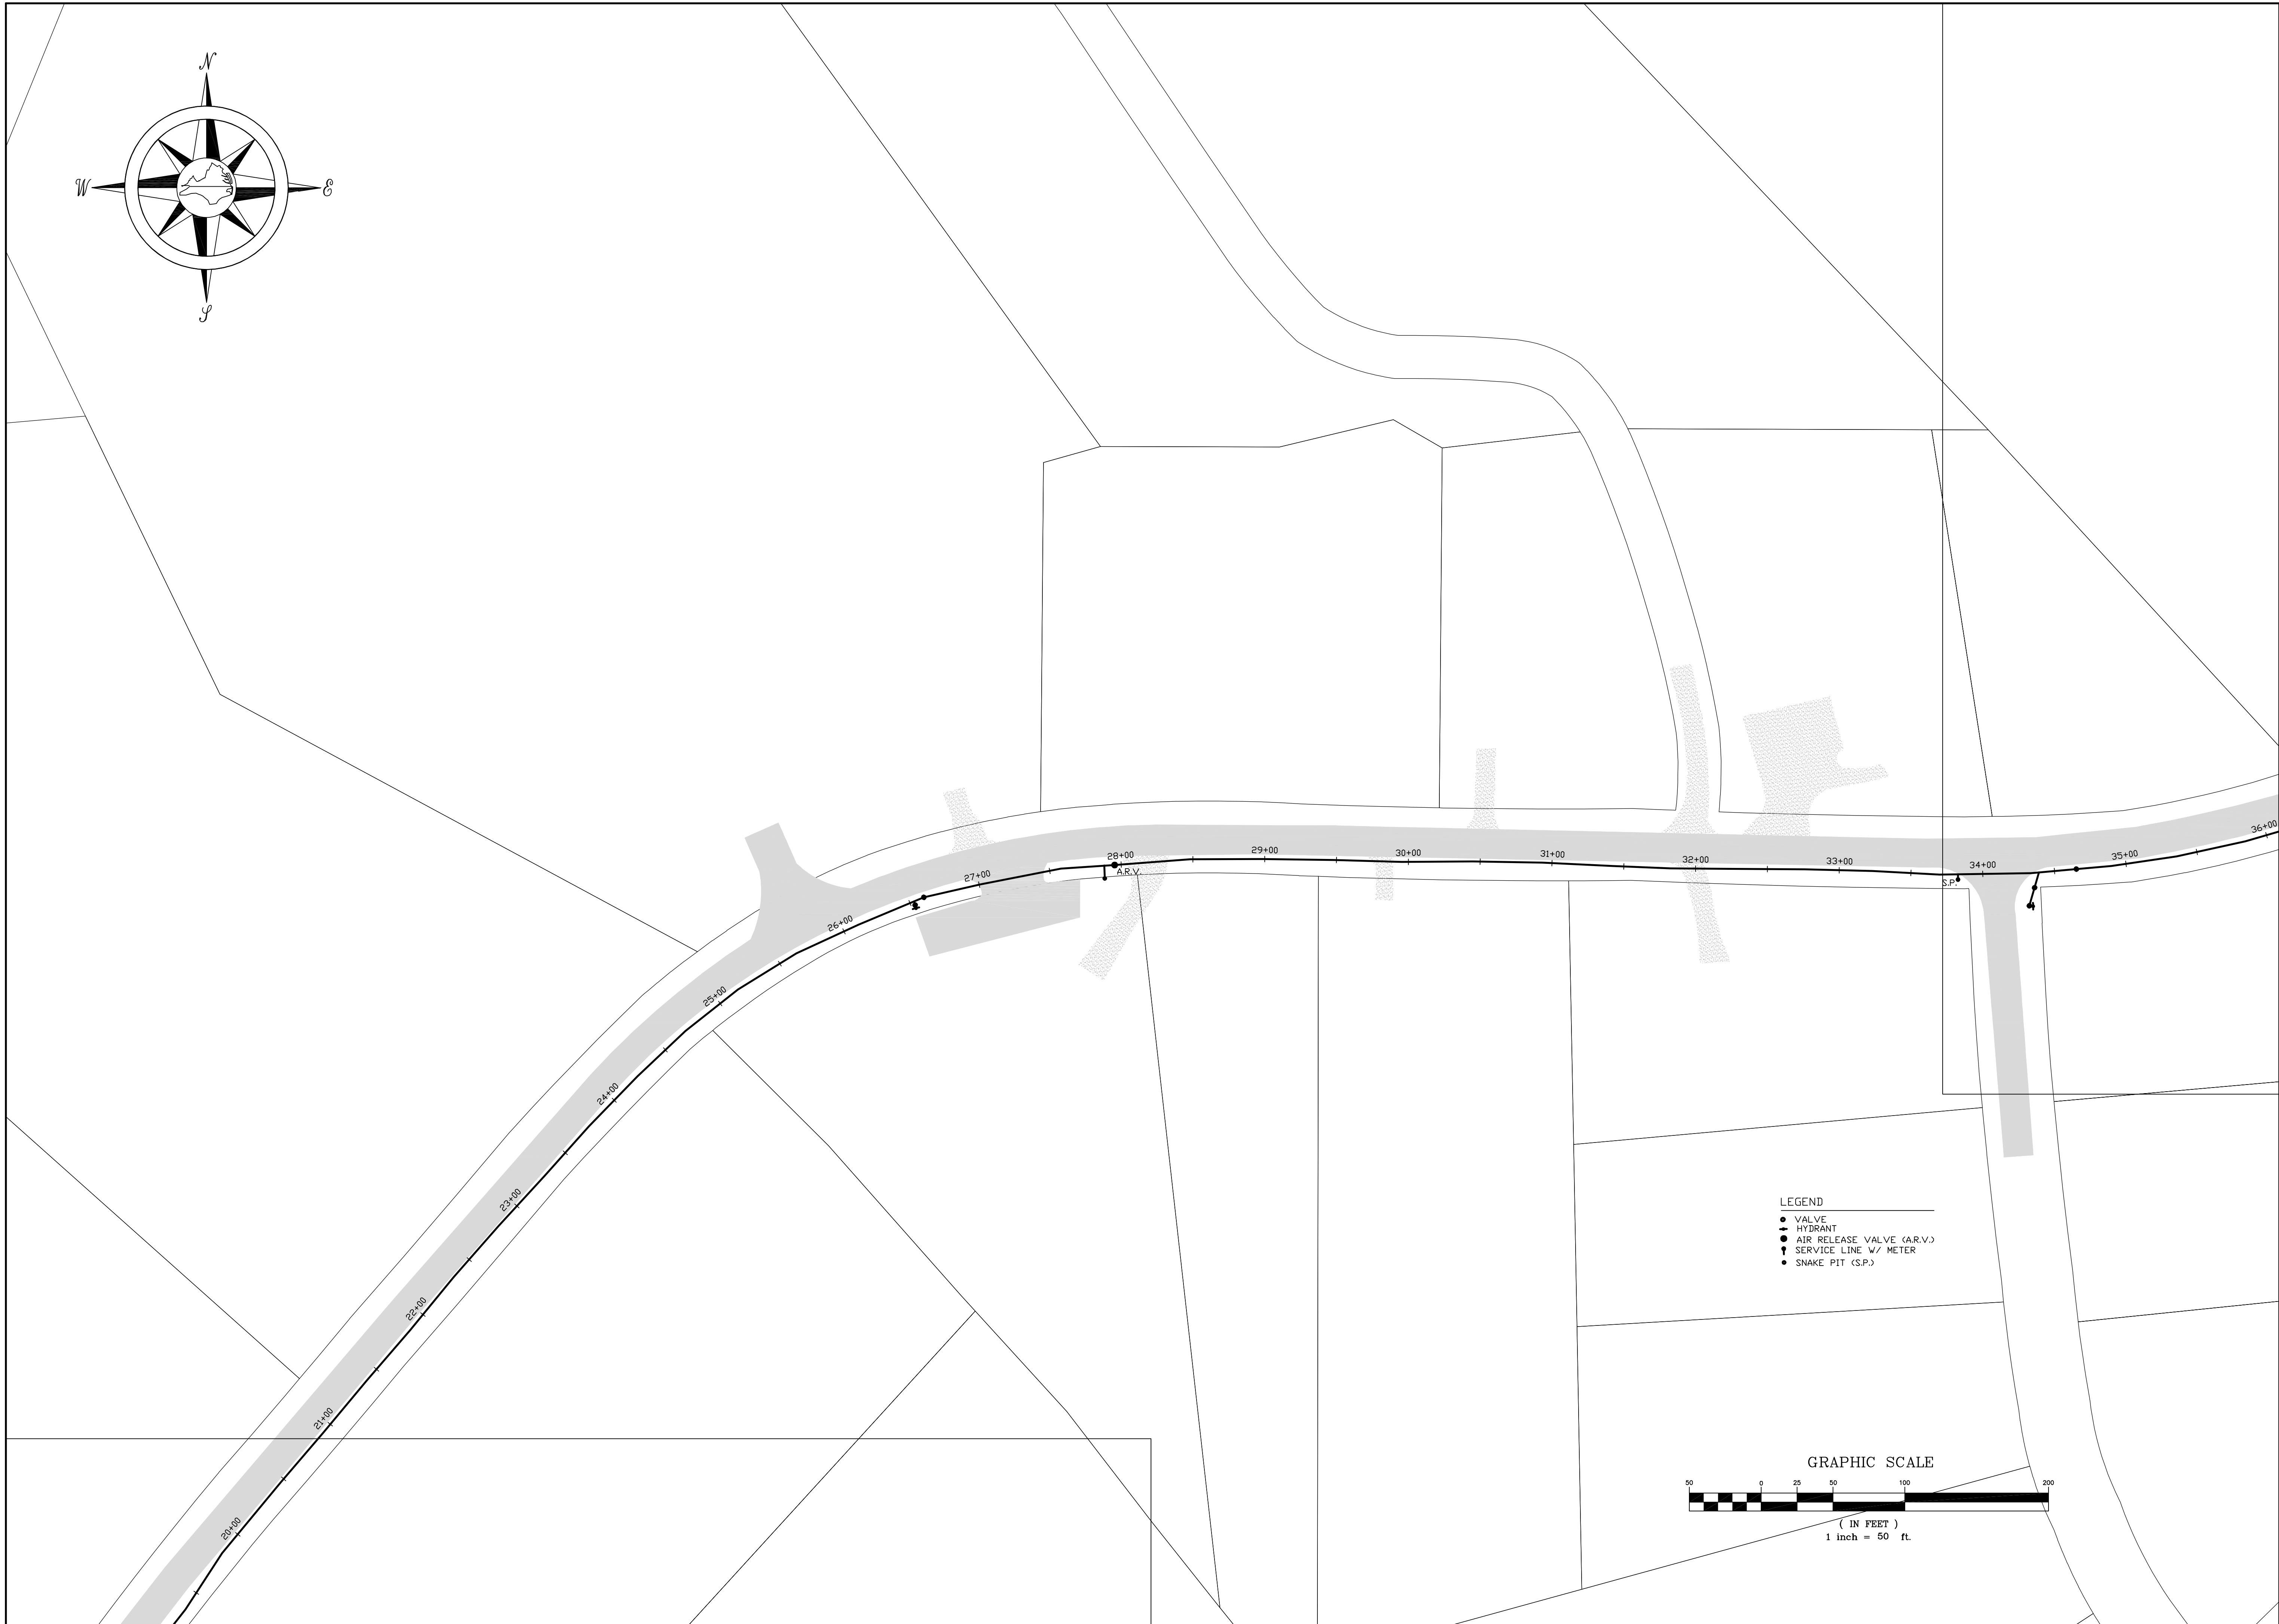


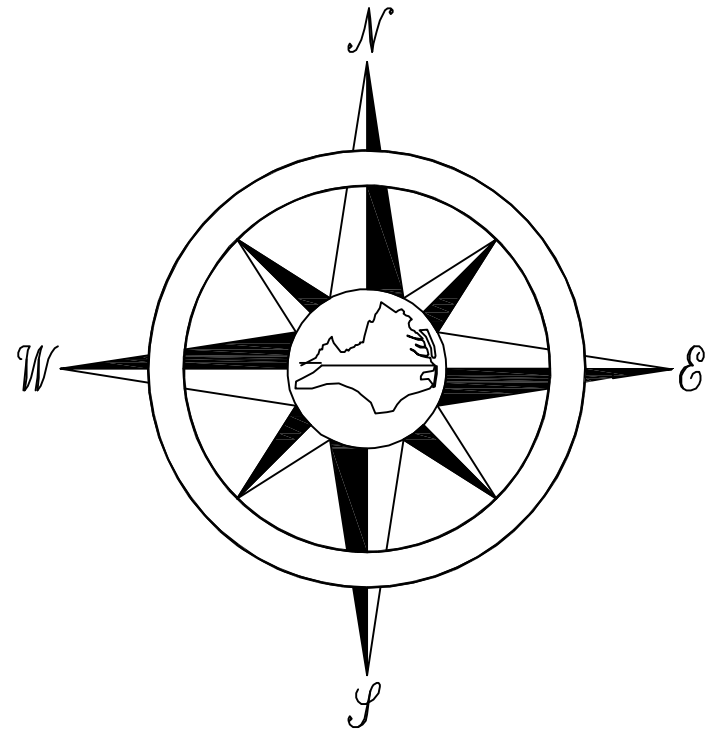


- LEGEND
- VALVE
 - HYDRANT
 - AIR RELEASE VALVE (A.R.V.)
 - SERVICE LINE W/ METER
 - SNAKE PIT (S.P.)

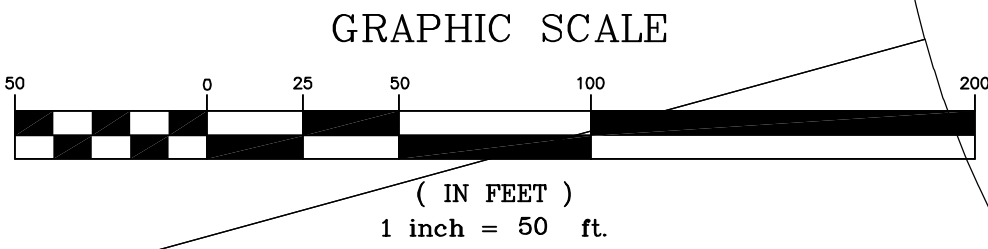

REVISIONS	
NO.	DATE DESCRIPTION

DATE 9/7/20	
----------------	--

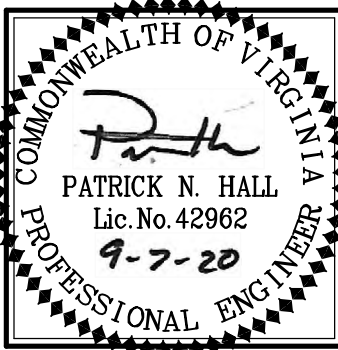

AS-BUILT SURVEY

LAKEWOOD FOREST & WEATHERWOOD INTERCONNECTION