



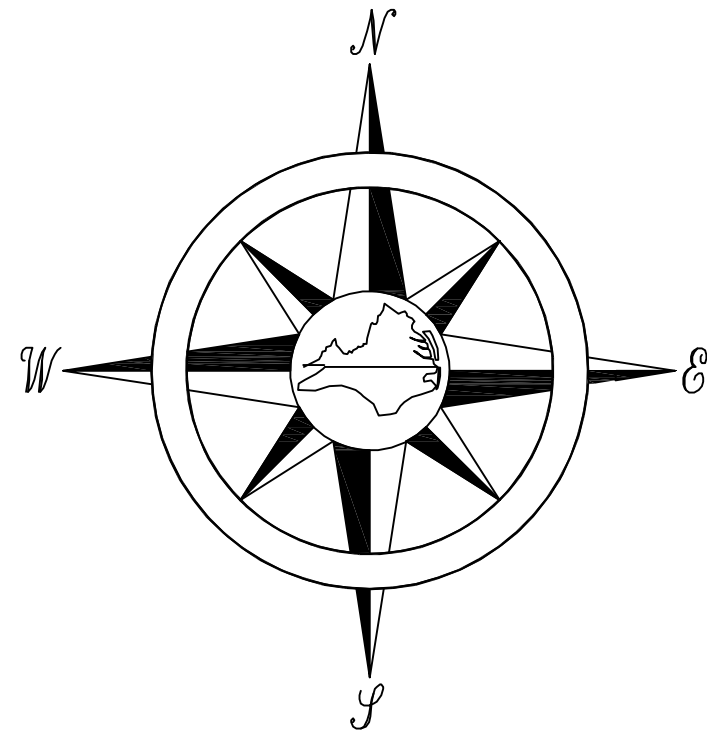

EX. MAG NAIL
N 3564125.5700
E 11133448.7700
ELEV 994.14

- LEGEND
- VALVE
 - HYDRANT
 - AIR RELEASE VALVE (A.R.V.)
 - ↑ SERVICE LINE W/ METER
 - SNAKE PIT (S.P.)

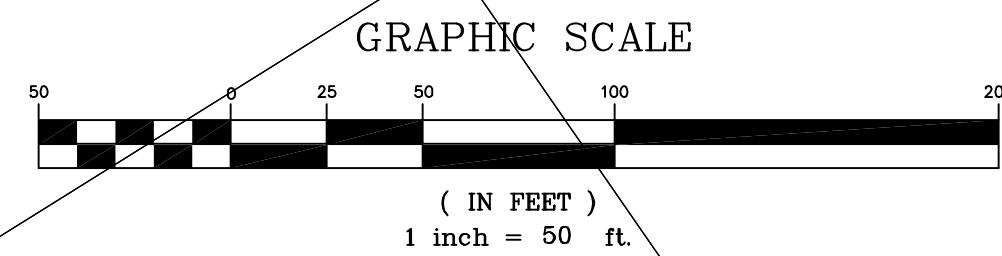

REVISIONS	
NO.	DESCRIPTION

DATE 9/7/20

