



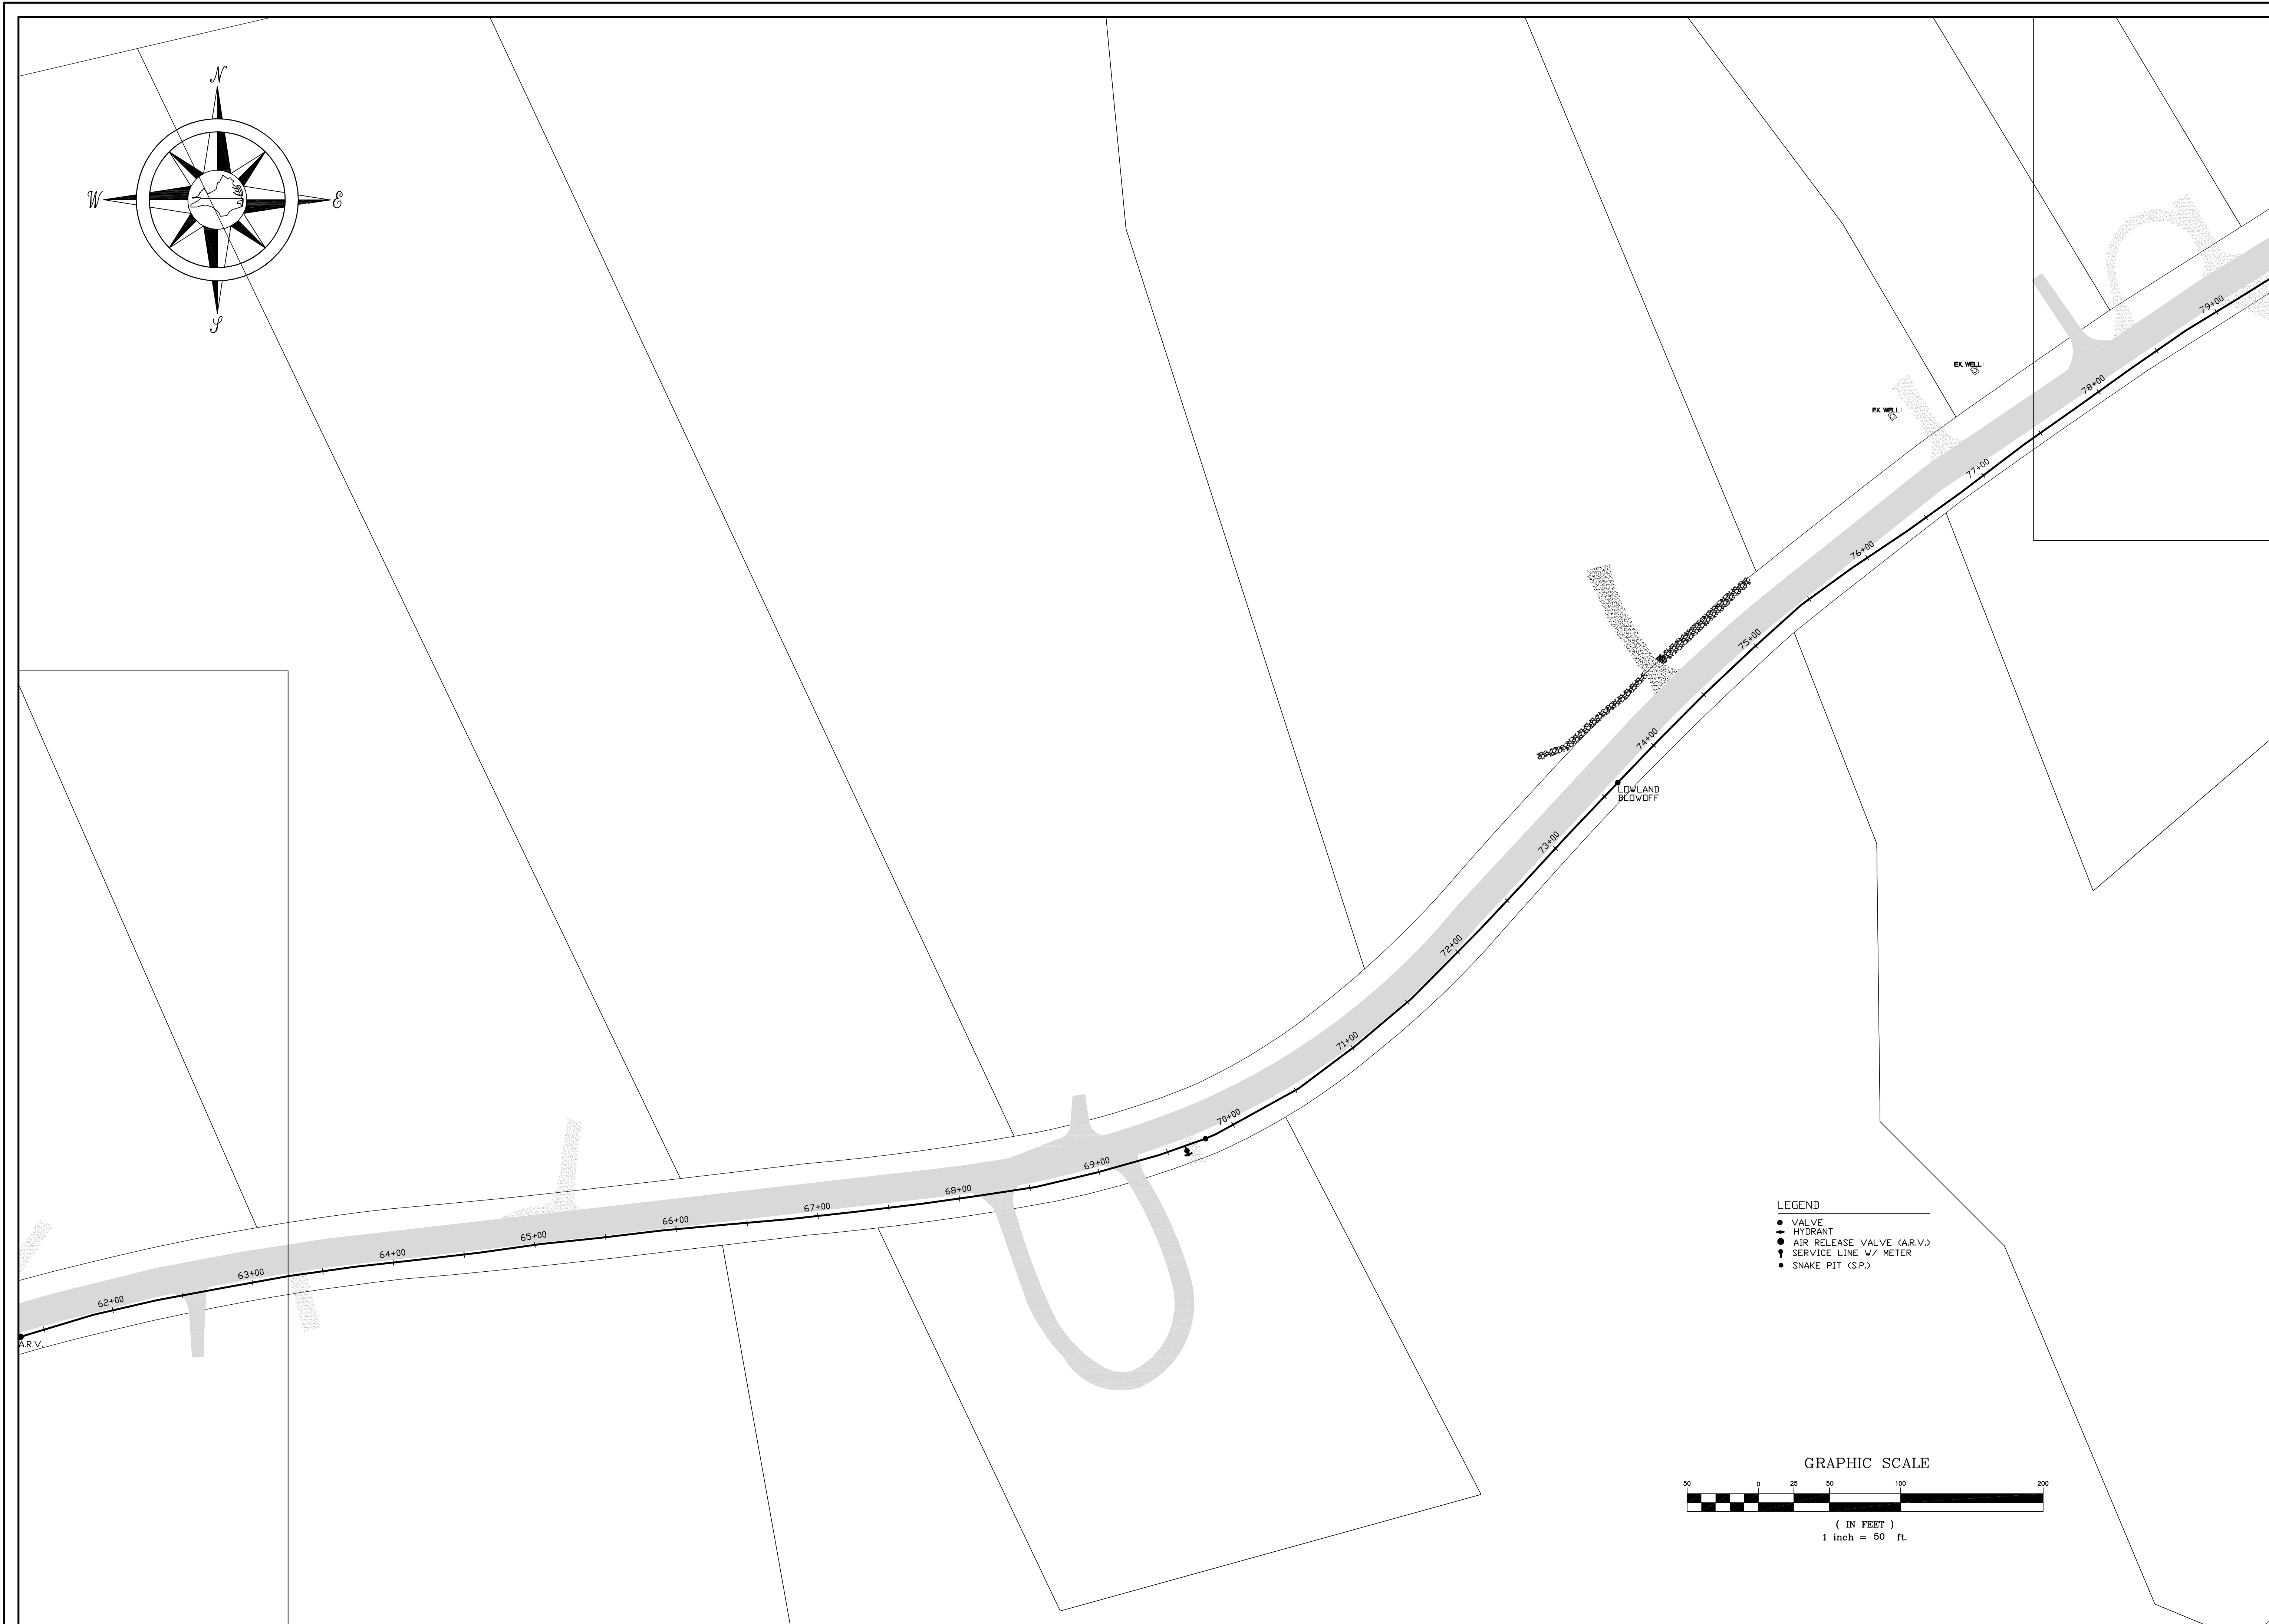


- VALVE
- ➔ HYDRANT
- AIR RELEASE VALVE (A.R.V.)
- ⌚ SERVICE LINE W/ METER
- SNAKE PIT (S.P.)

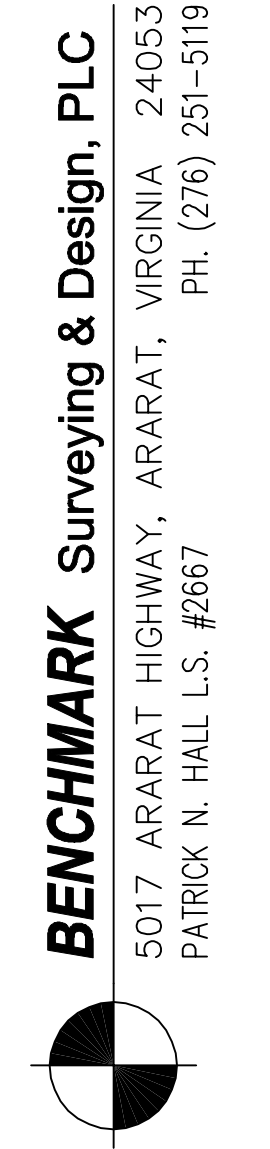

BENCHMARK Surveying & Design, PLC
5017 ARARAT HIGHWAY, ARARAT, VIRGINIA 24053
PATRICK N. HALL L.S. #2667 PH. (276) 251-5119

DATE 9/7/20

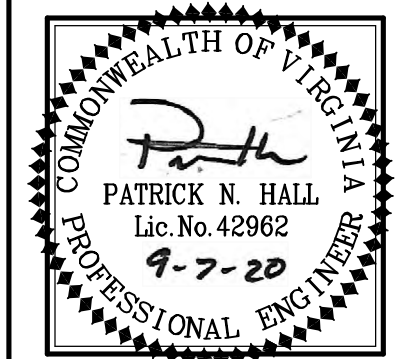

AS-BUILT SURVEY

LAKewood FOREST & WEATHERWOOD INTERCONNECTION

C-5
SHEET 5 of 13