



- LEGEND
- VALVE
 - HYDRANT
 - AIR-RELEASE VALVE (A.R.V.)
 - SERVICE LINE W/ METER
 - SNAKE PIT (S.P.)

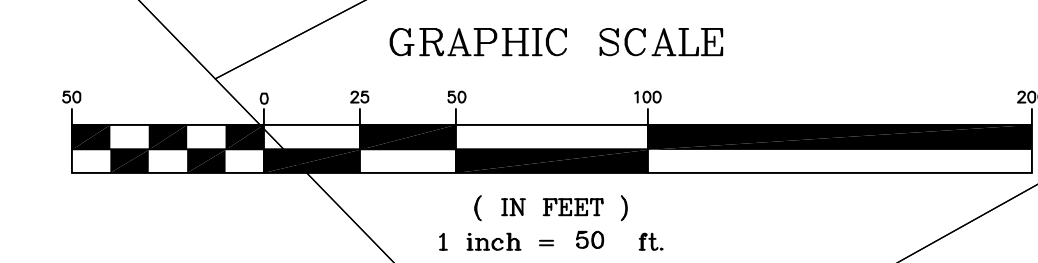

BENCHMARK Surveying & Design, PLC
 5017 ARARAT HIGHWAY, ARARAT, VIRGINIA 24053
 PATRICK N. HALL L.S. #2667

NO.	DATE	DESCRIPTION

DATE	
9/7/20	

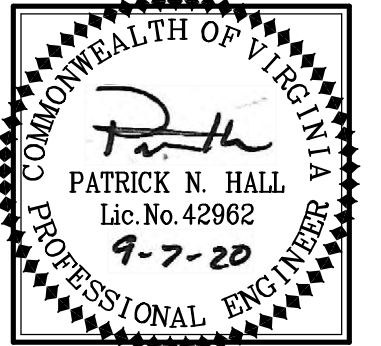

AS-BUILT SURVEY
LAKWOOD FOREST & WEATHERWOOD INTERCONNECTION