

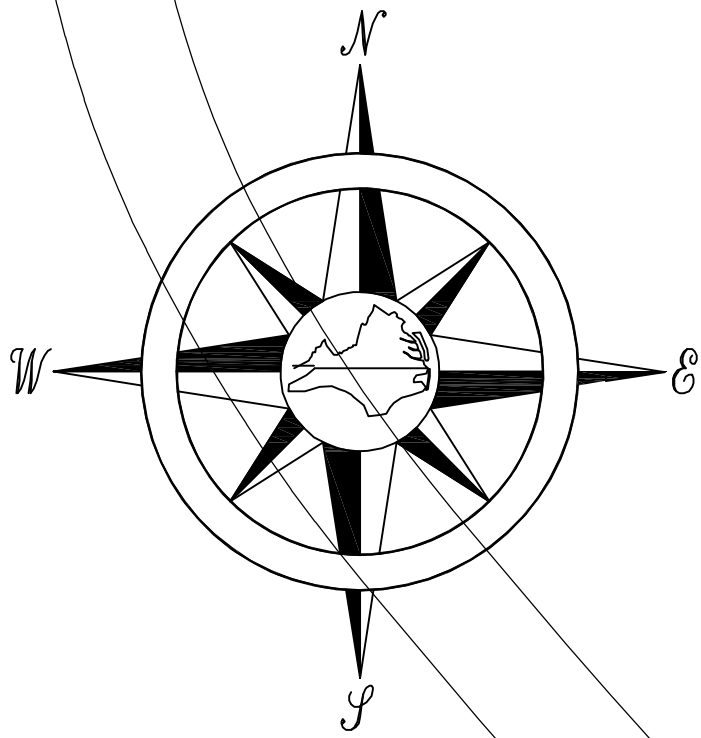


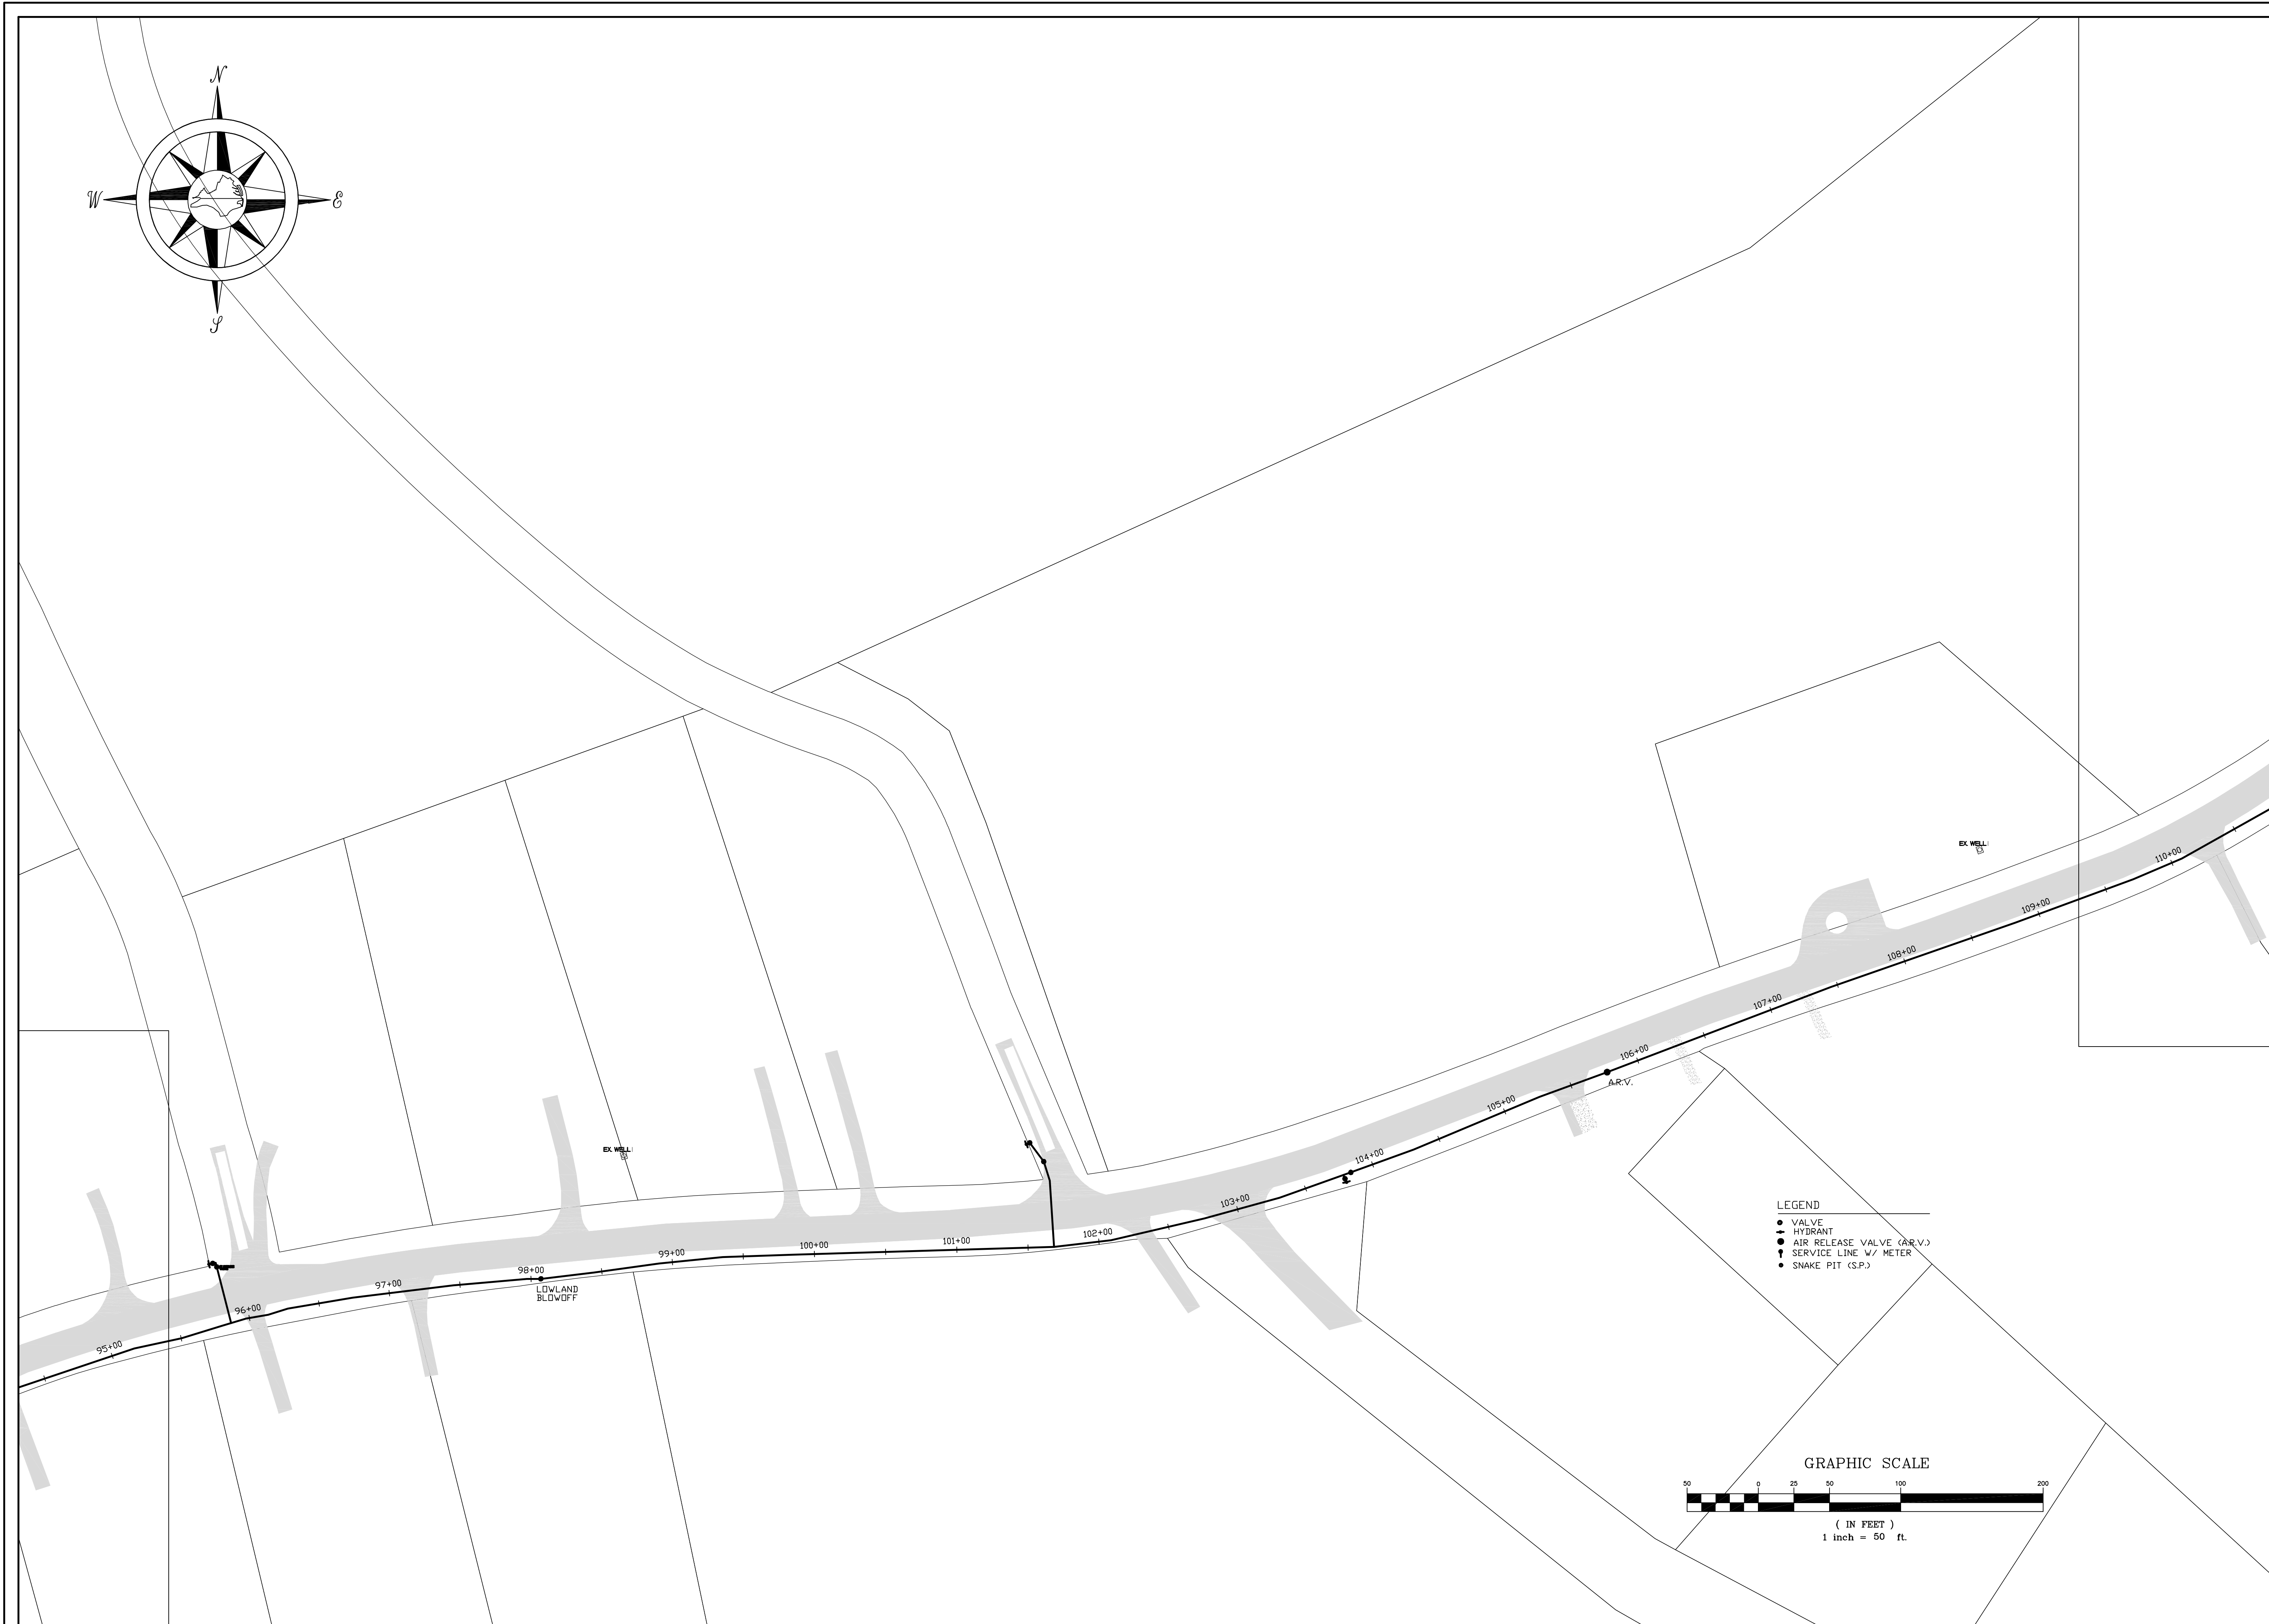


- LEGEND
- VALVE
  - HYDRANT
  - AIR RELEASE VALVE (A.R.V.)
  - SERVICE LINE W/ METER
  - SNAKE PIT (S.P.)

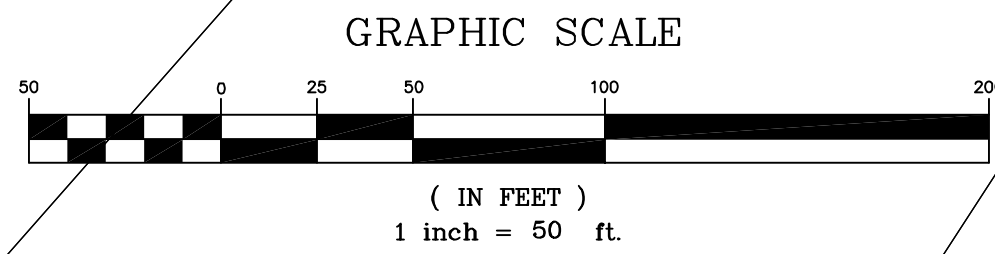

| REVISIONS |             |
|-----------|-------------|
| NO.       | DESCRIPTION |
|           |             |

|                |  |
|----------------|--|
| DATE<br>9/7/20 |  |
|----------------|--|

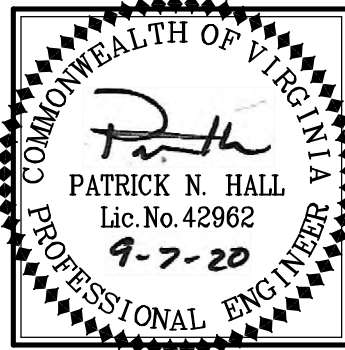

AS-BUILT SURVEY

**LAKWOOD FOREST & WEATHERWOOD INTERCONNECTION**