

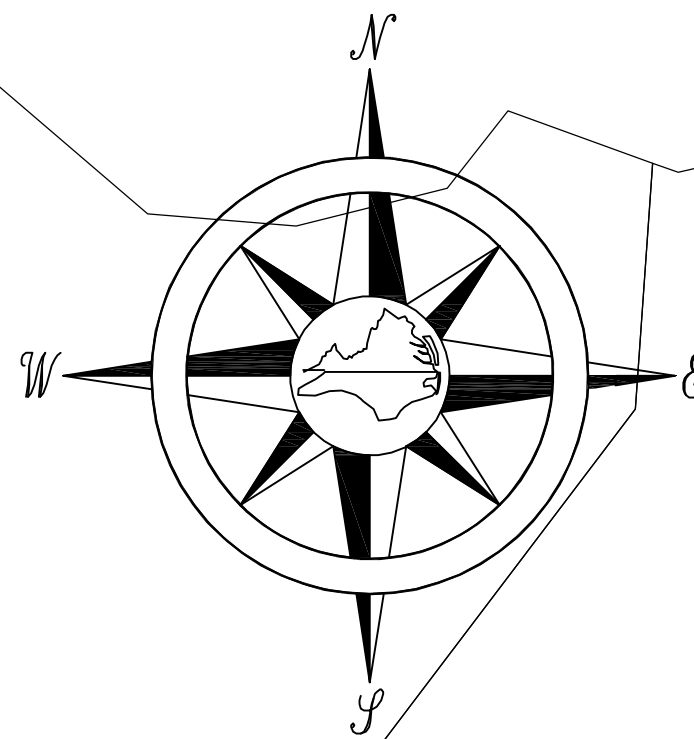


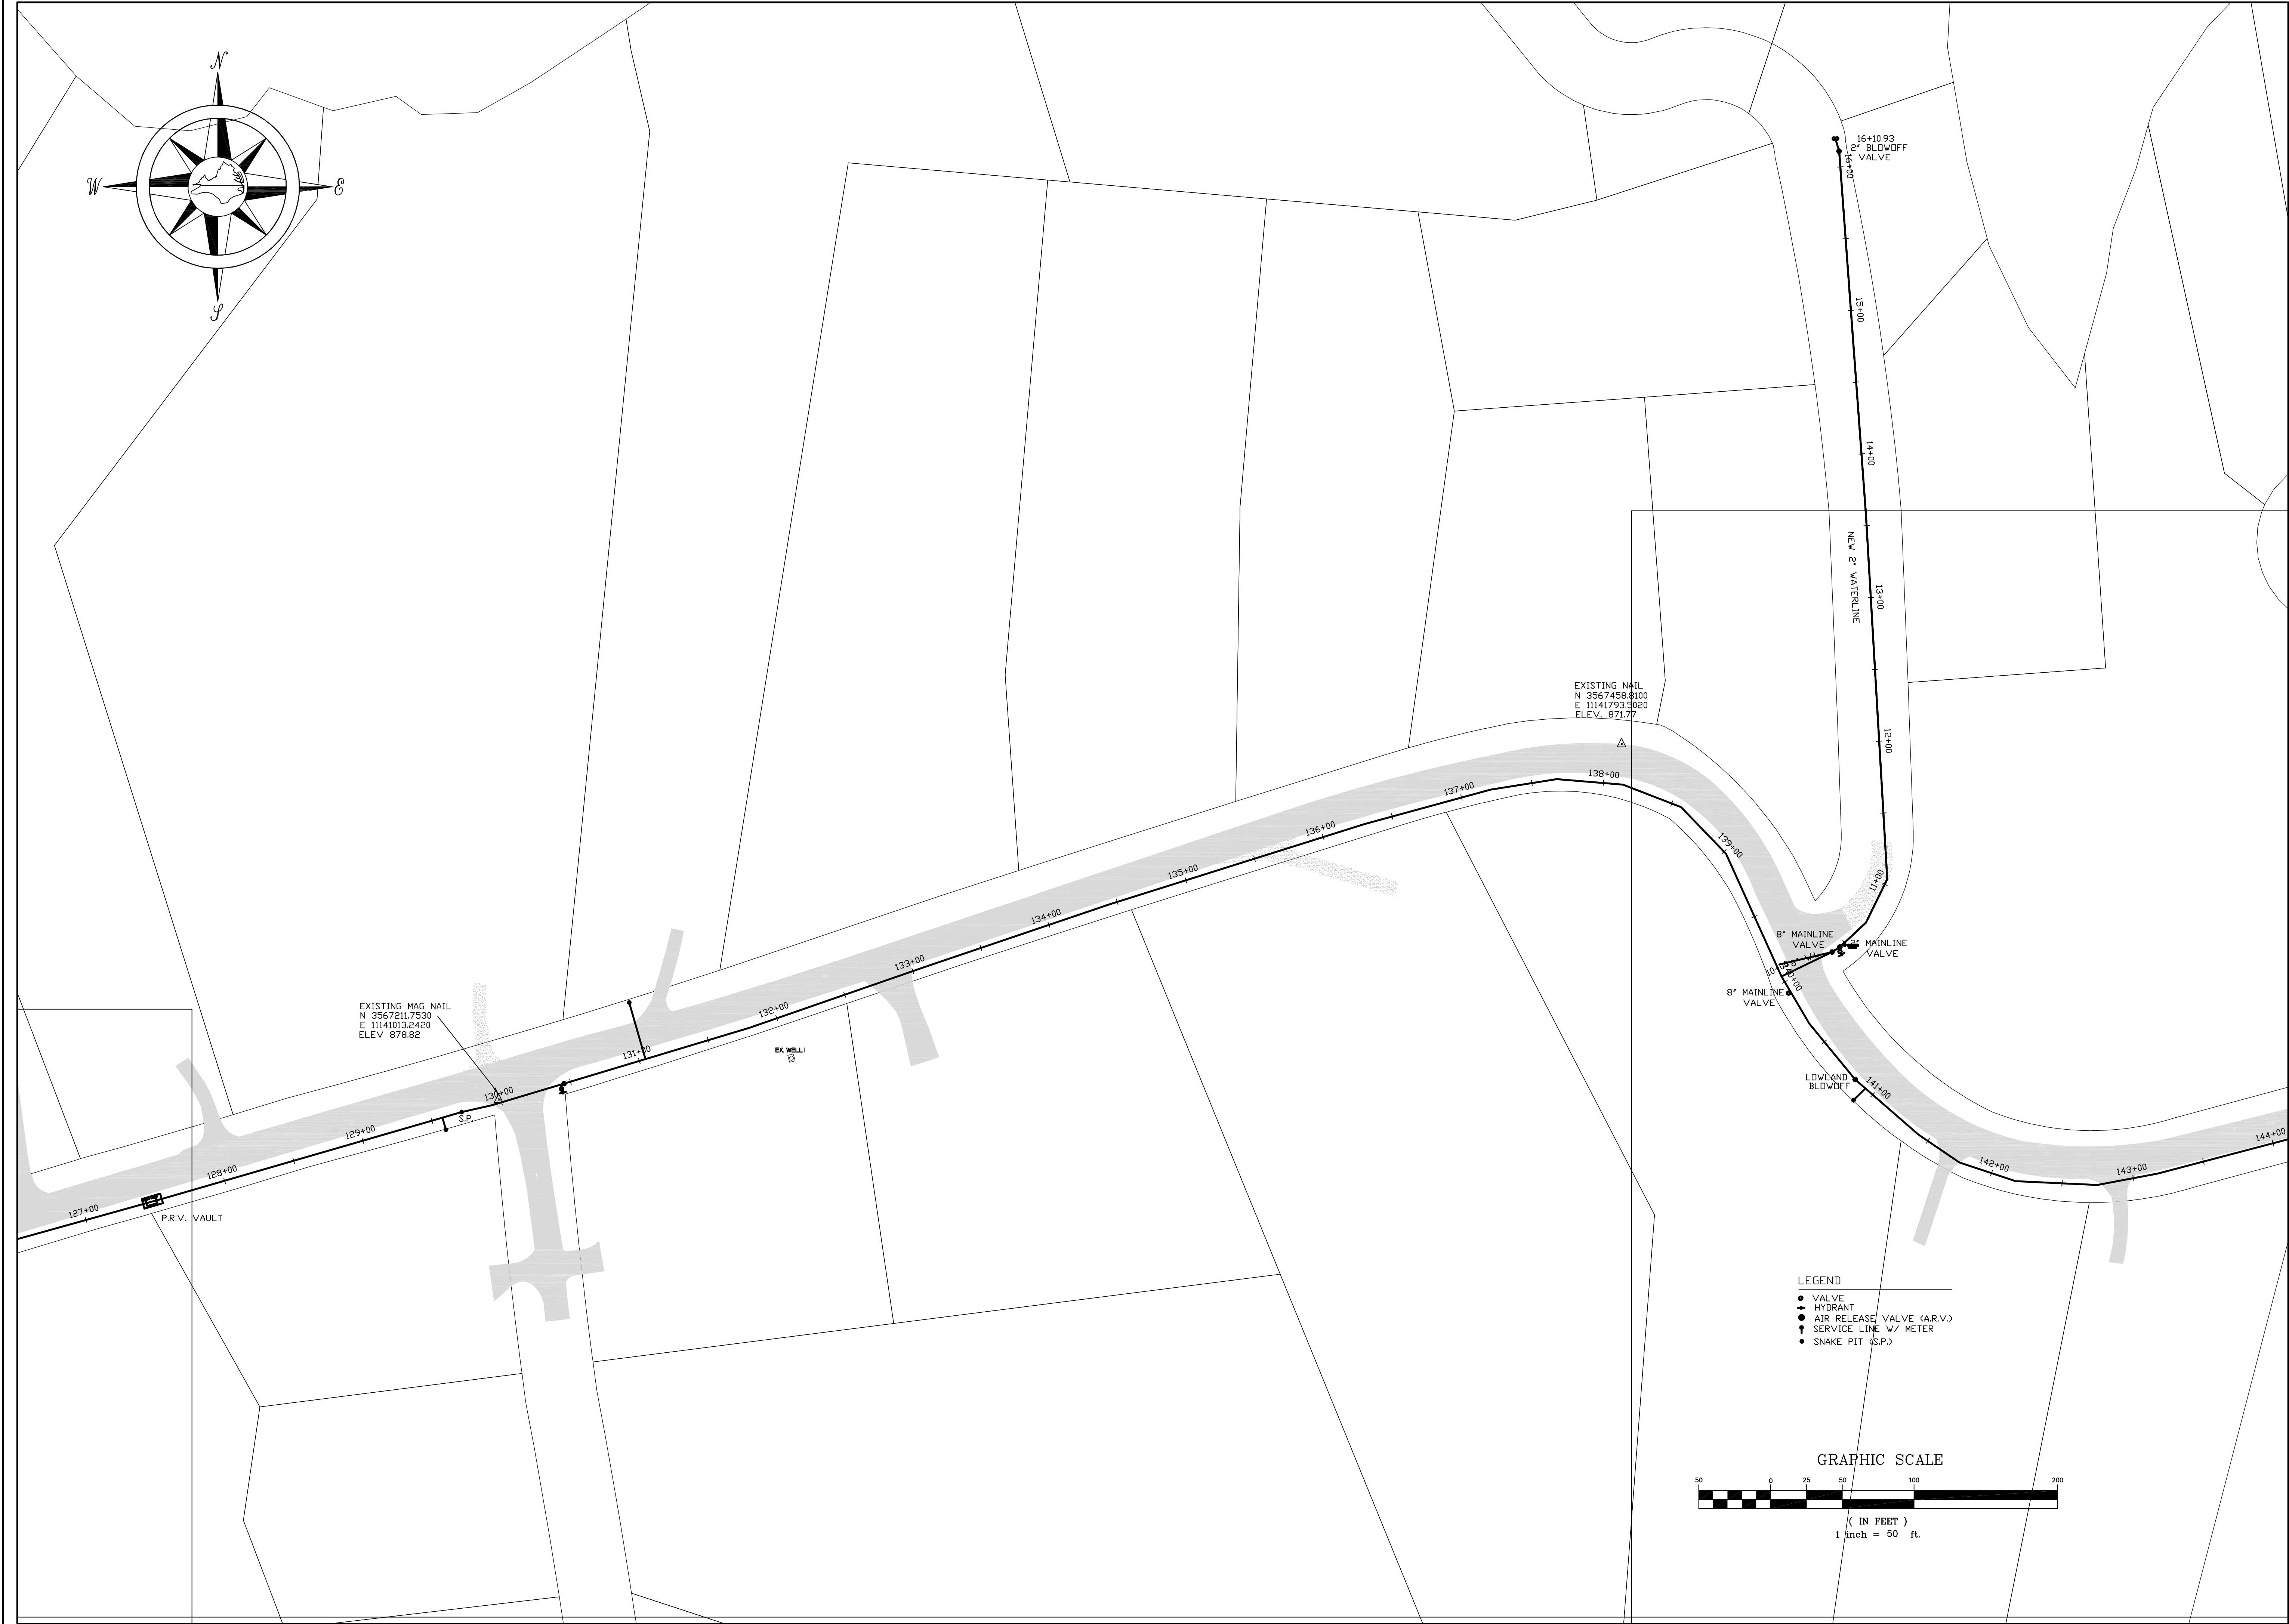

EXISTING MAG NAIL
N 3567211.7530
E 11141013.2420
ELEV. 878.82


EXISTING NAIL
N 3567458.8100
E 11141793.5020
ELEV. 871.77

- LEGEND
- VALVE
 - HYDRANT
 - AIR RELEASE VALVE (A.R.V.)
 - SERVICE LINE W/ METER
 - SNAKE PIT (S.P.)

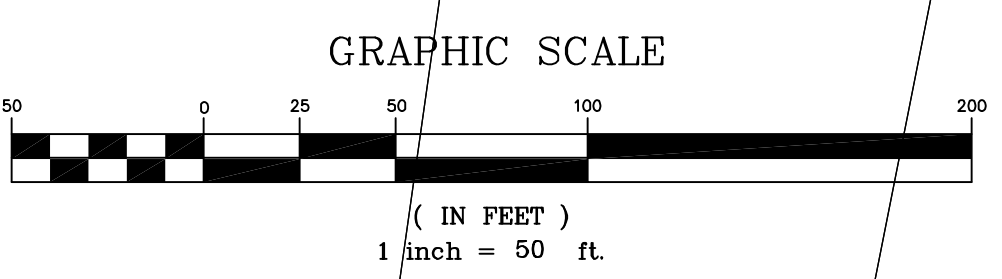

REVISIONS	
NO.	DATE

DATE 9/7/20

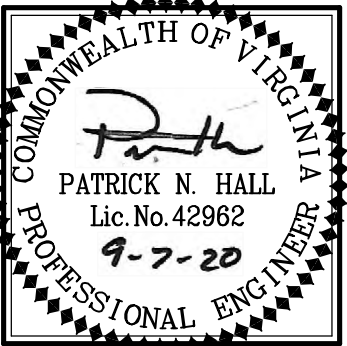

AS-BUILT SURVEY

LAKEWOOD FOREST & WEATHERWOOD INTERCONNECTION