

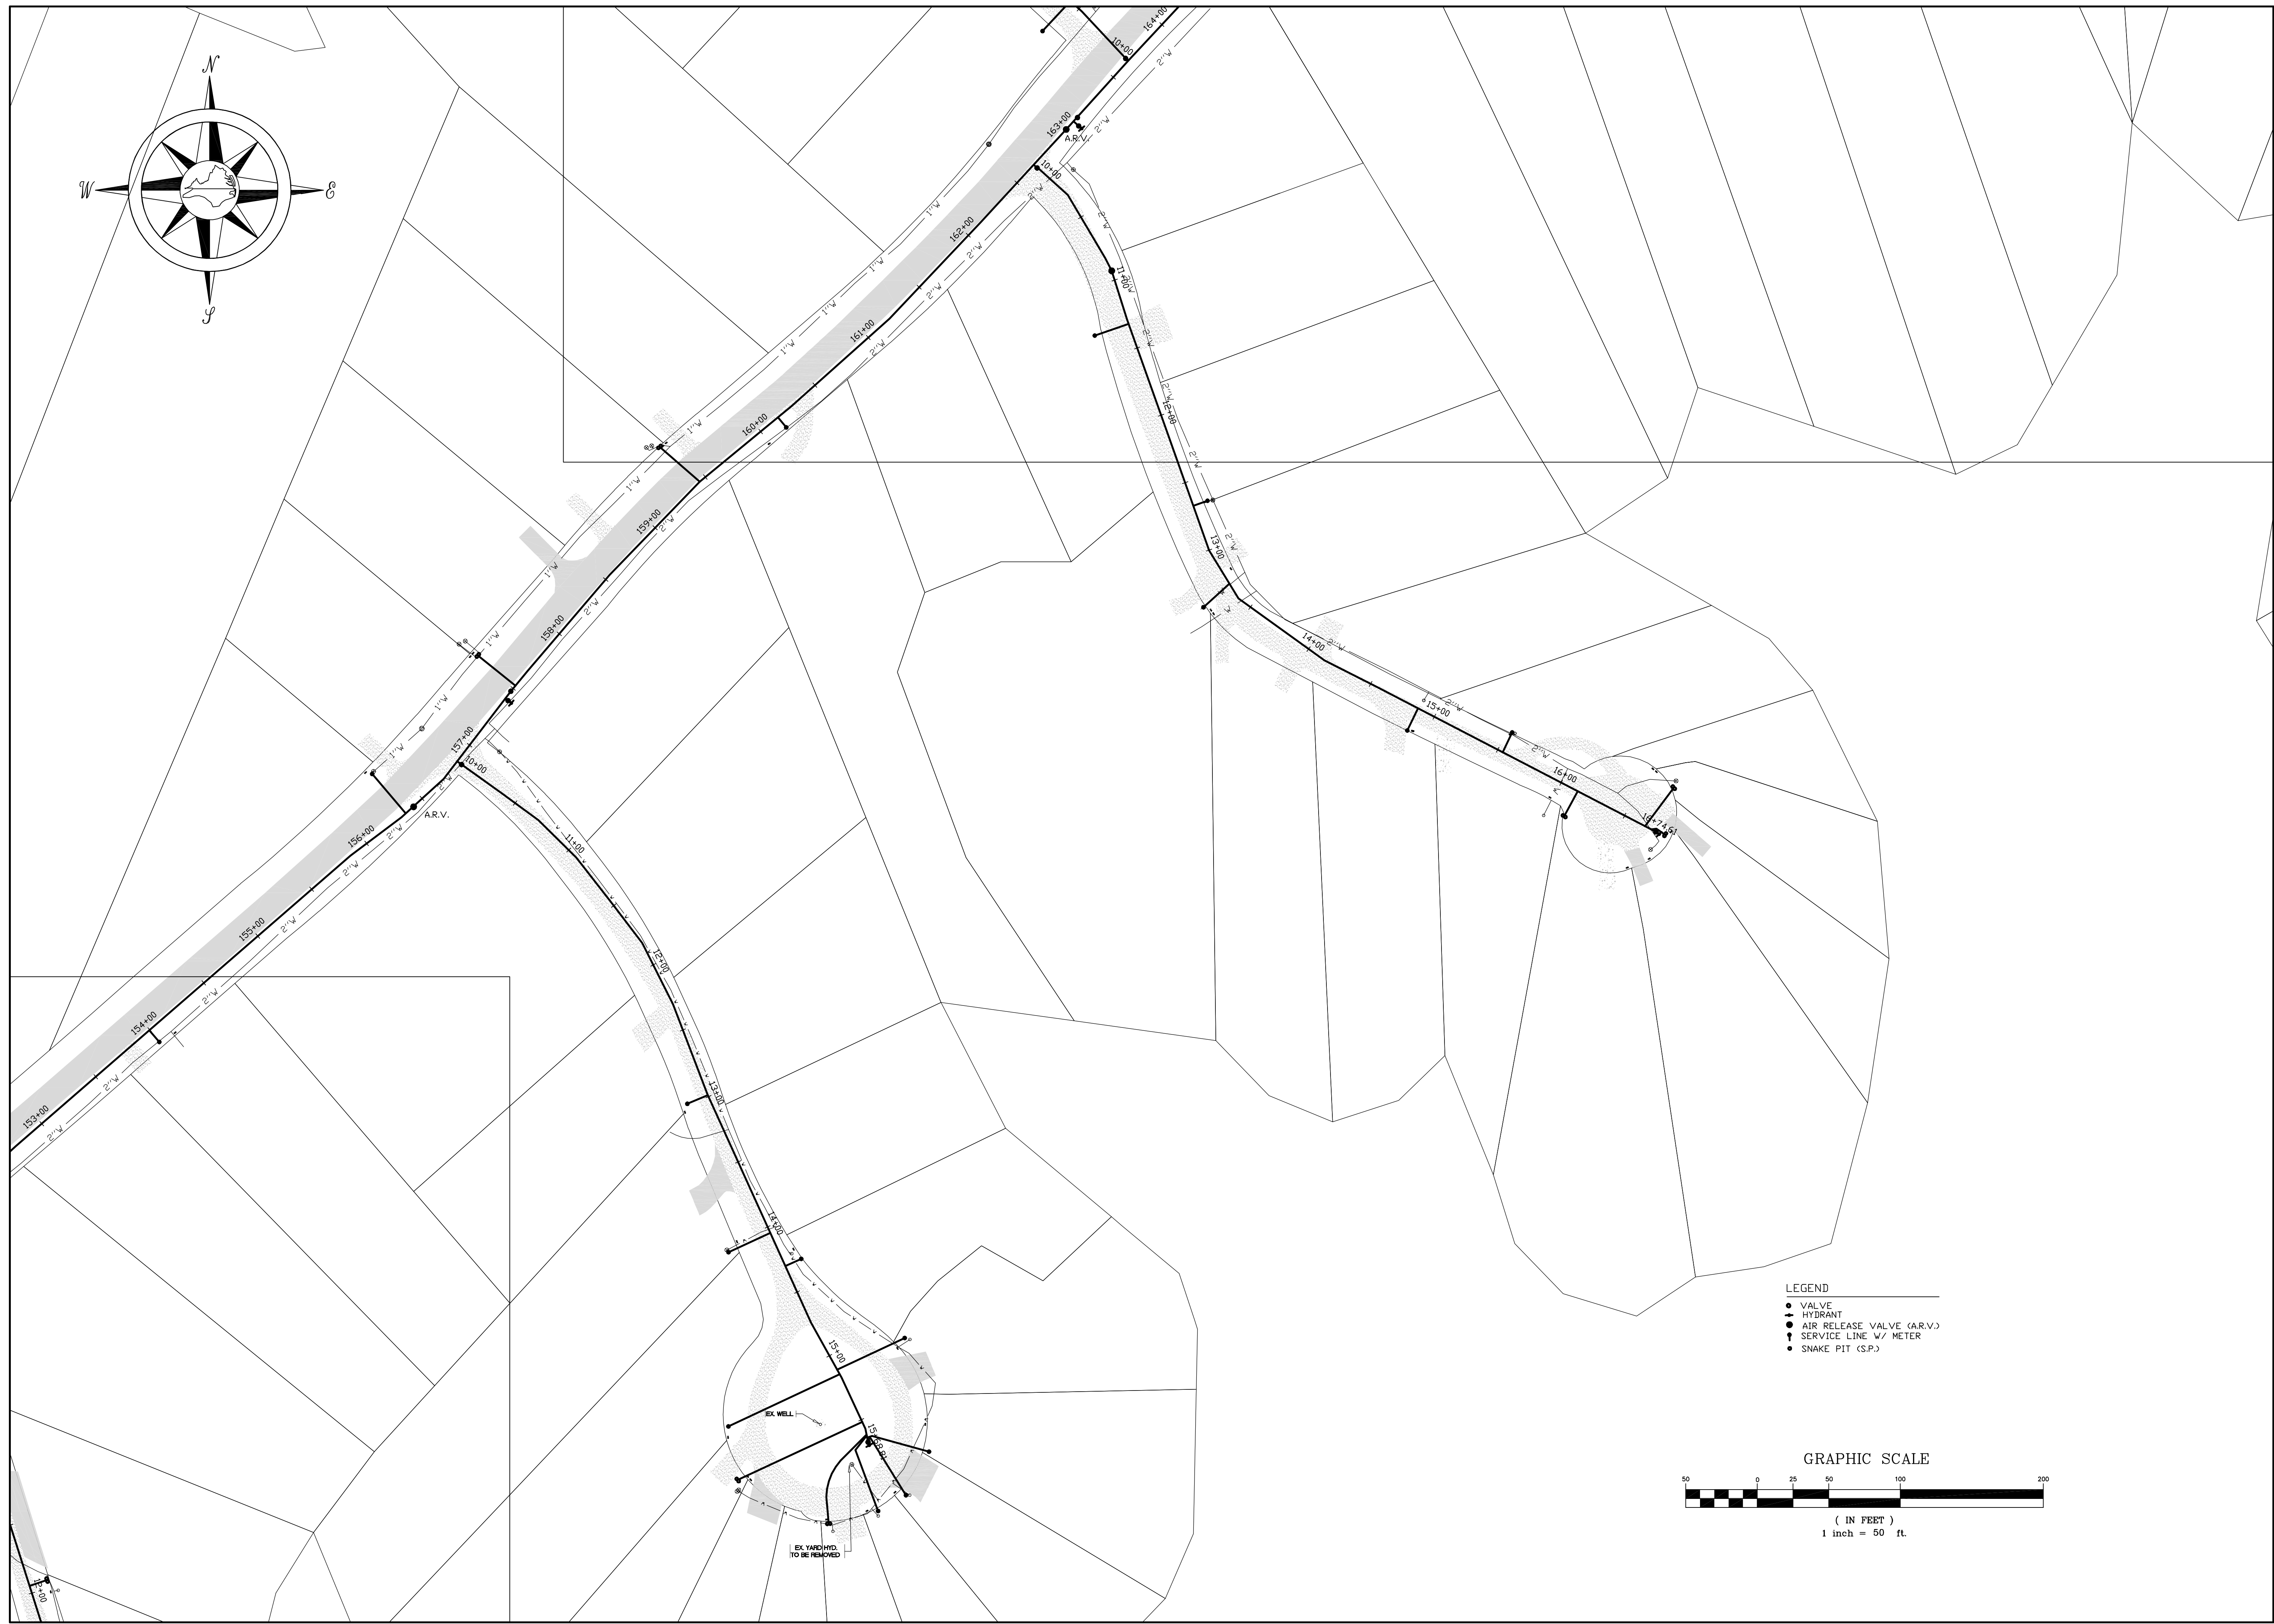


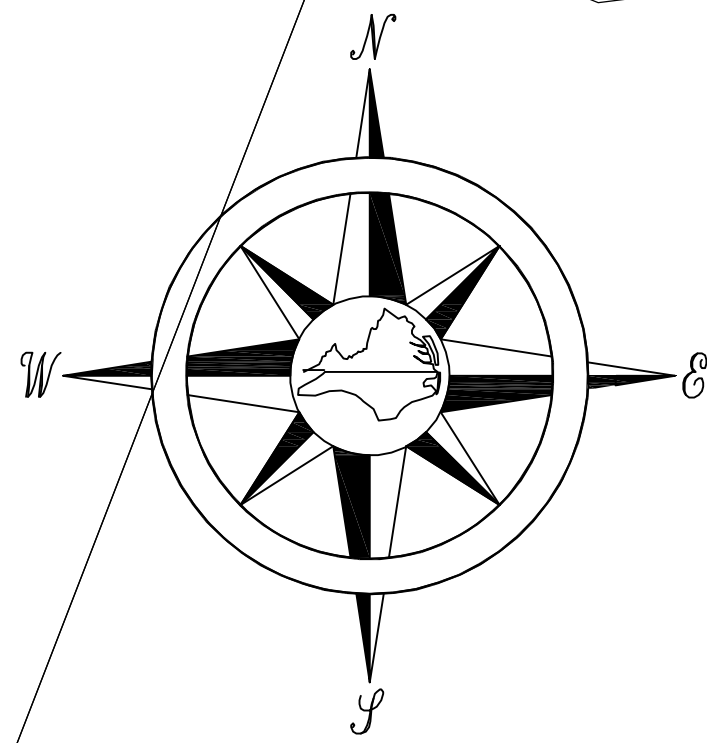


- LEGEND
- VALVE
 - HYDRANT
 - AIR RELEASE VALVE (A.R.V.)
 - ↑ SERVICE LINE W/ METER
 - SNAKE PIT (S.P.)

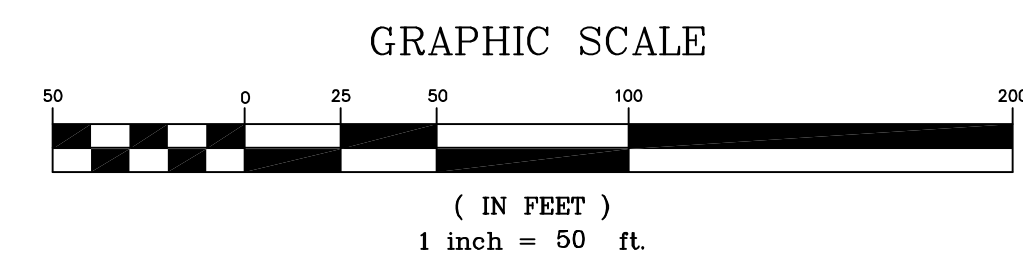

REVISIONS	
NO.	DATE DESCRIPTION

DATE	
9/7/20	

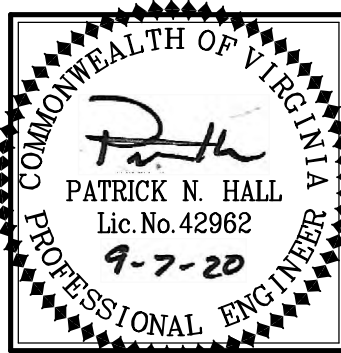

AS-BUILT SURVEY

LAKEWOOD FOREST & WEATHERWOOD INTERCONNECTION