

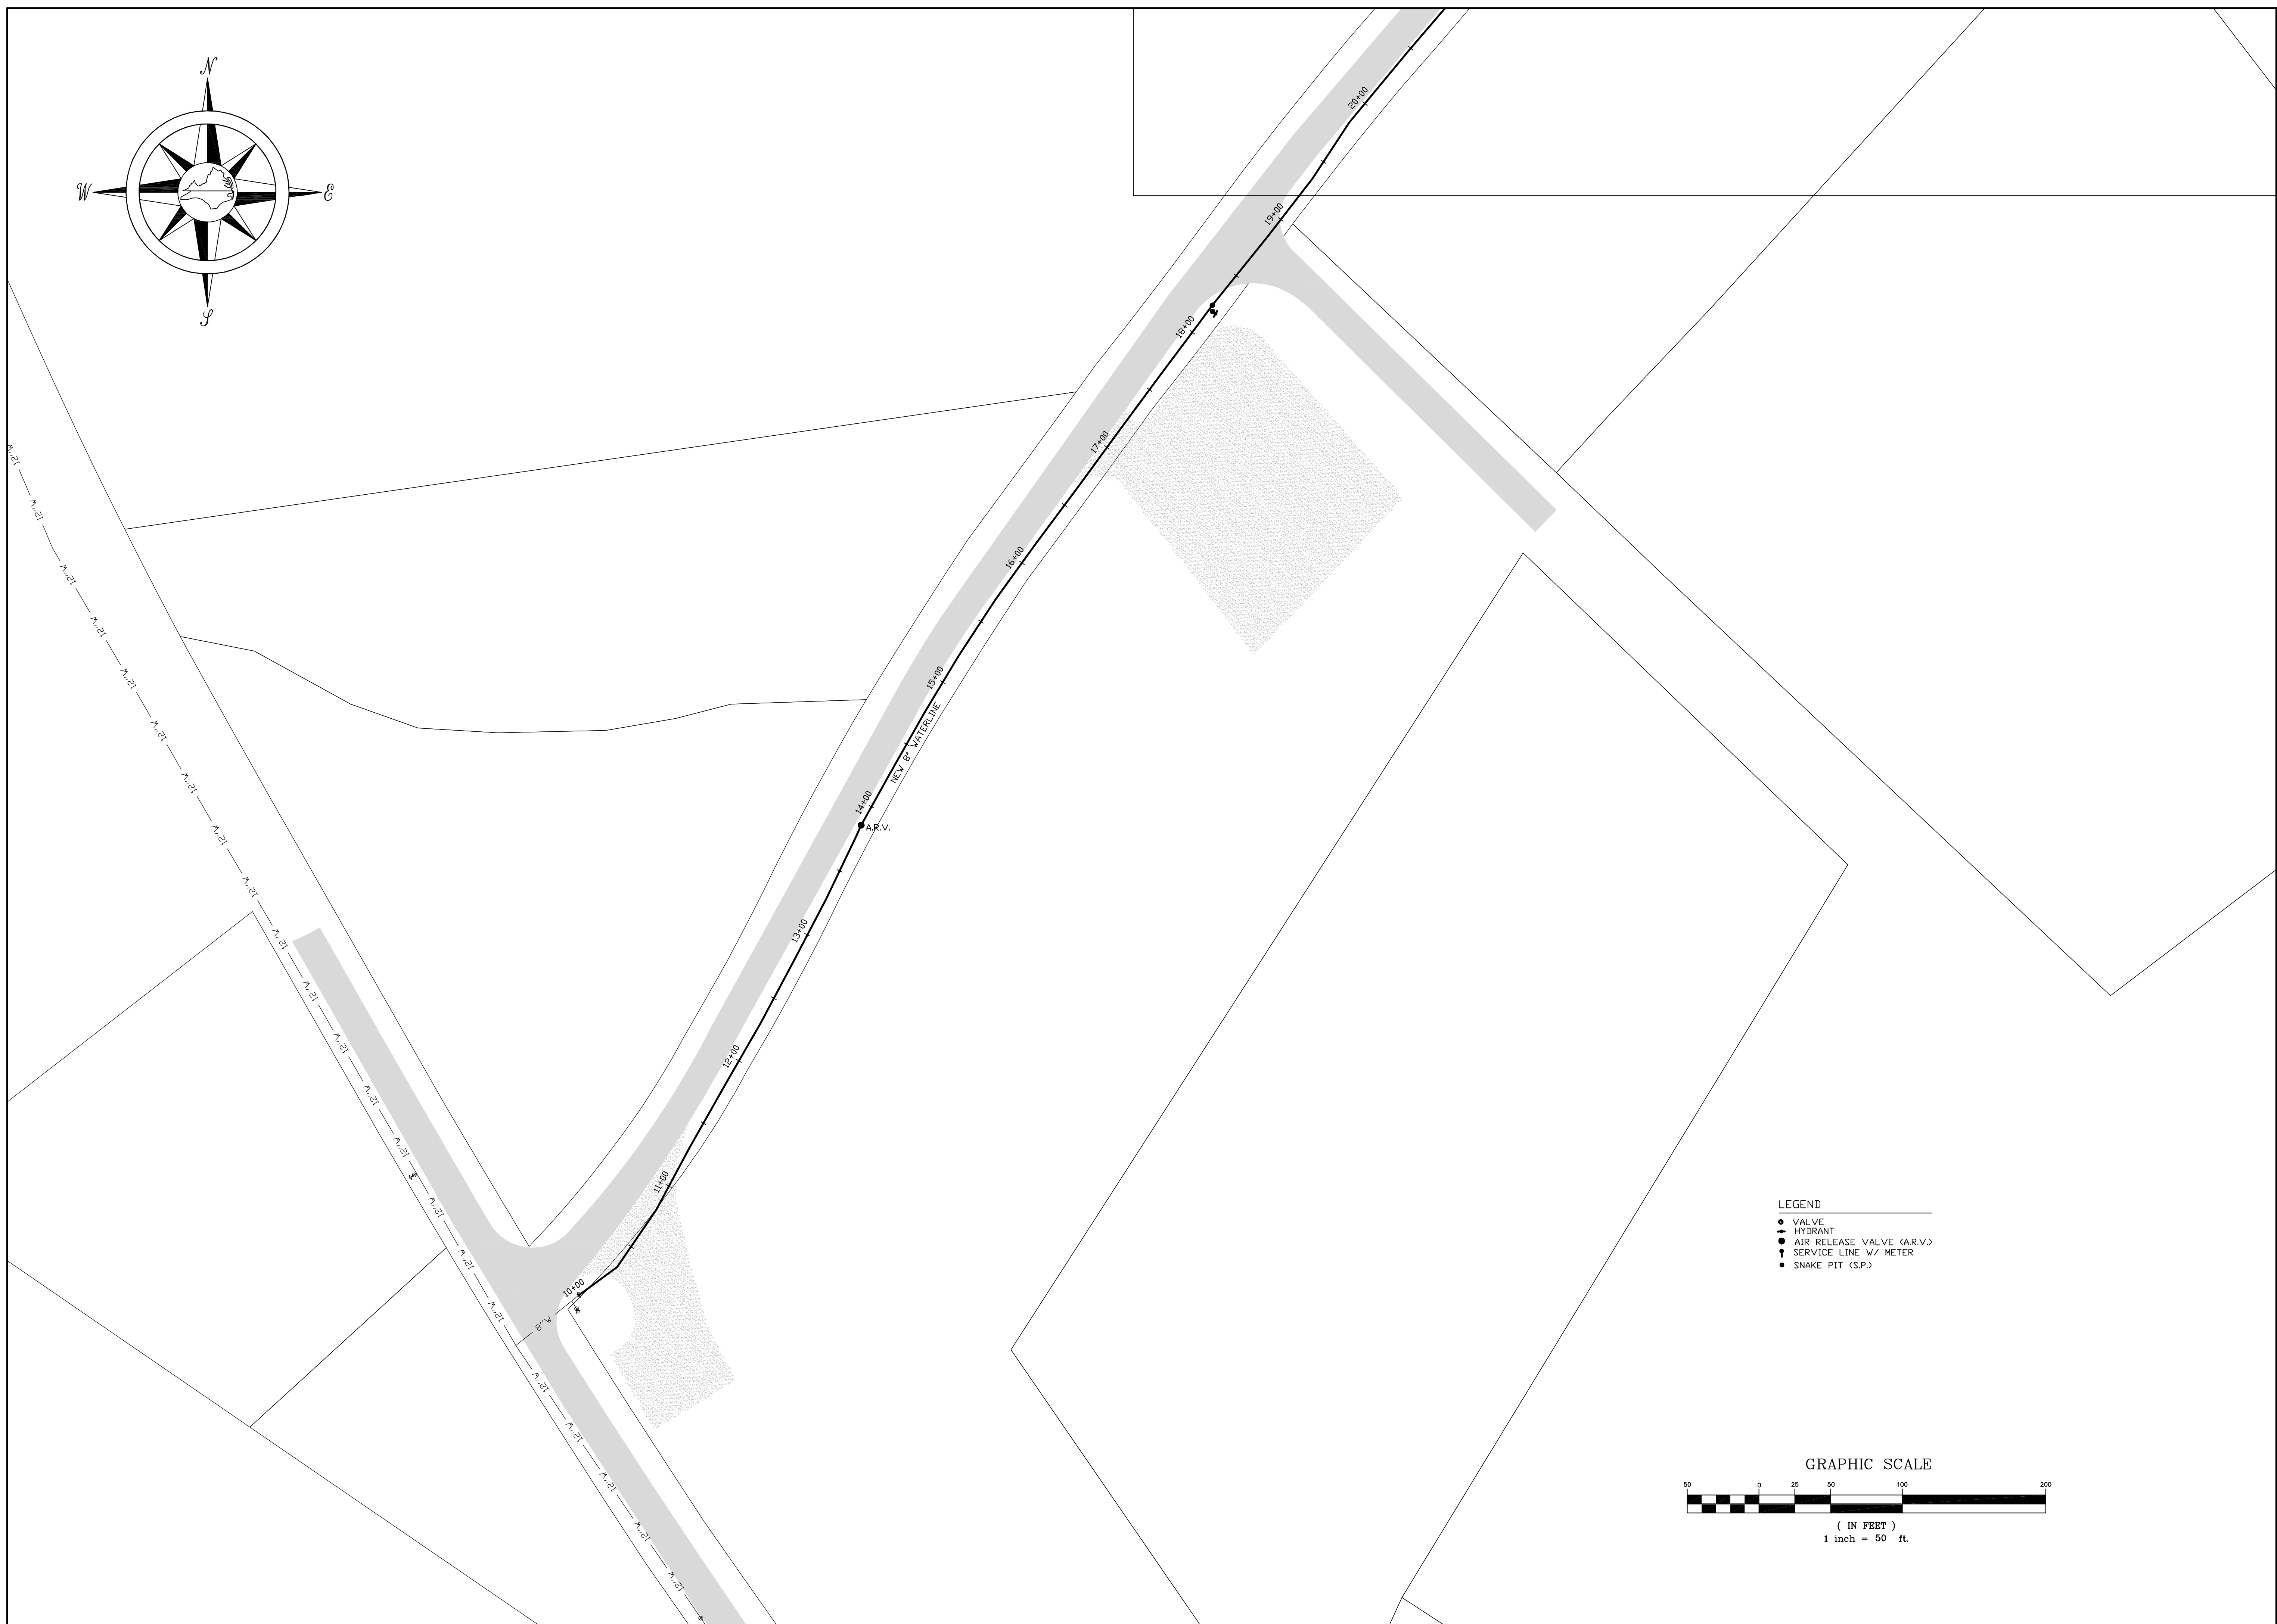


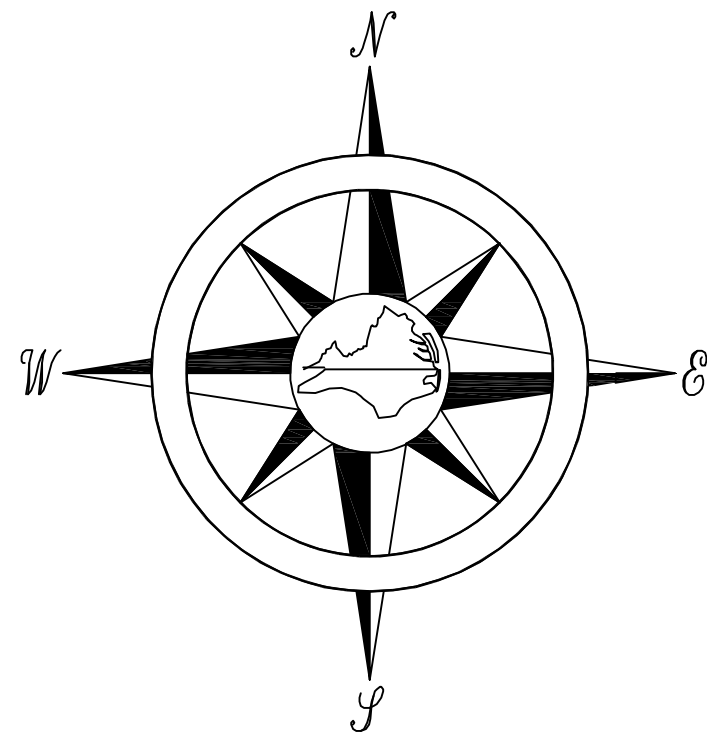


- LEGEND
- VALVE
 - HYDRANT
 - AIR RELEASE VALVE (A.R.V.)
 - SERVICE LINE W/ METER
 - SNAKE PIT (S.P.)

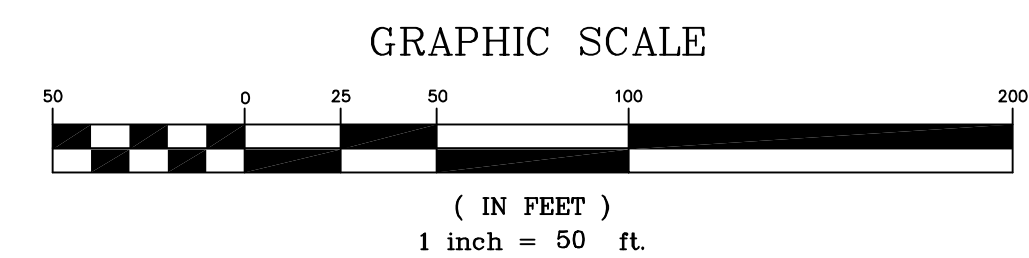

BENCHMARK Surveying & Design, PLC
5017 ARARAT HIGHWAY, ARARAT, VIRGINIA 24053
PATRICK N. HALL L.S. #2667 PH. (276) 251-5119



REVISIONS	
NO.	DATE DESCRIPTION

DATE	
9/07/20	

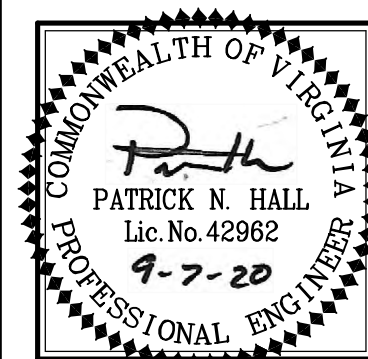


AS-BUILT SURVEY
LAKEWOOD FOREST & WEATHERWOOD INTERCONNECTION

C-1
SHEET 1 of 13

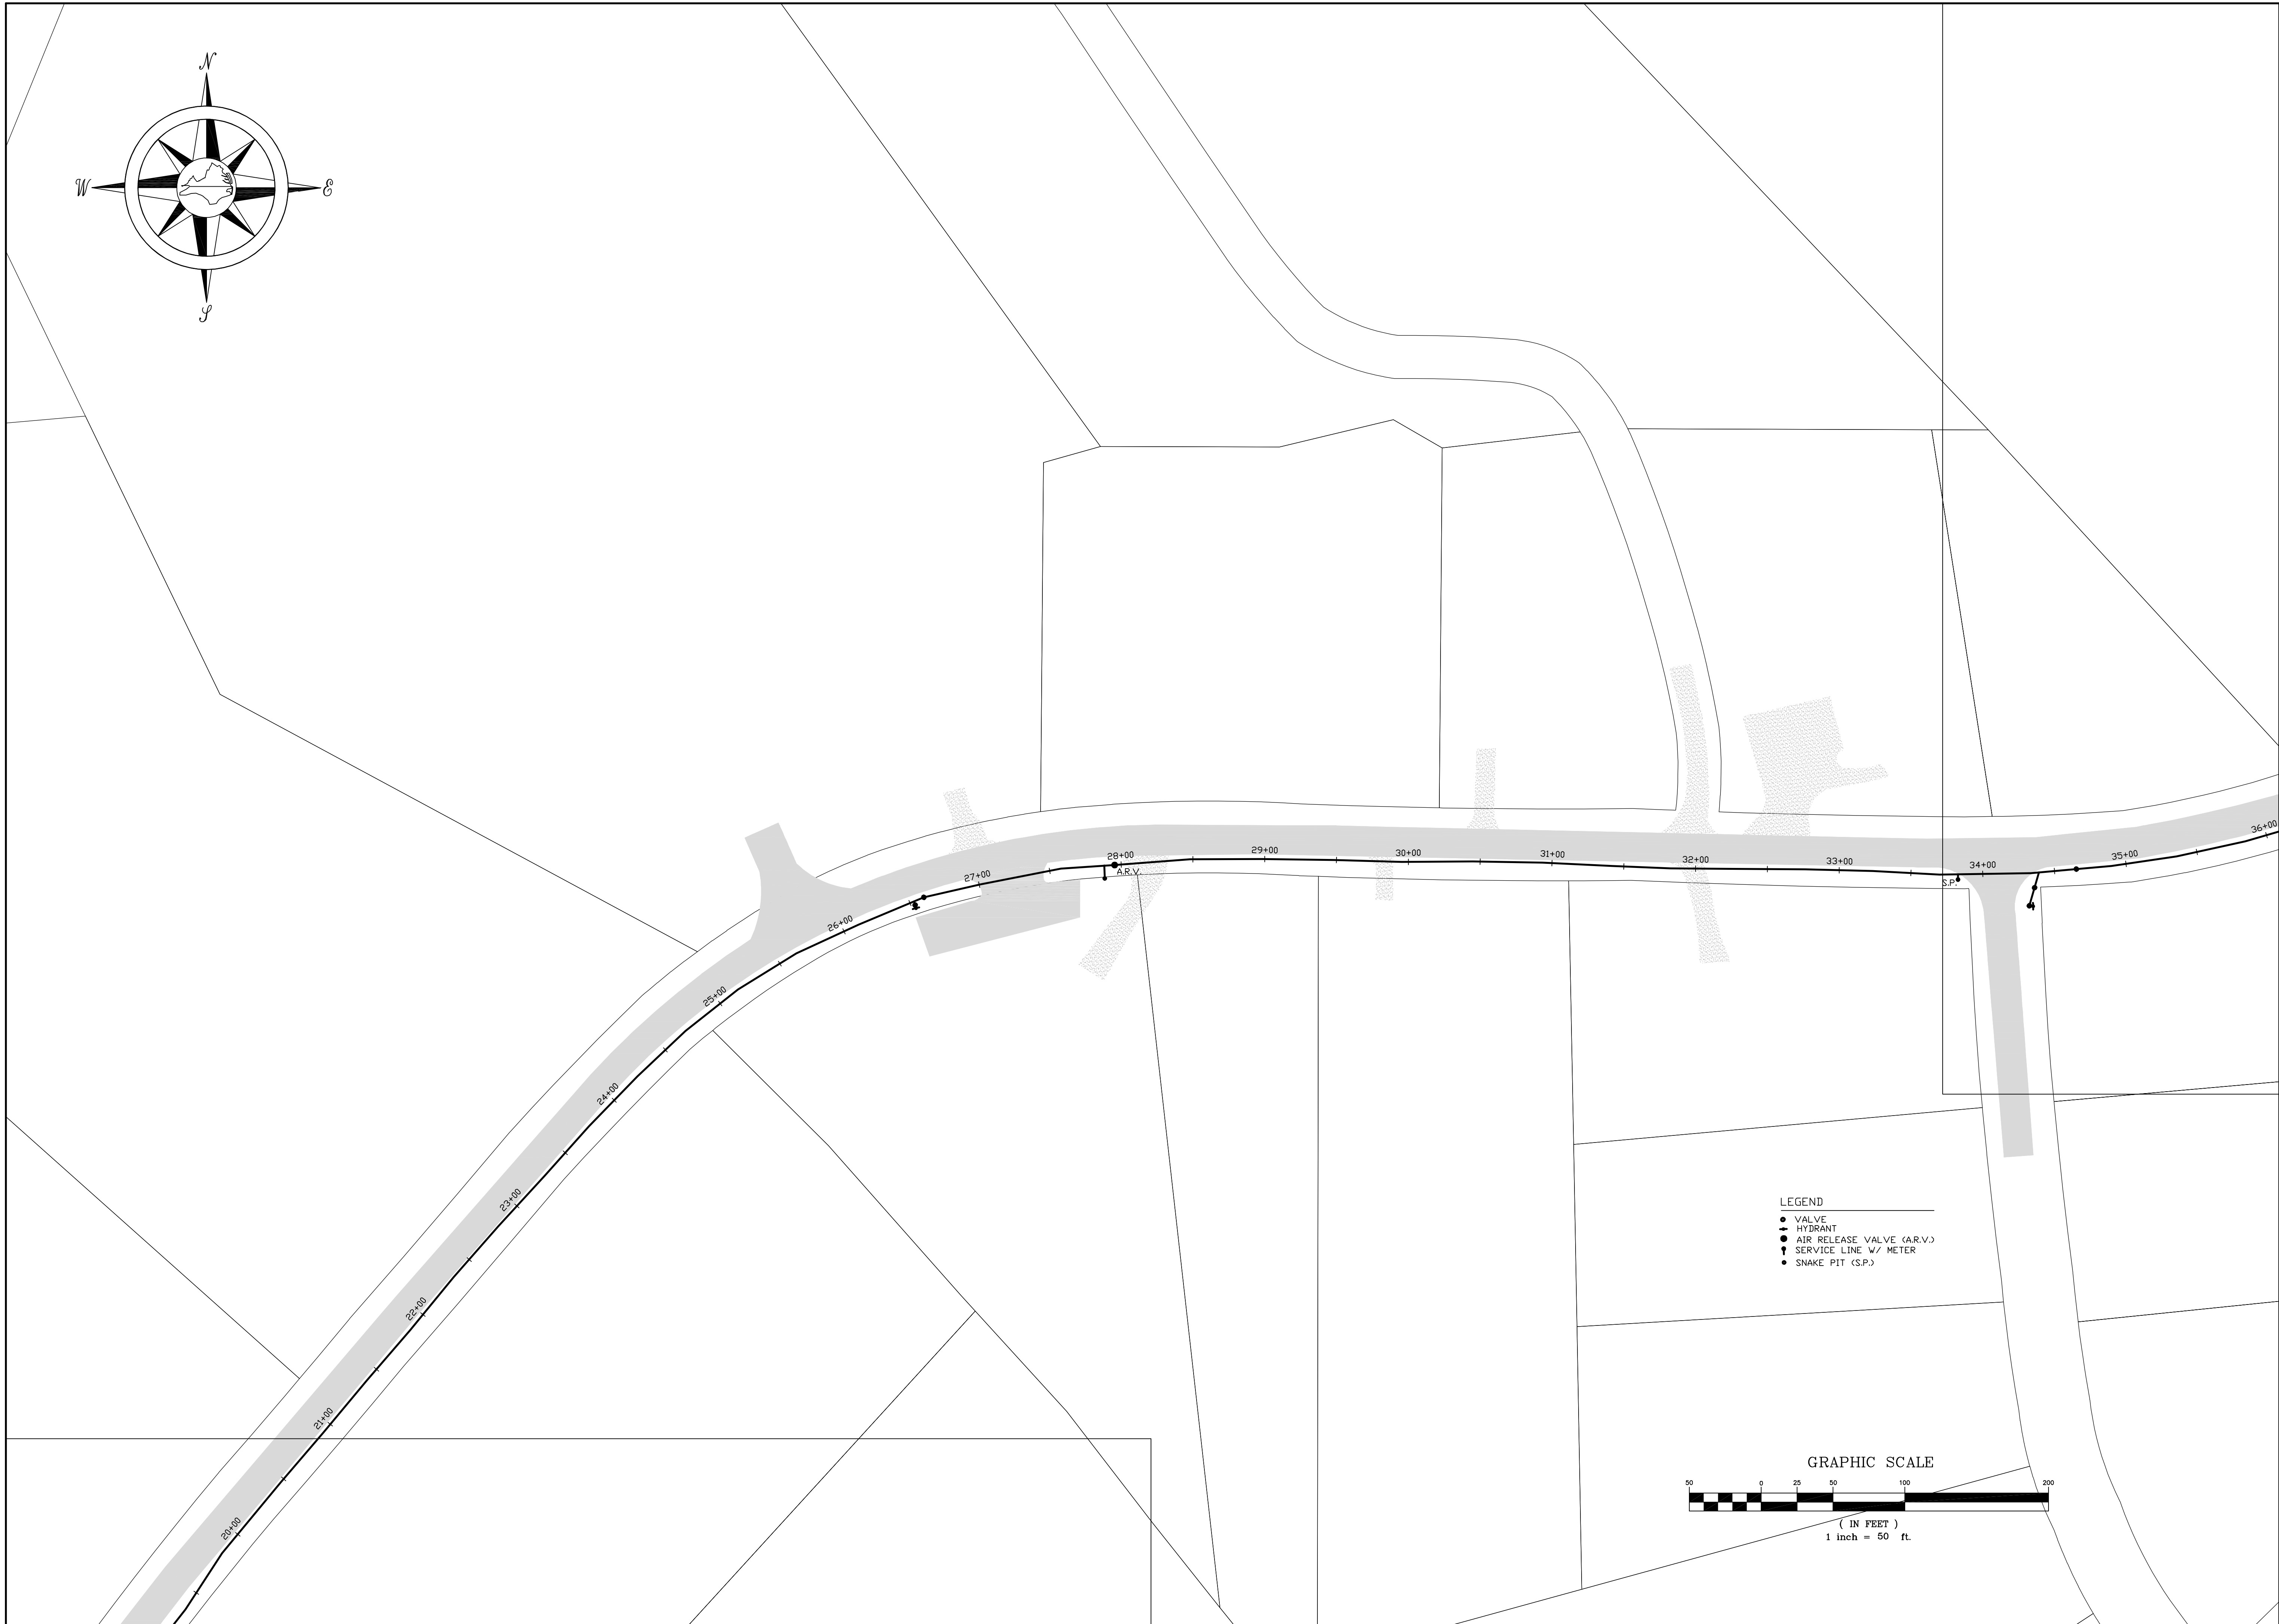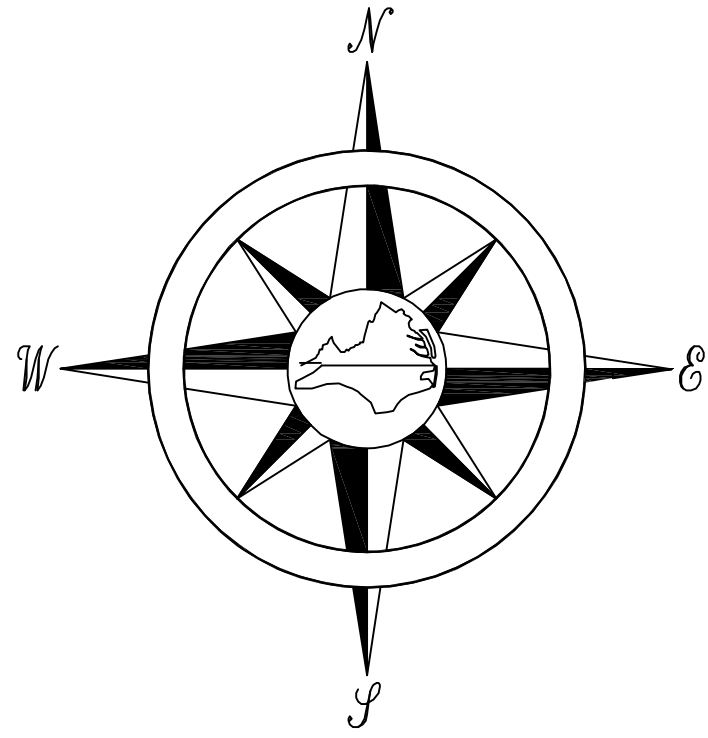


- LEGEND
- VALVE
 - HYDRANT
 - AIR RELEASE VALVE (A.R.V.)
 - SERVICE LINE W/ METER
 - SNAKE PIT (S.P.)

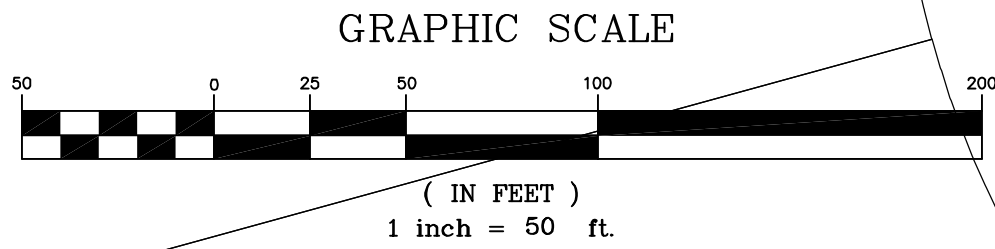


REVISIONS	
NO.	DATE DESCRIPTION

DATE 9/7/20	
----------------	--

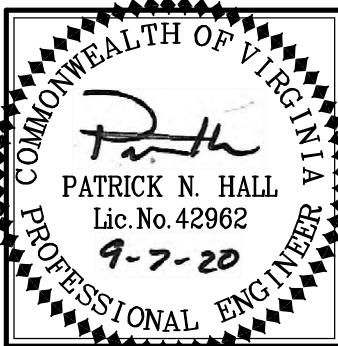


AS-BUILT SURVEY

LAKEWOOD FOREST & WEATHERWOOD INTERCONNECTION

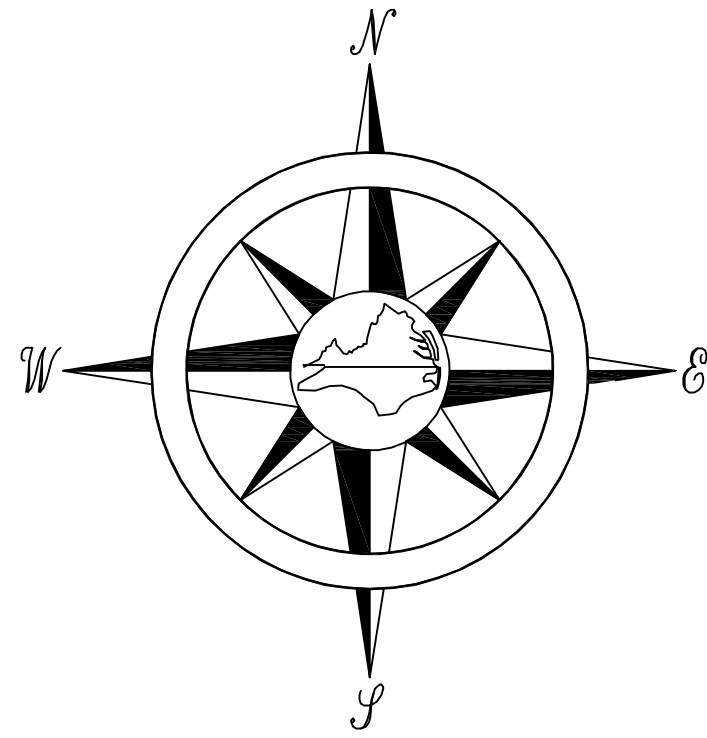


EX. MAG NAIL
N 3564125.5700
E 11133448.7700
ELEV 994.14

- LEGEND
- VALVE
 - HYDRANT
 - AIR RELEASE VALVE (A.R.V.)
 - ↑ SERVICE LINE W/ METER
 - SNAKE PIT (S.P.)

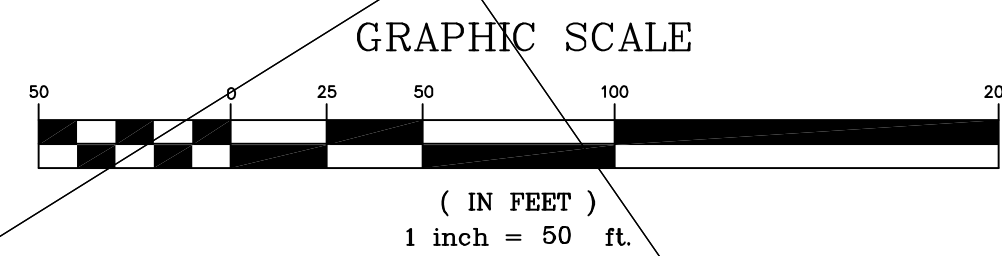


REVISIONS	
NO.	DESCRIPTION


DATE 9/7/20

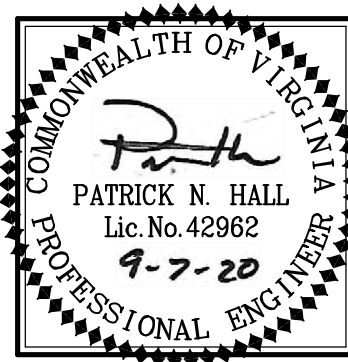

AS-BUILT SURVEY
LAKEWOOD FOREST & WEATHERWOOD INTERCONNECTION

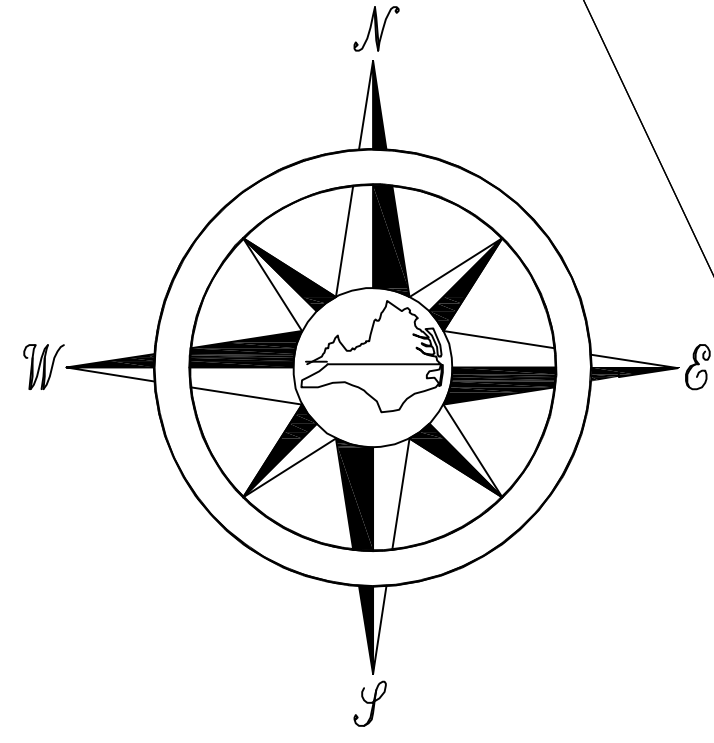


- LEGEND
- VALVE
 - HYDRANT
 - AIR RELEASE VALVE (A.R.V.)
 - ! SERVICE LINE W/ METER
 - SNAKE PIT (S.P.)

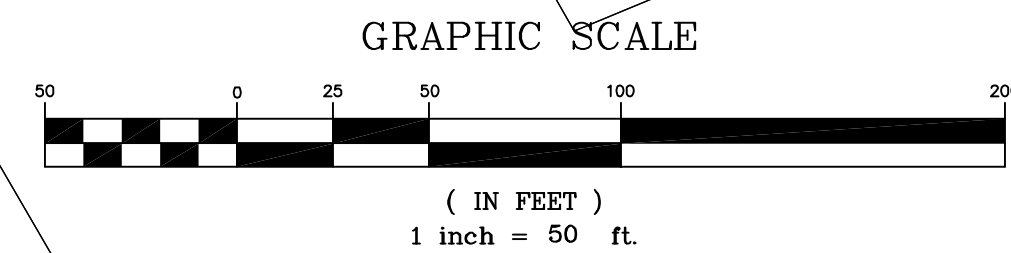



REVISIONS	
NO.	DESCRIPTION

DATE 9/7/20	
----------------	--

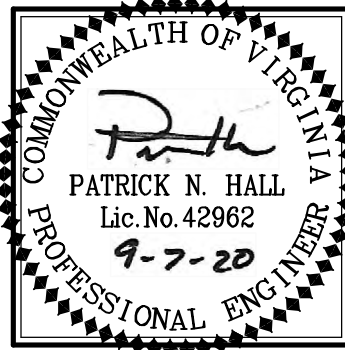



AS-BUILT SURVEY

LAKWOOD FOREST & WEATHERWOOD INTERCONNECTION

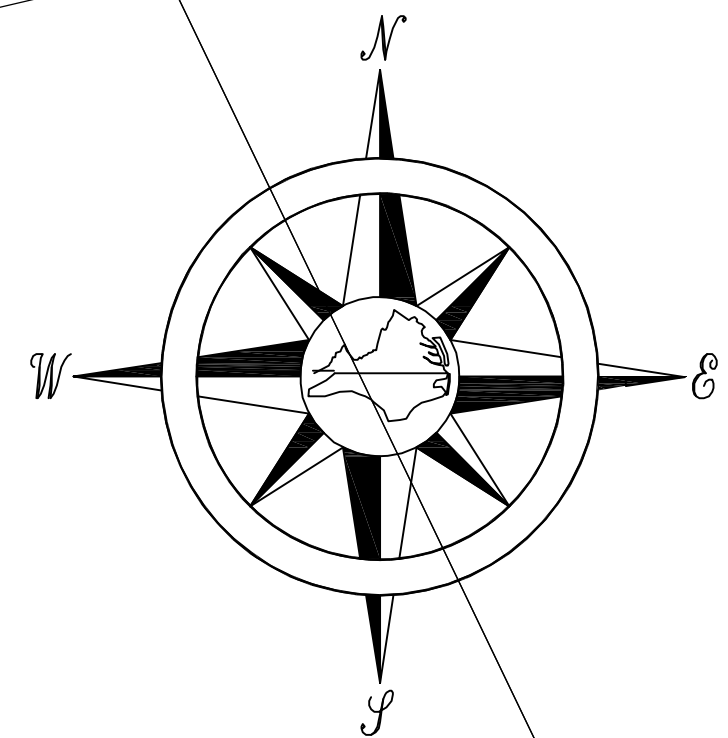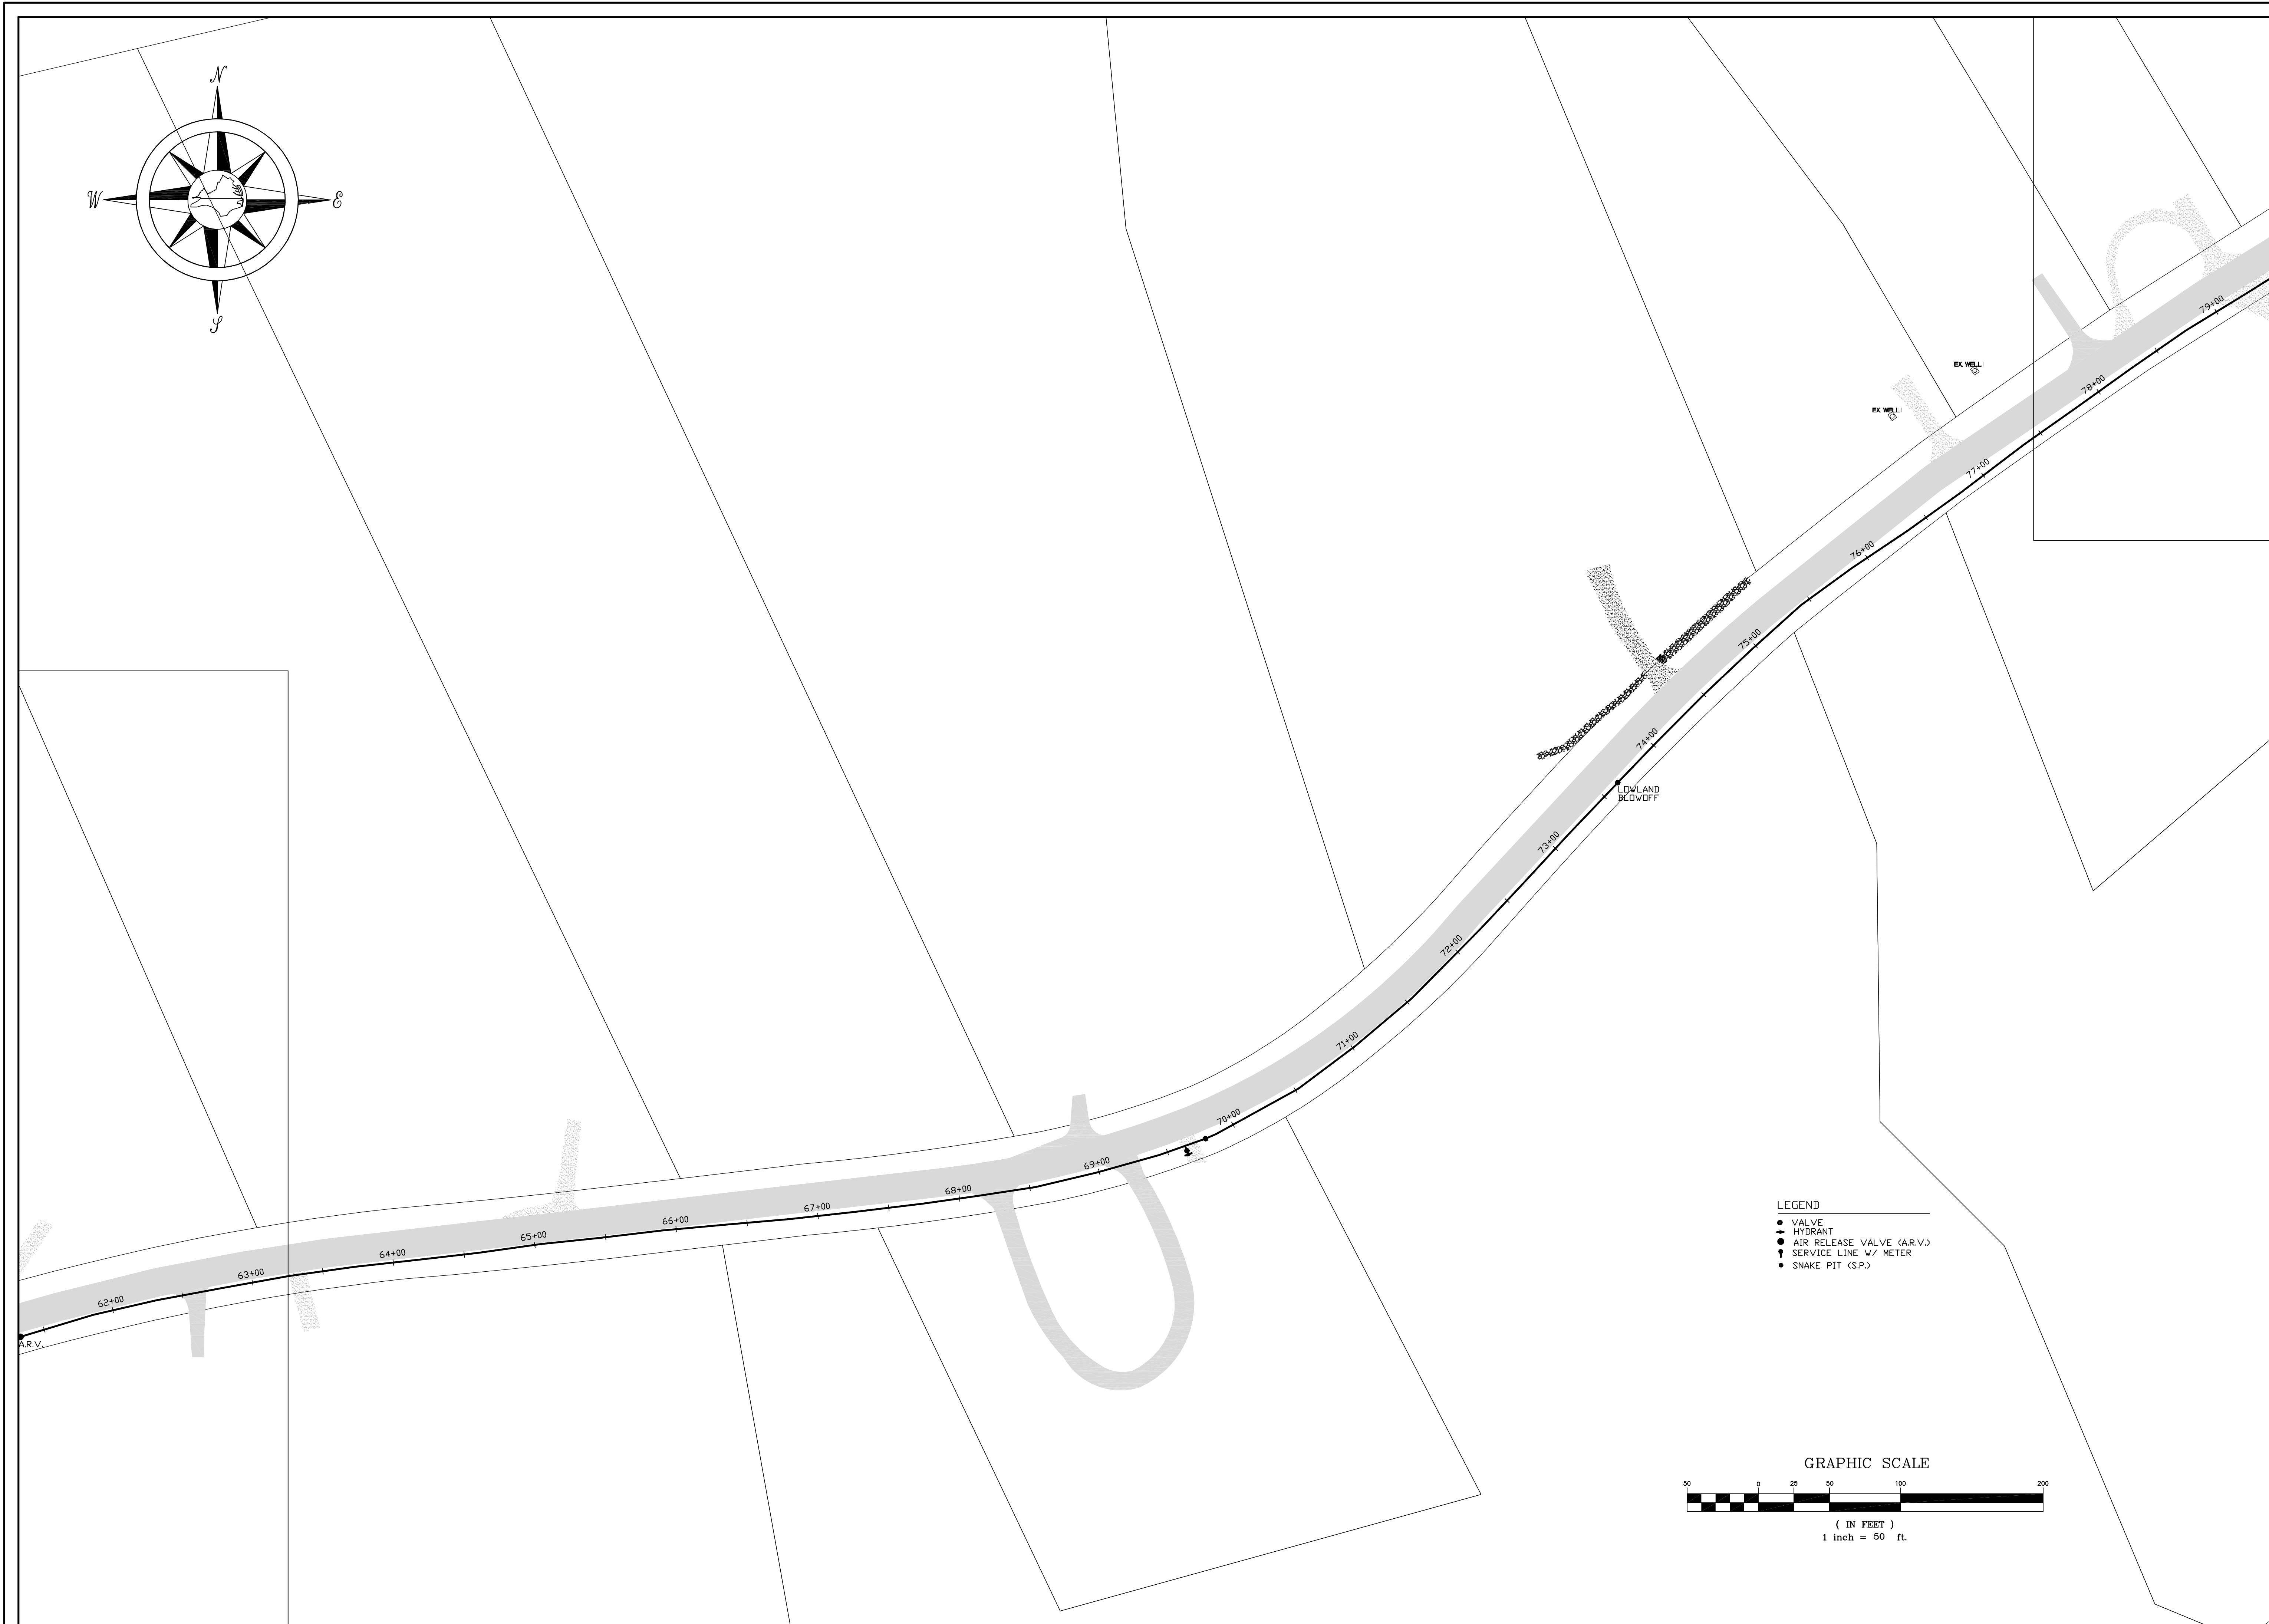


- LEGEND
- VALVE
 - ⊙ HYDRANT
 - AIR RELEASE VALVE (A.R.V.)
 - ⌚ SERVICE LINE W/ METER
 - SNAKE PIT (S.P.)

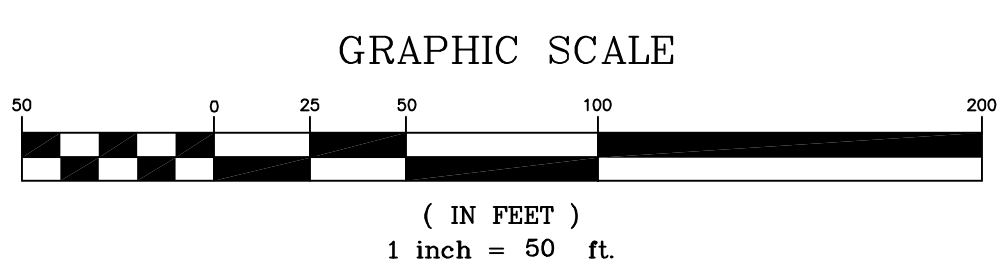

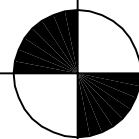**BENCHMARK** Surveying & Design, PLC
5017 ARARAT HIGHWAY, ARARAT, VIRGINIA 24053
PATRICK N. HALL L.S. #2667 PH. (276) 251-5119

REVISIONS	
NO.	DATE

DATE	DESCRIPTION
9/7/20	


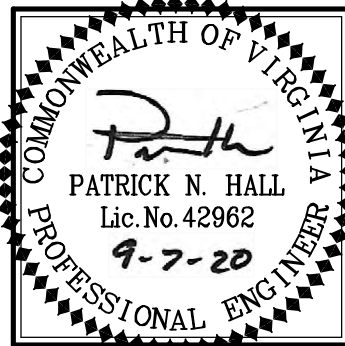


AS-BUILT SURVEY


LAKWOOD FOREST & WEATHERWOOD INTERCONNECTION



SHEET 5 of 13

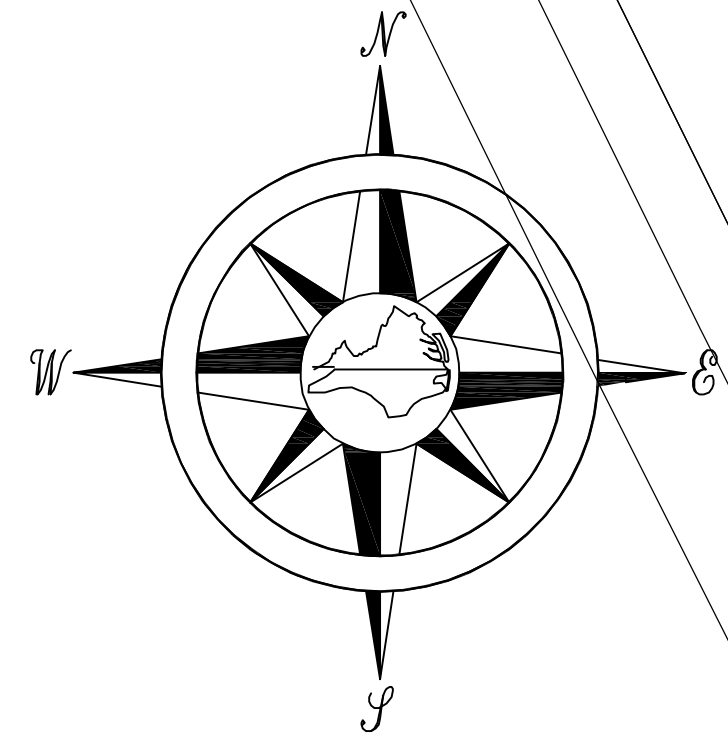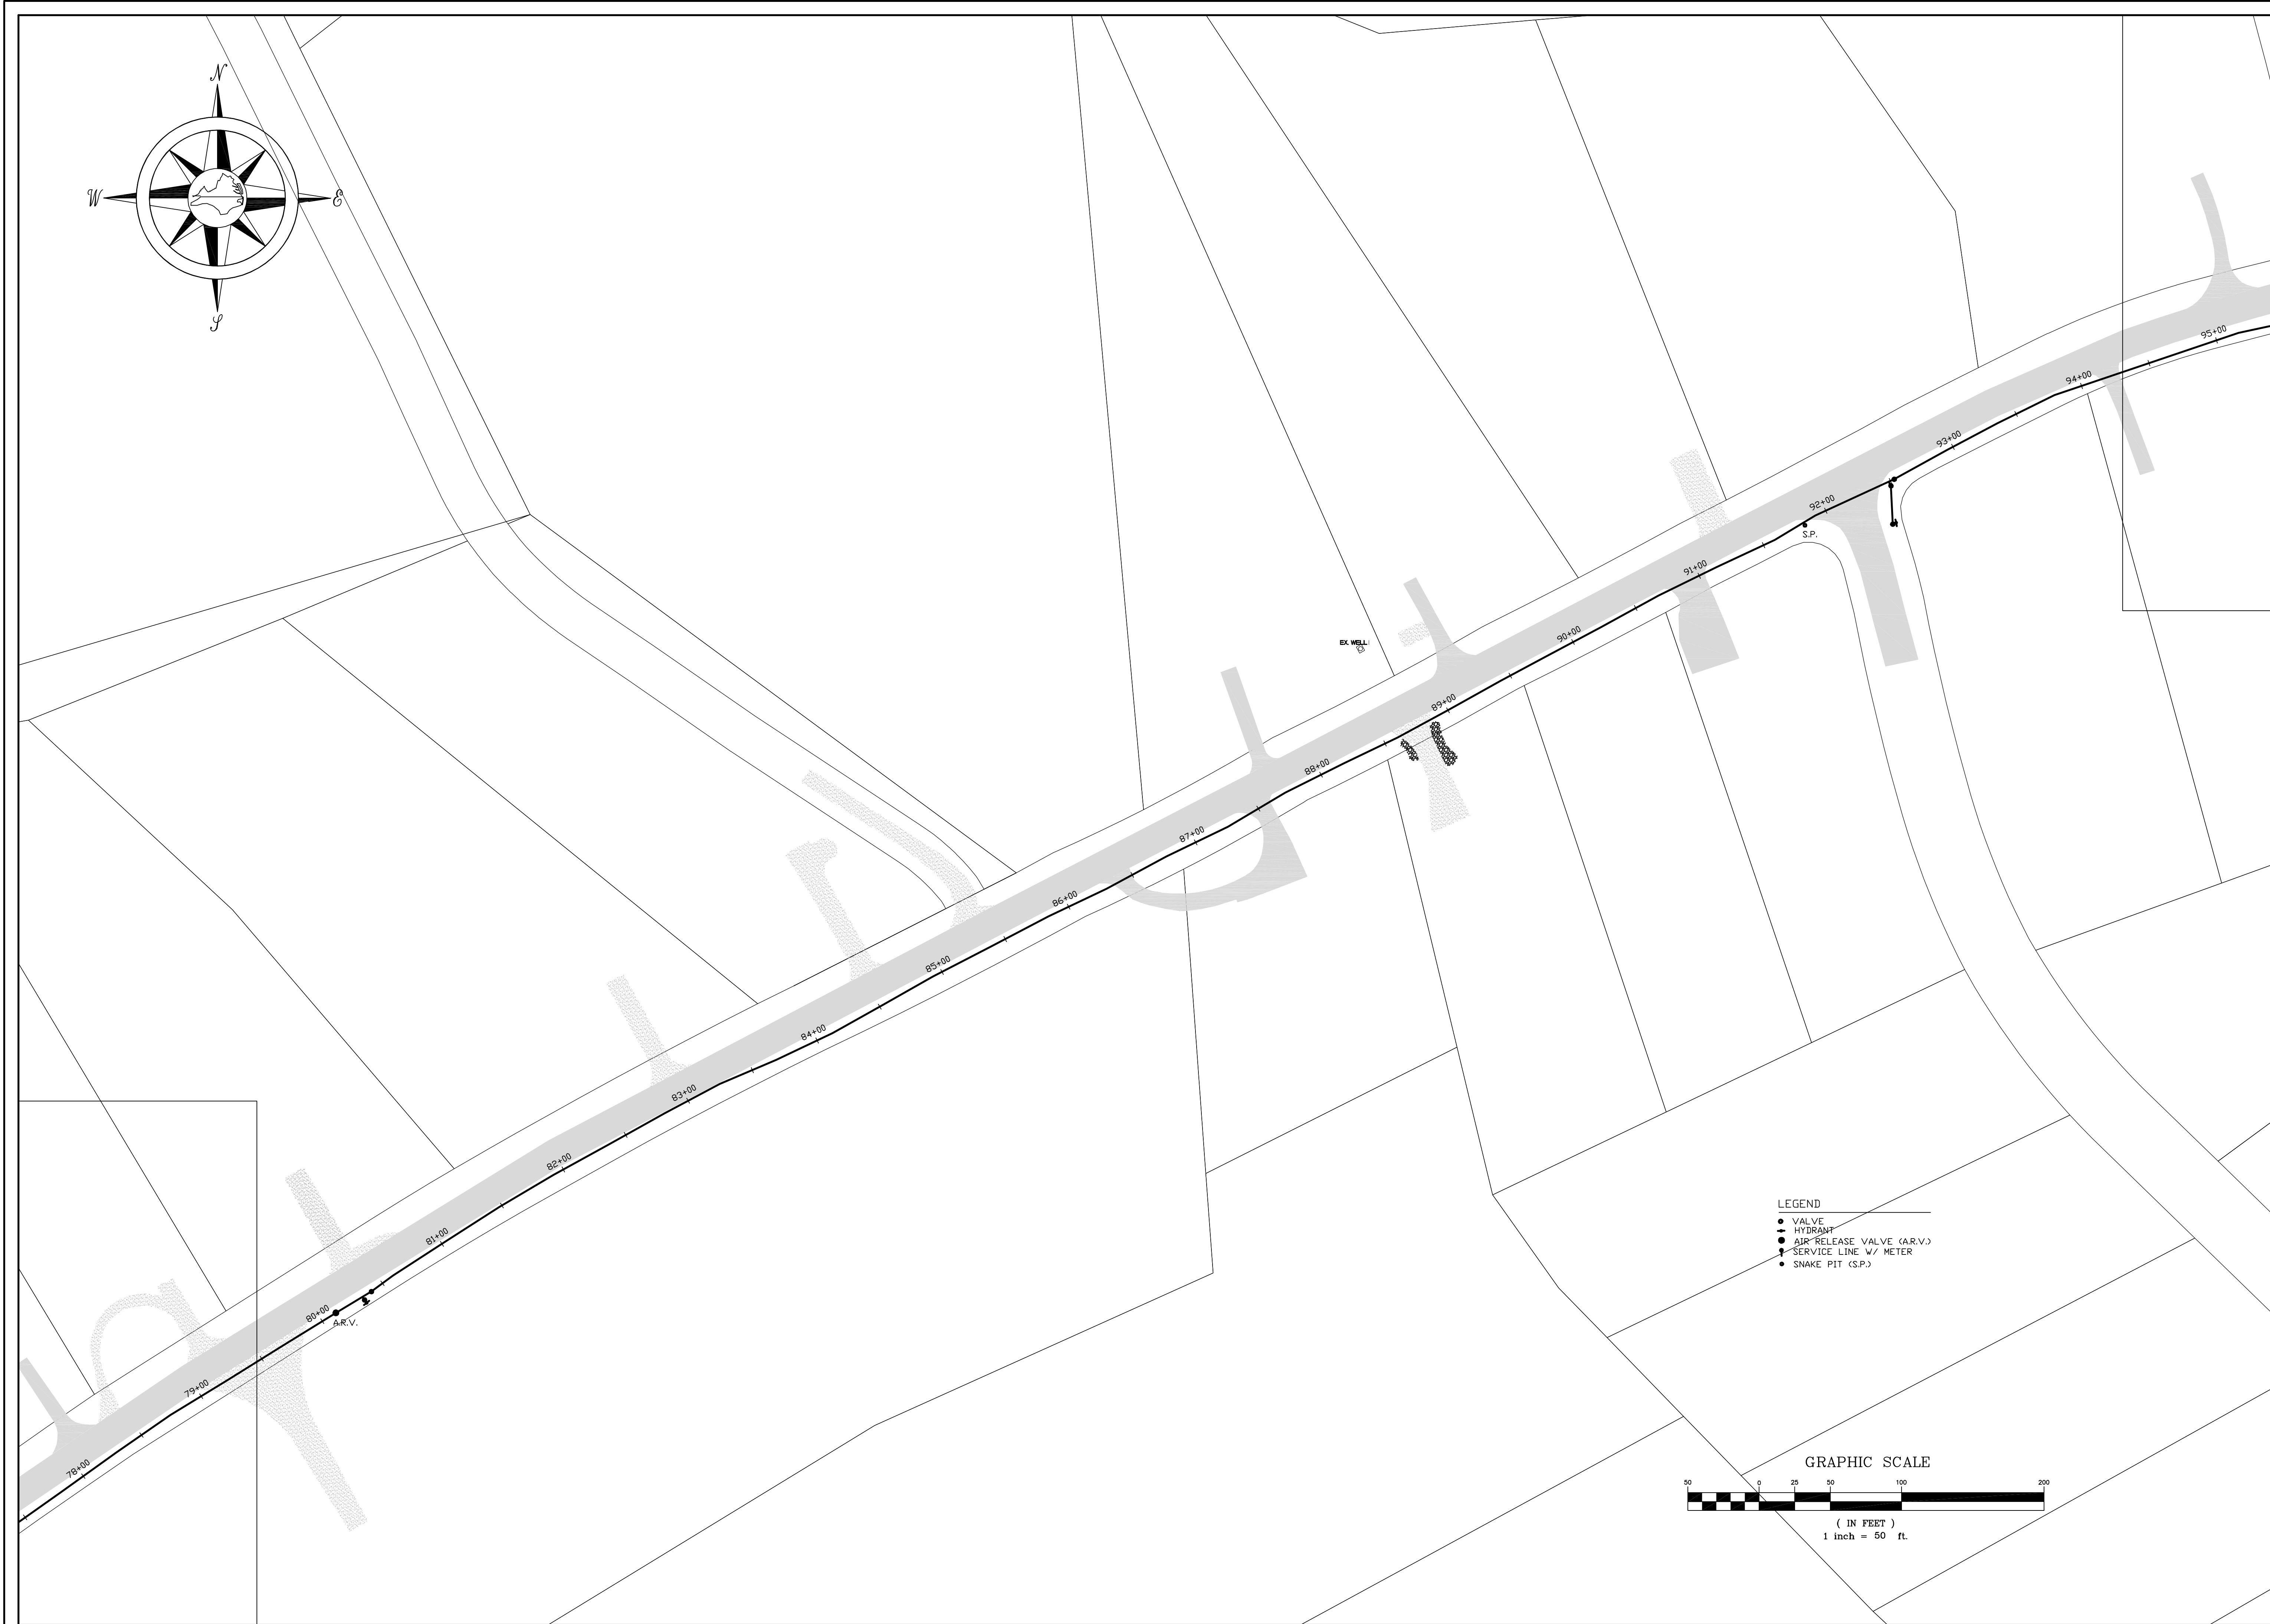


- LEGEND
- VALVE
 - HYDRANT
 - AIR-RELEASE VALVE (A.R.V.)
 - SERVICE LINE W/ METER
 - SNAKE PIT (S.P.)

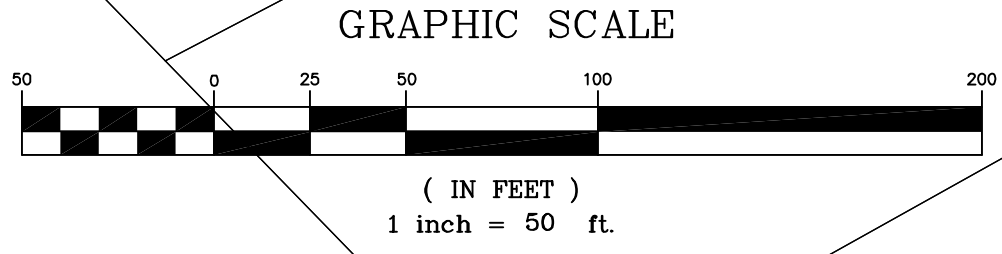



REVISIONS	
NO.	DATE DESCRIPTION

DATE	
9/7/20	

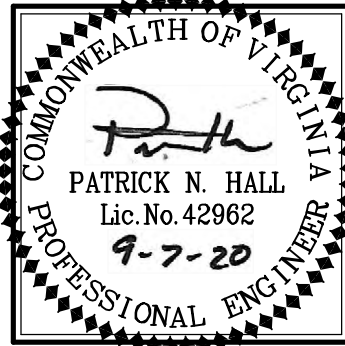



AS-BUILT SURVEY

LAKEWOOD FOREST & WEATHERWOOD INTERCONNECTION

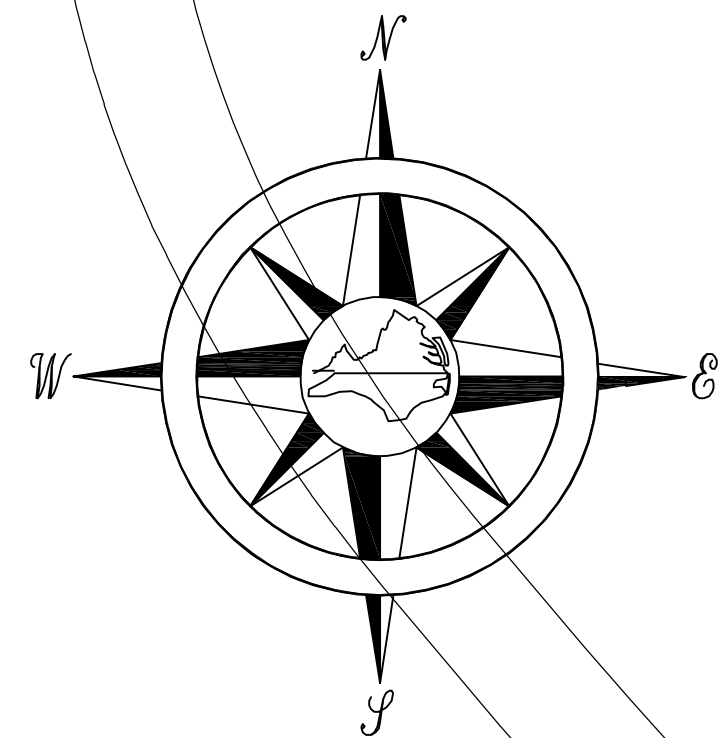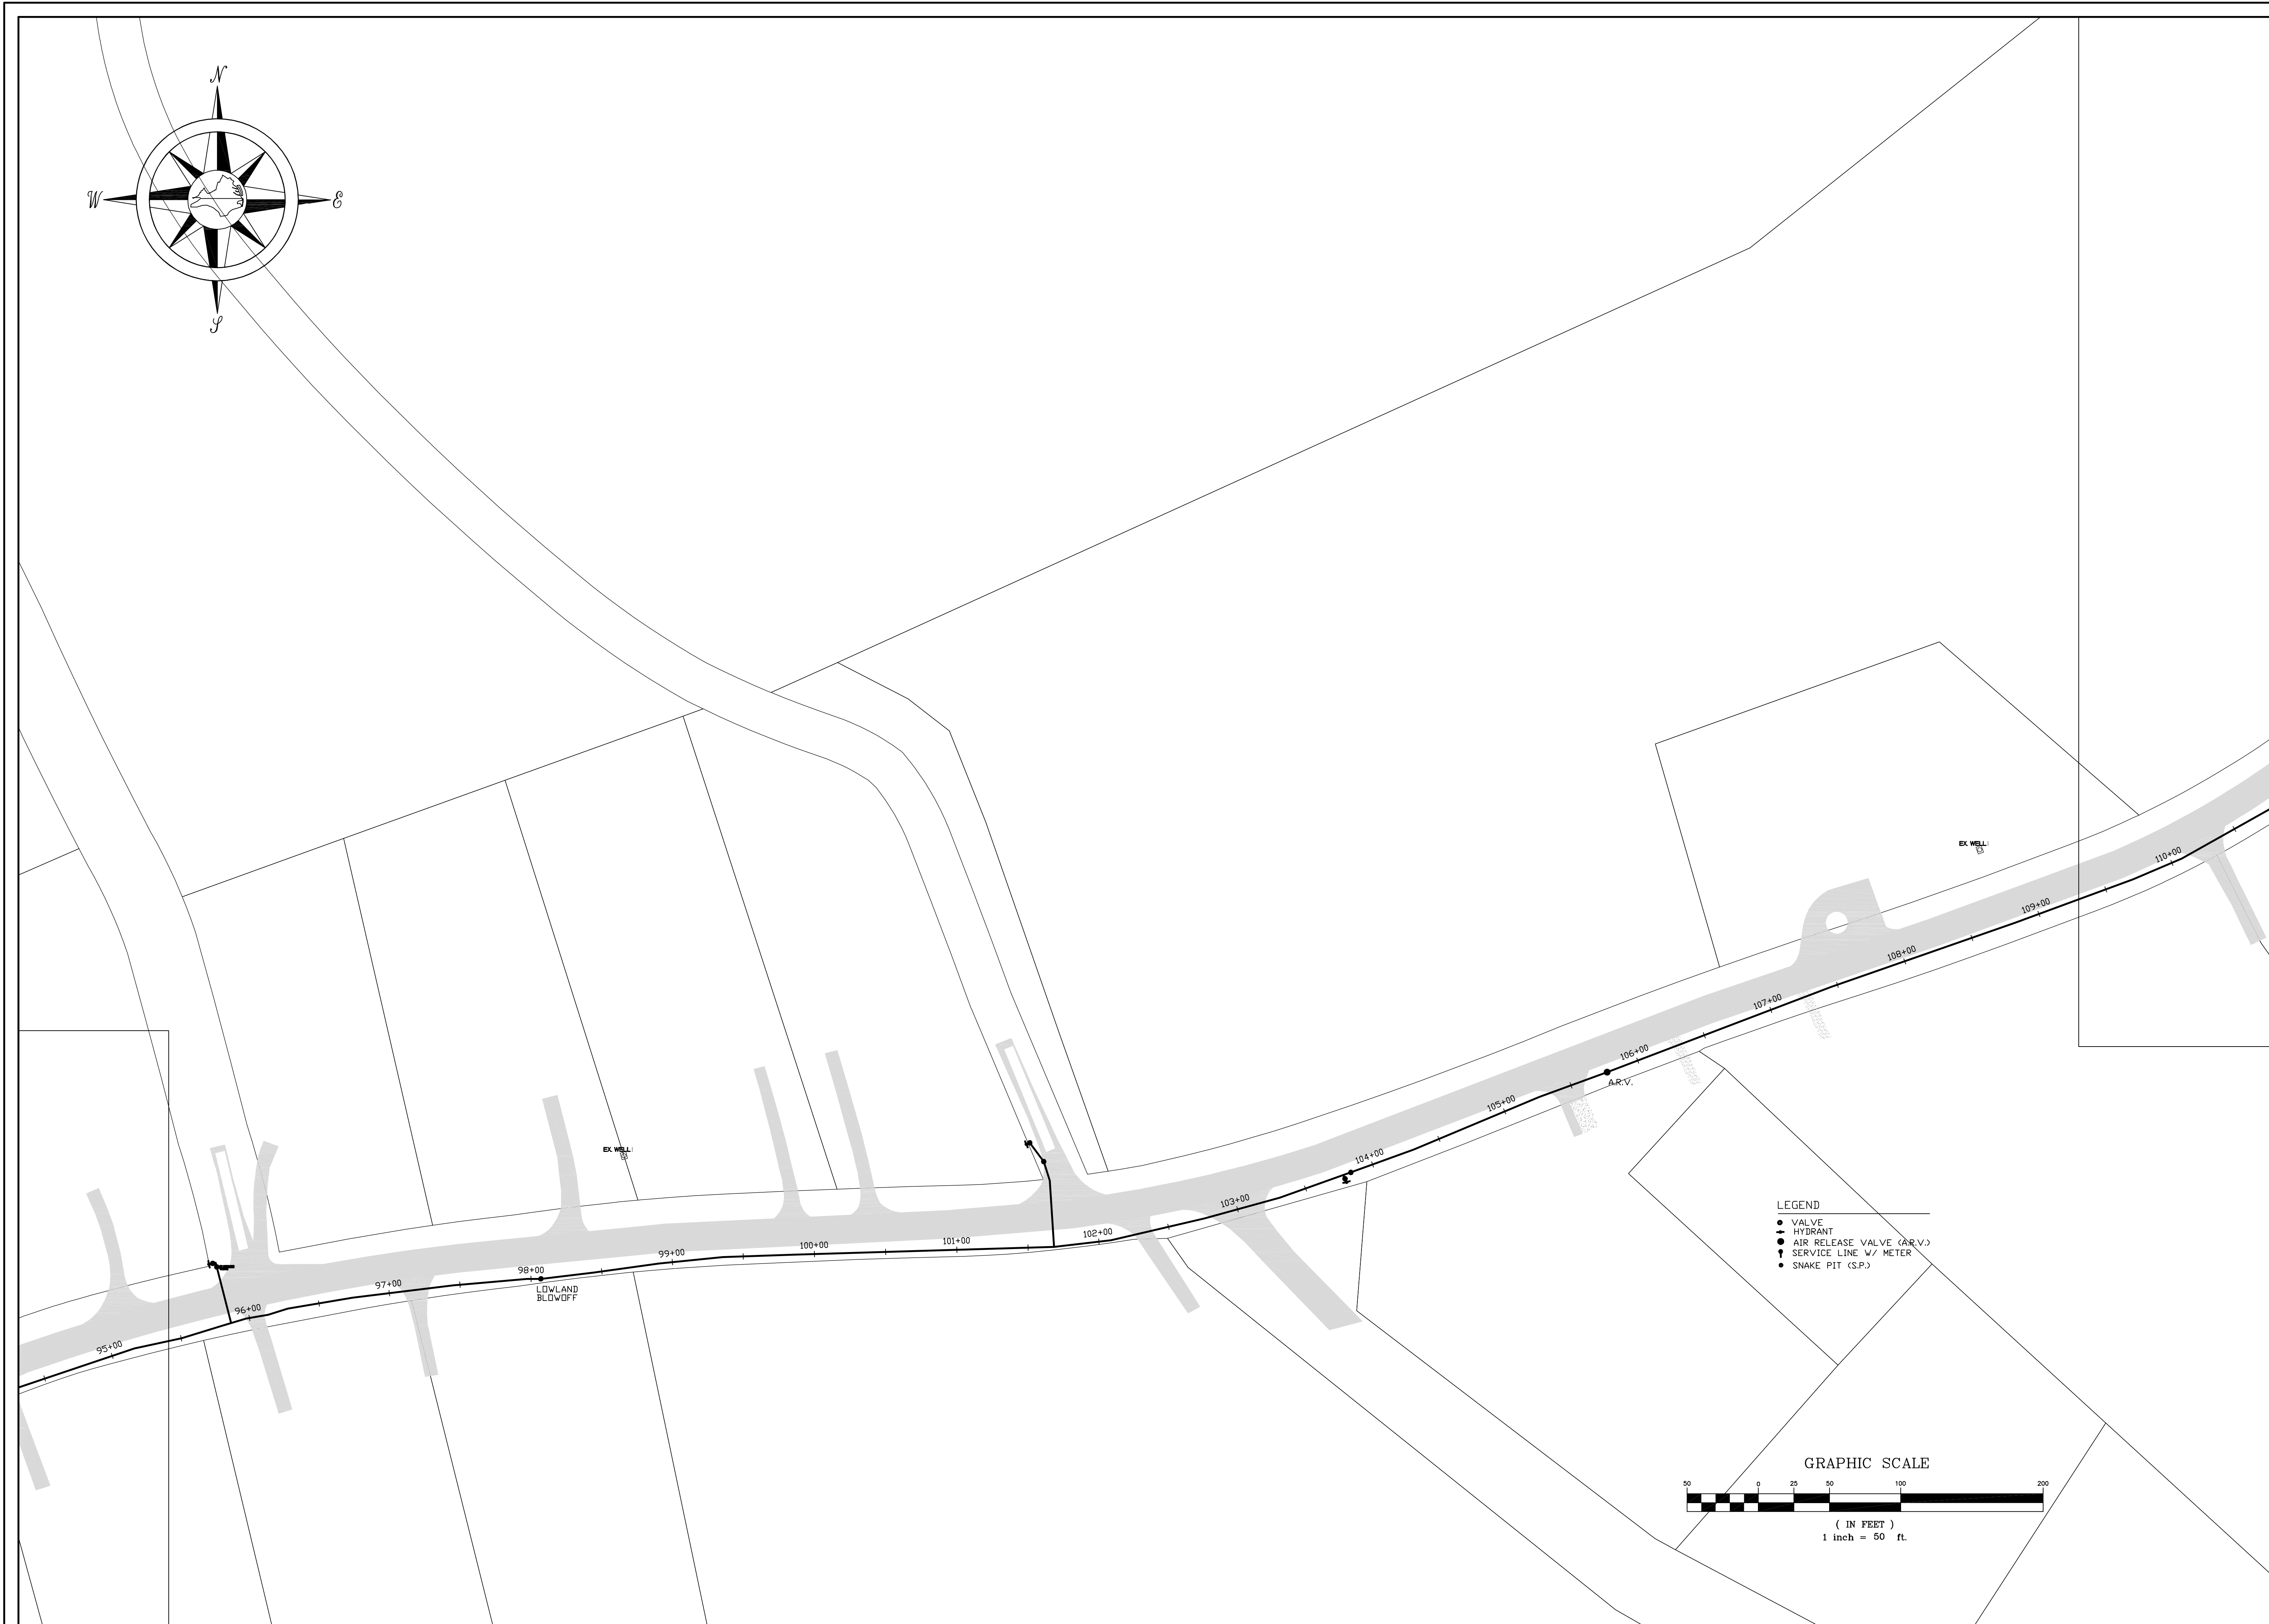


- LEGEND
- VALVE
 - HYDRANT
 - AIR RELEASE VALVE (A.R.V.)
 - SERVICE LINE W/ METER
 - SNAKE PIT (S.P.)

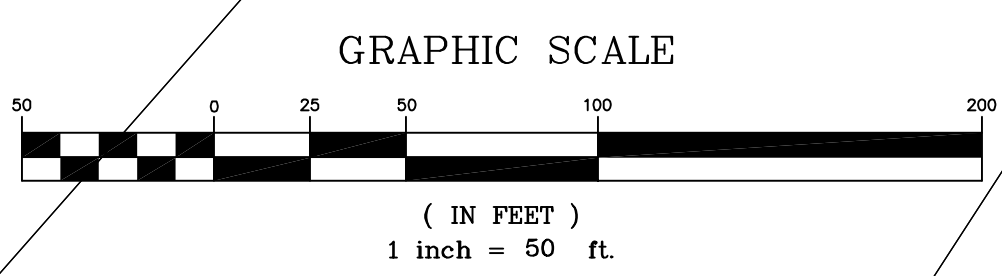

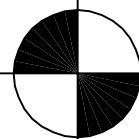**BENCHMARK** Surveying & Design, PLC
5017 ARARAT HIGHWAY, ARARAT, VIRGINIA 24053
PATRICK N. HALL L.S. #2667 PH. (276) 251-5119



REVISIONS	
NO.	DESCRIPTION

DATE
9/7/20

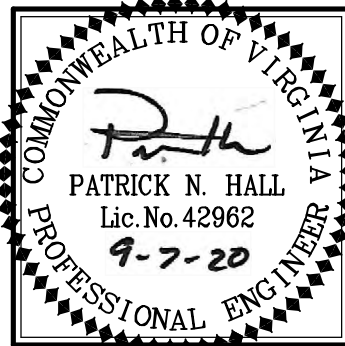


AS-BUILT SURVEY

LAKWOOD FOREST & WEATHERWOOD INTERCONNECTION

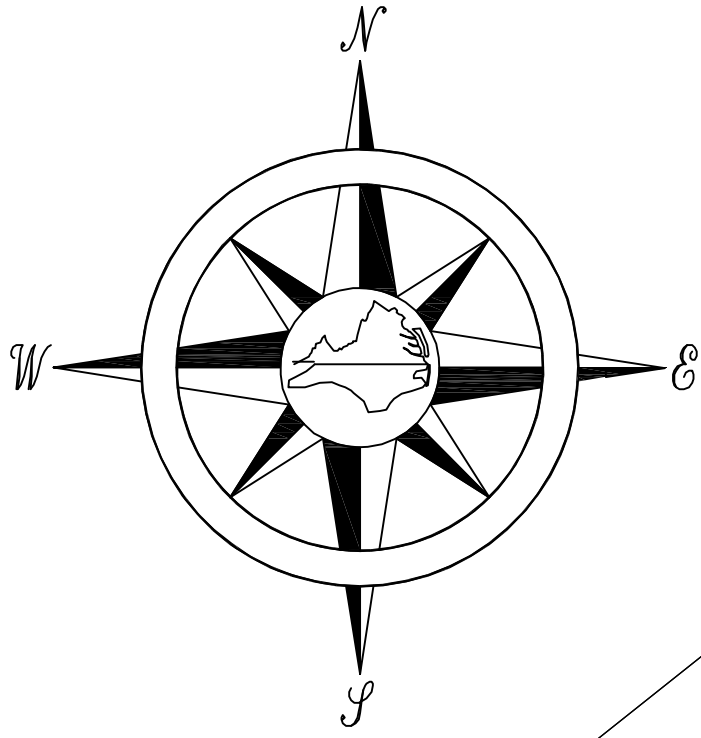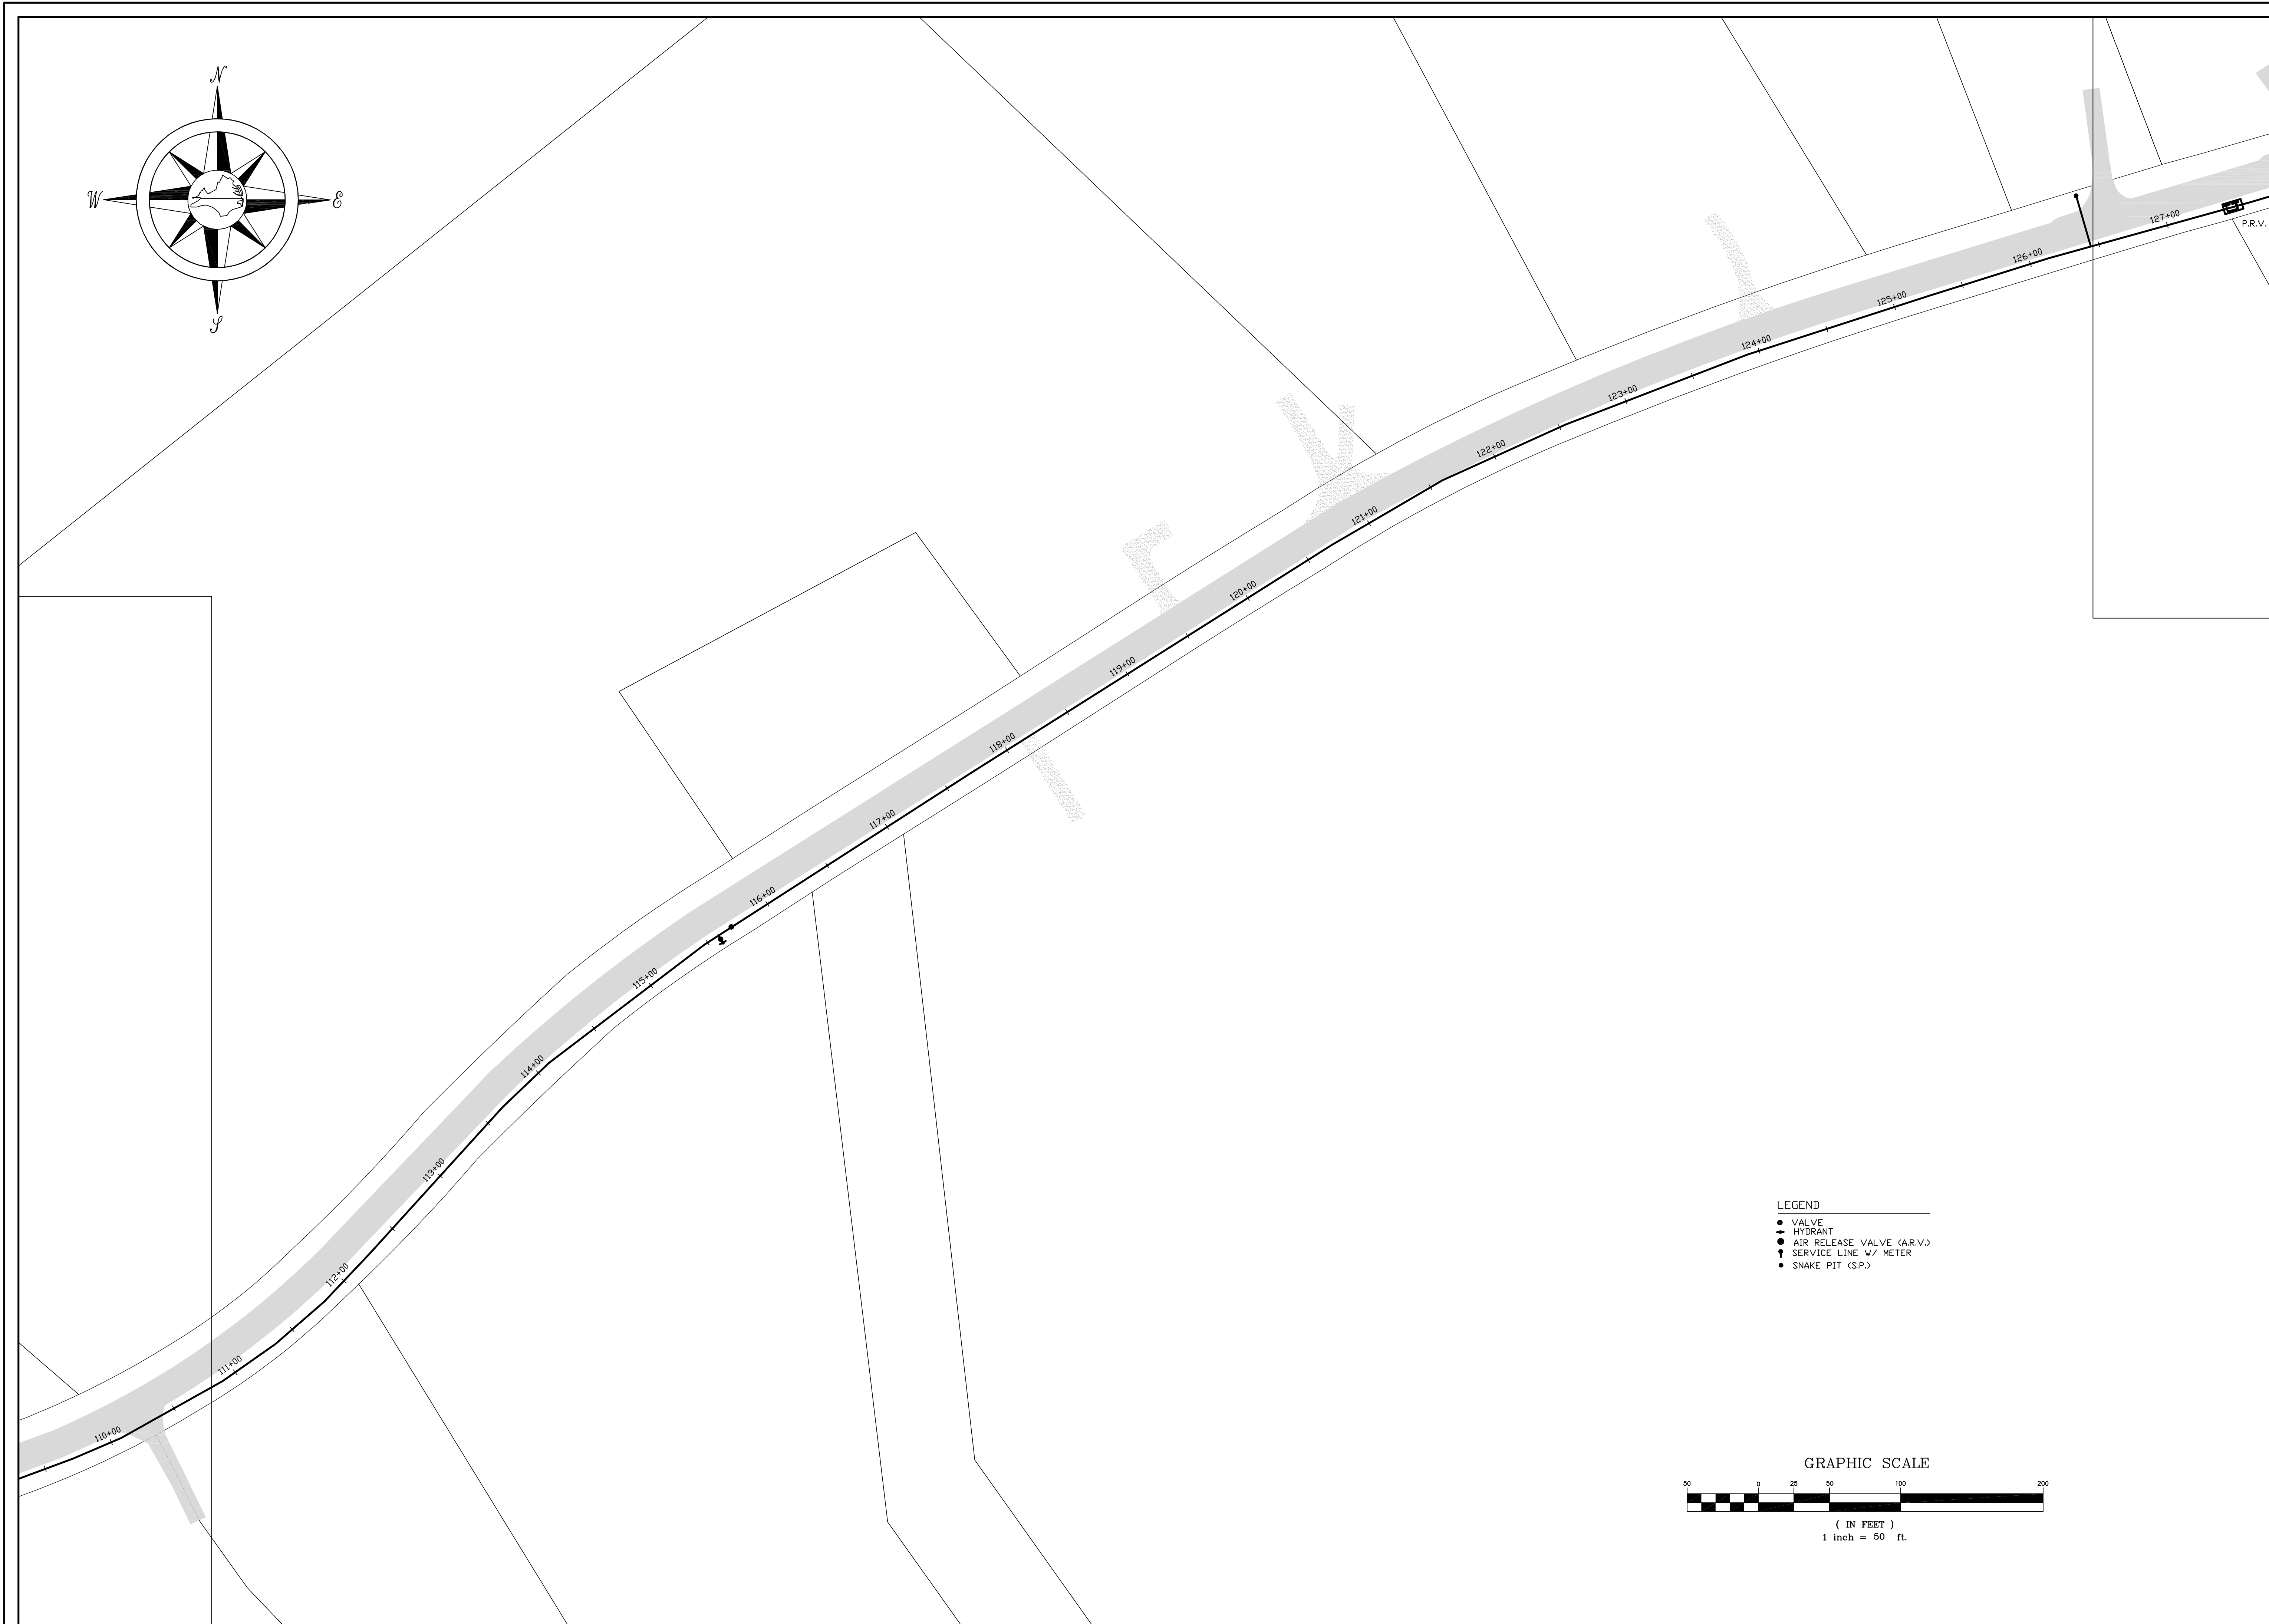


- LEGEND
- VALVE
 - ⊕ HYDRANT
 - AIR RELEASE VALVE (A.R.V.)
 - ⚡ SERVICE LINE W/ METER
 - SNAKE PIT (S.P.)

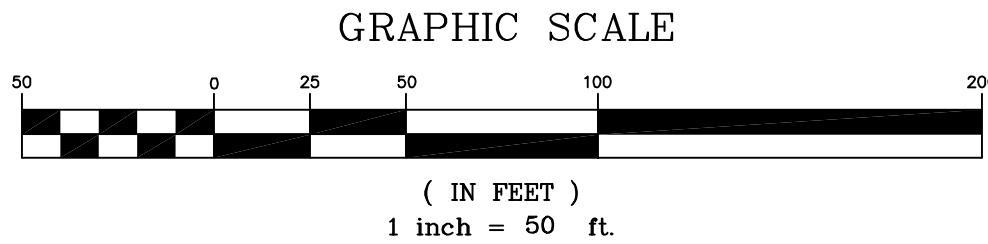



REVISIONS	
NO.	DESCRIPTION

DATE 9/7/20	
----------------	--

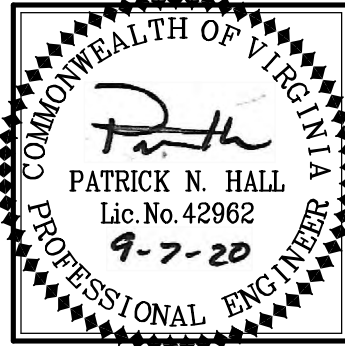

AS-BUILT SURVEY


LAKWOOD FOREST & WEATHERWOOD INTERCONNECTION

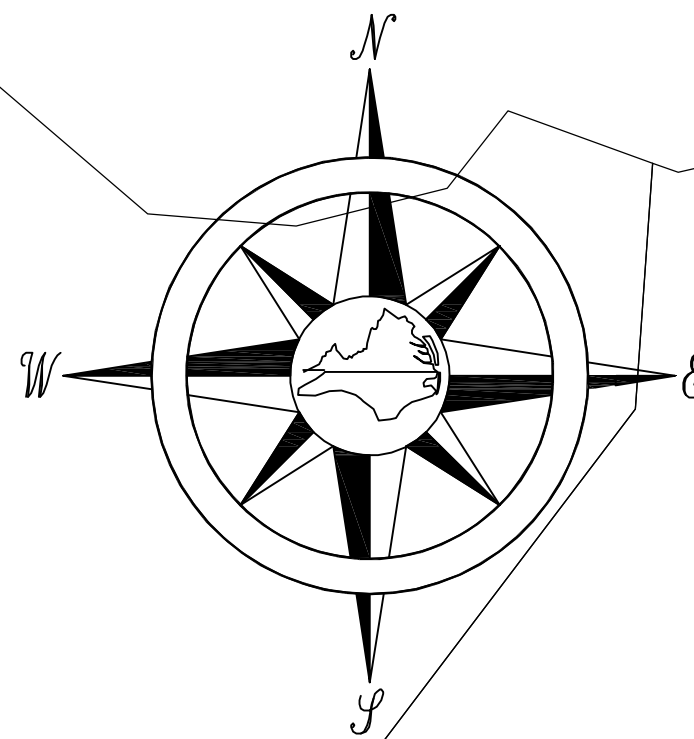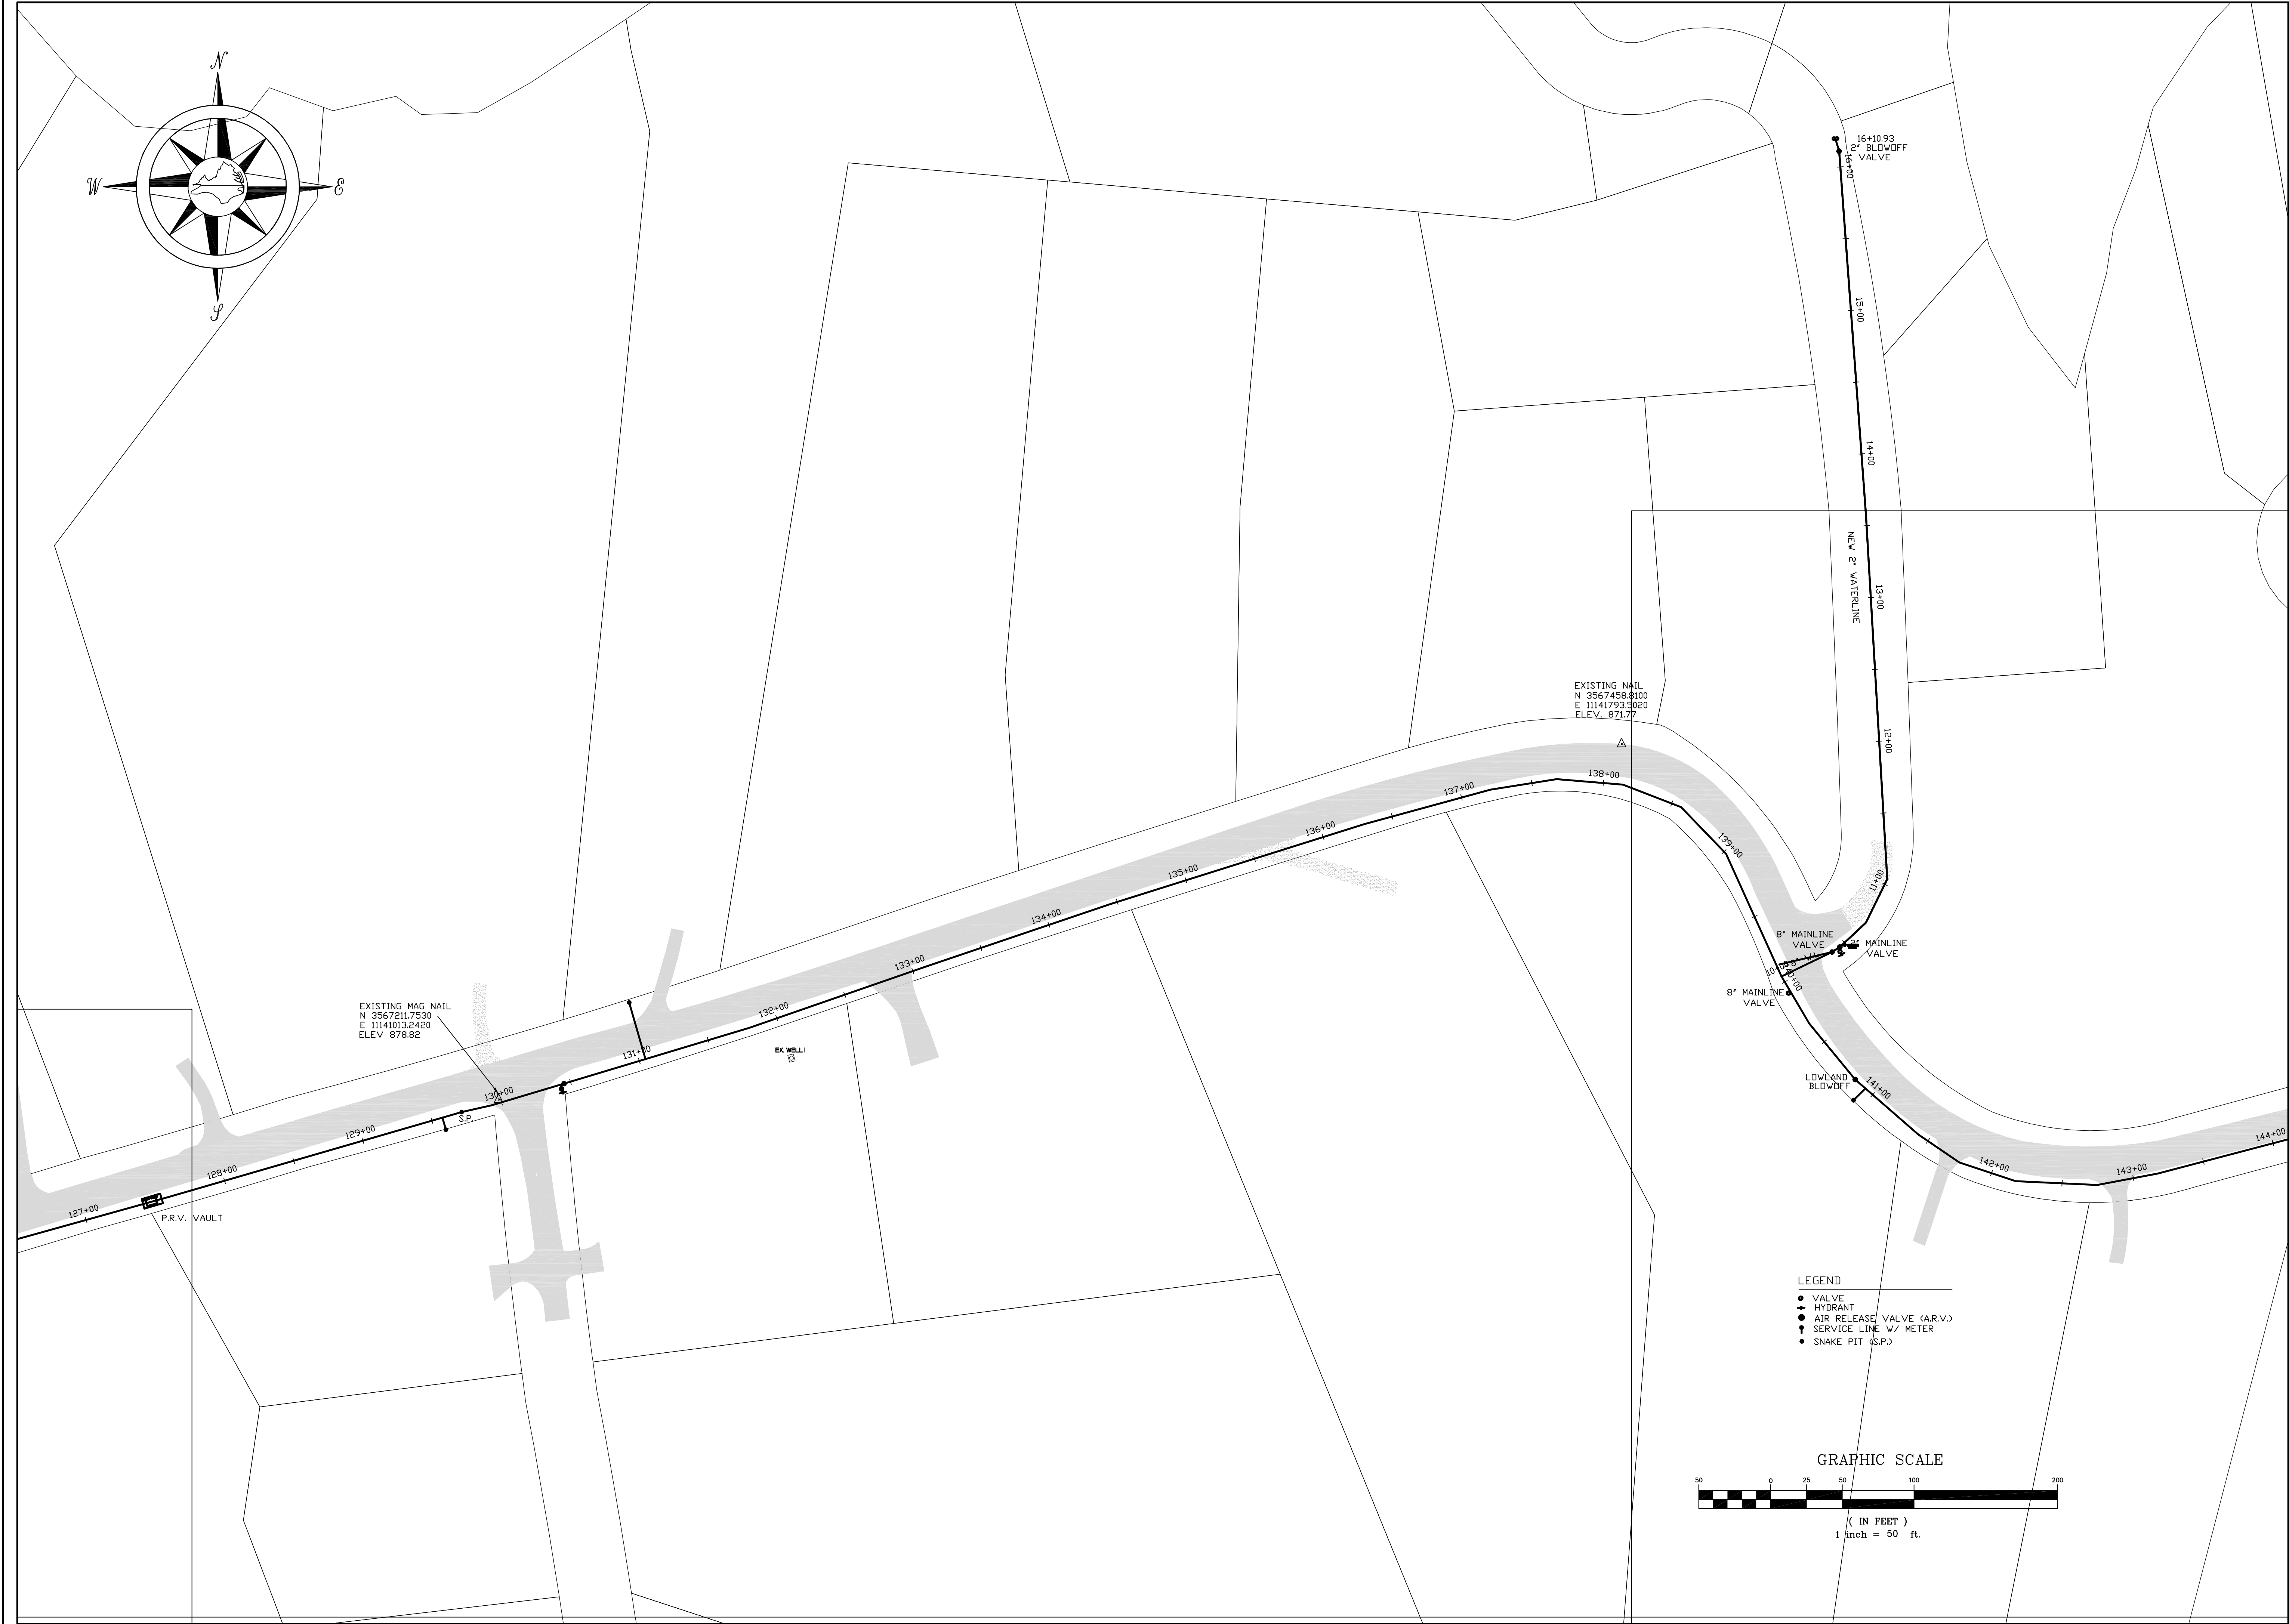

EXISTING MAG NAIL
N 3567211.7530
E 11141013.2420
ELEV. 878.82


EXISTING NAIL
N 3567458.8100
E 11141793.5020
ELEV. 871.77

- LEGEND
- VALVE
 - HYDRANT
 - AIR RELEASE VALVE (A.R.V.)
 - SERVICE LINE W/ METER
 - SNAKE PIT (S.P.)

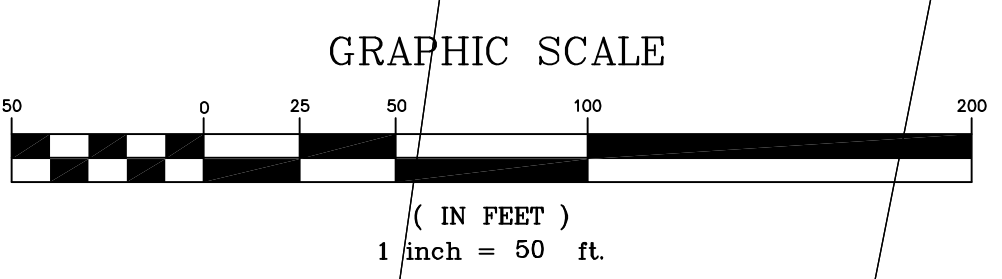

REVISIONS	
NO.	DATE DESCRIPTION

DATE 9/7/20

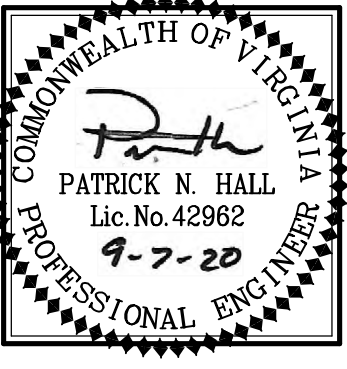


AS-BUILT SURVEY

LAKEWOOD FOREST & WEATHERWOOD INTERCONNECTION





REVISIONS	
NO.	DATE

DATE	
9/7/20	

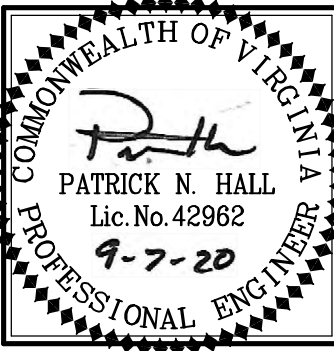


AS-BUILT SURVEY

LAKEWOOD FOREST & WEATHERWOOD INTERCONNECTION

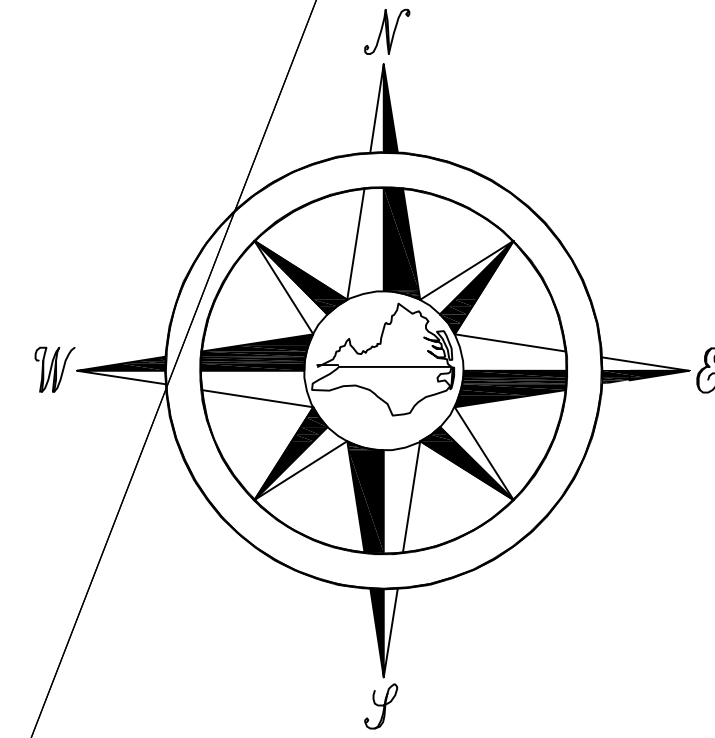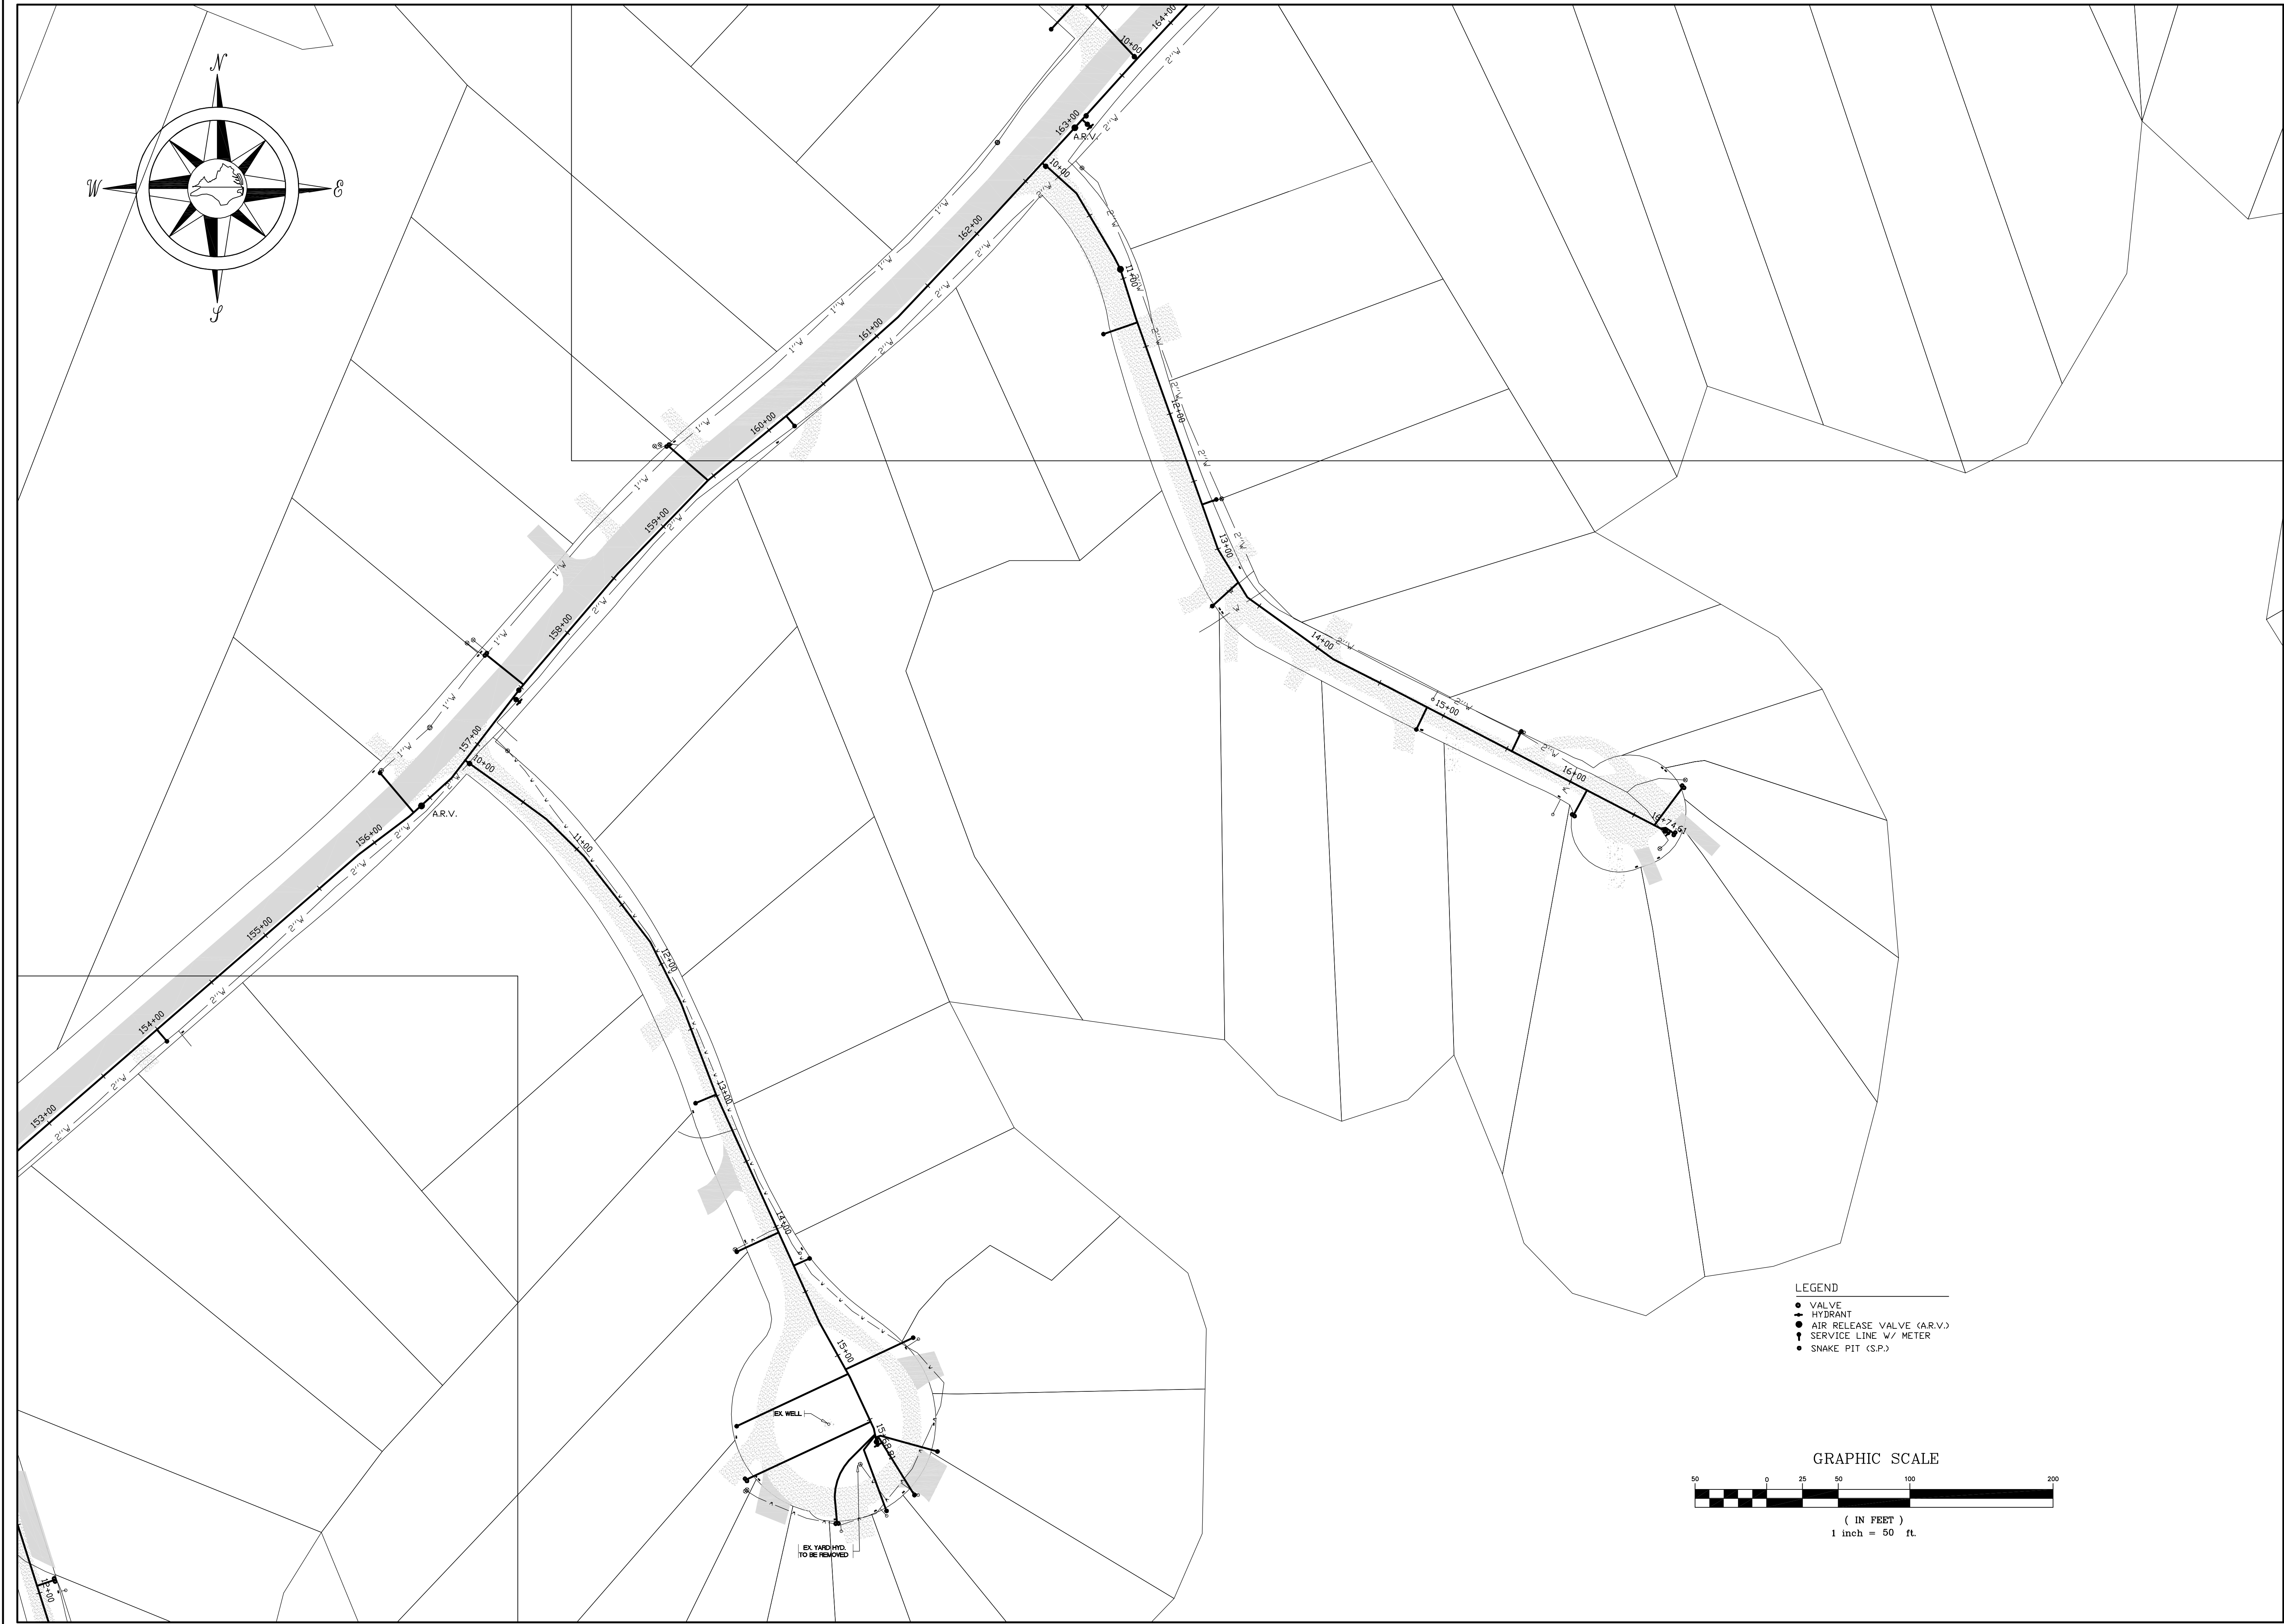


- LEGEND
- VALVE
 - HYDRANT
 - AIR RELEASE VALVE (A.R.V.)
 - ↑ SERVICE LINE W/ METER
 - SNAKE PIT (S.P.)

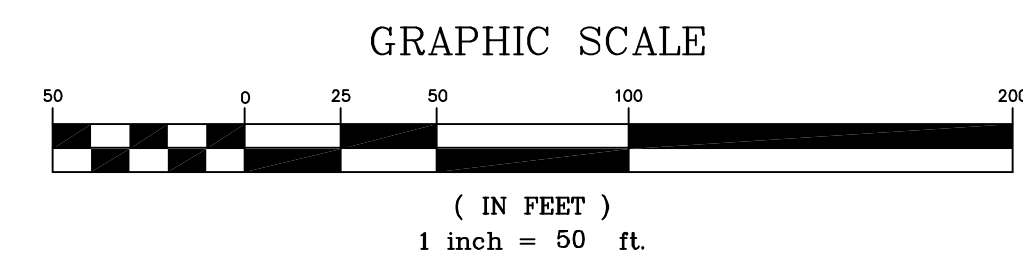


REVISIONS	
NO.	DATE

DATE	
9/7/20	

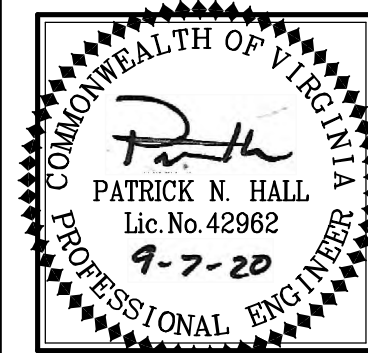

AS-BUILT SURVEY

LAKEWOOD FOREST & WEATHERWOOD INTERCONNECTION

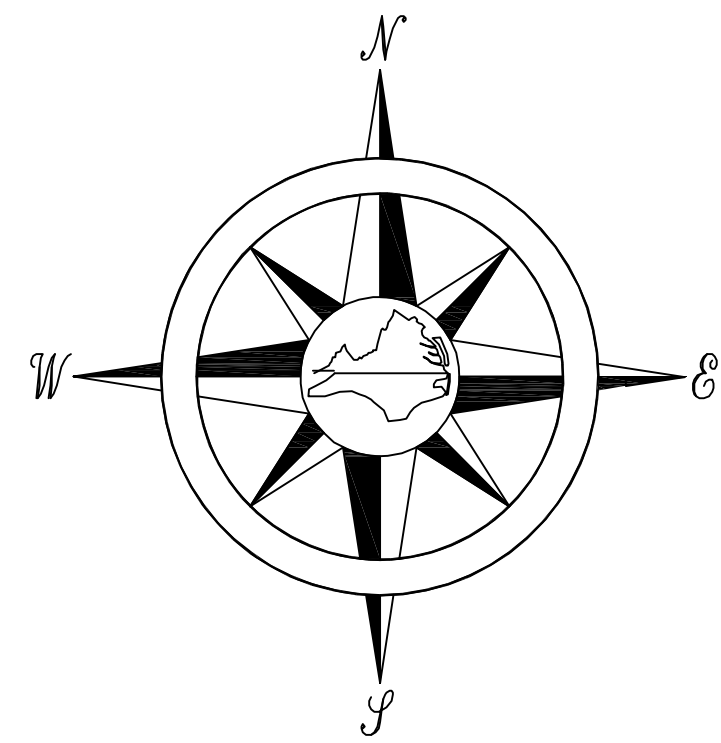


EX LAKEWOOD
FOREST WELL #1

EX LAKEWOOD
FOREST WELL #1

APPROX. LOCATION OF
ABANDONED WATERLINE


- LEGEND
- VALVE
 - HYDRANT
 - AIR/RELEASE VALVE (A.R.V.)
 - ↑ SERVICE LINE W/ METER
 - SNAKE PIT (S.P.)

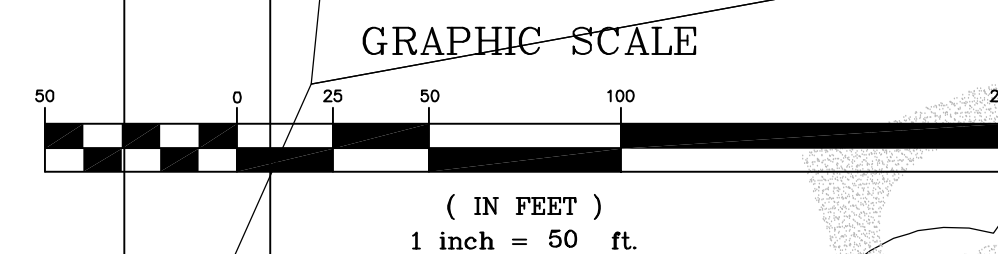

BENCHMARK Surveying & Design, PLC
5017 ARARAT HIGHWAY, ARARAT, VIRGINIA 24053
PATRICK N. HALL L.S. #2667

REVISIONS
NO. DATE DESCRIPTION

DATE
9/07/20

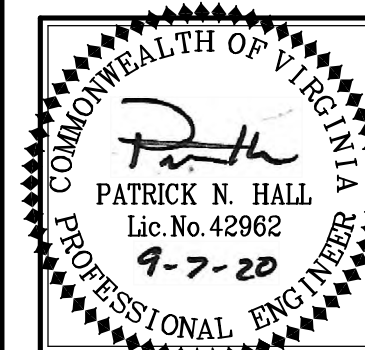

AS-BUILT SURVEY

LAKEWOOD FOREST & WEATHERWOOD INTERCONNECTION


C12

SHEET 12 of 13



- LEGEND
- VALVE
 - HYDRANT
 - AIR/RELEASE VALVE (A.R.V.)
 - ▼ SERVICE LINE W/ METER
 - SNAKE PIT (S.P.)

- LEGEND
- VALVE
 - HYDRANT
 - AIR/RELEASE VALVE (A.R.V.)
 - ▼ SERVICE LINE W/ METER
 - SNAKE PIT (S.P.)

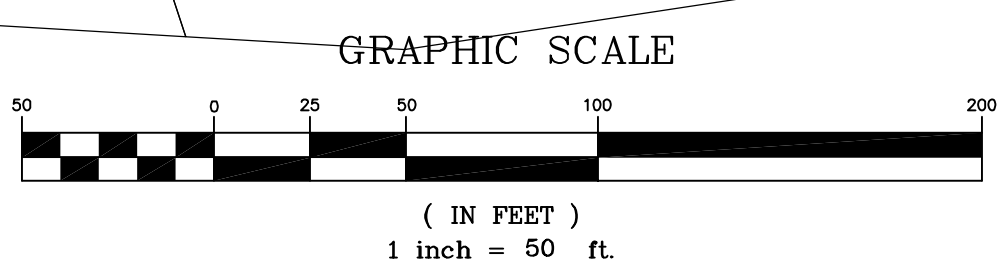

BENCHMARK Surveying & Design, PLC
5017 ARARAT HIGHWAY, ARARAT, VIRGINIA 24053
PATRICK N. HALL L.S. #2667

REVISIONS	
NO.	DATE

DATE 9/7/20	
----------------	--

AS-BUILT SURVEY

LAKEWOOD FOREST & WEATHERWOOD INTERCONNECTION

C13
SHEET 13 of 13