

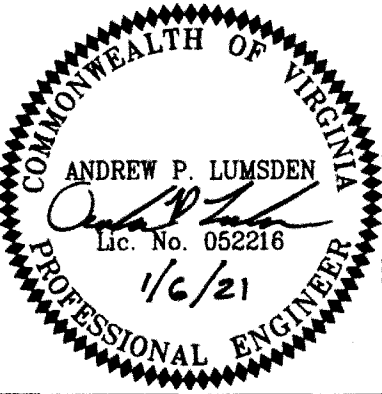


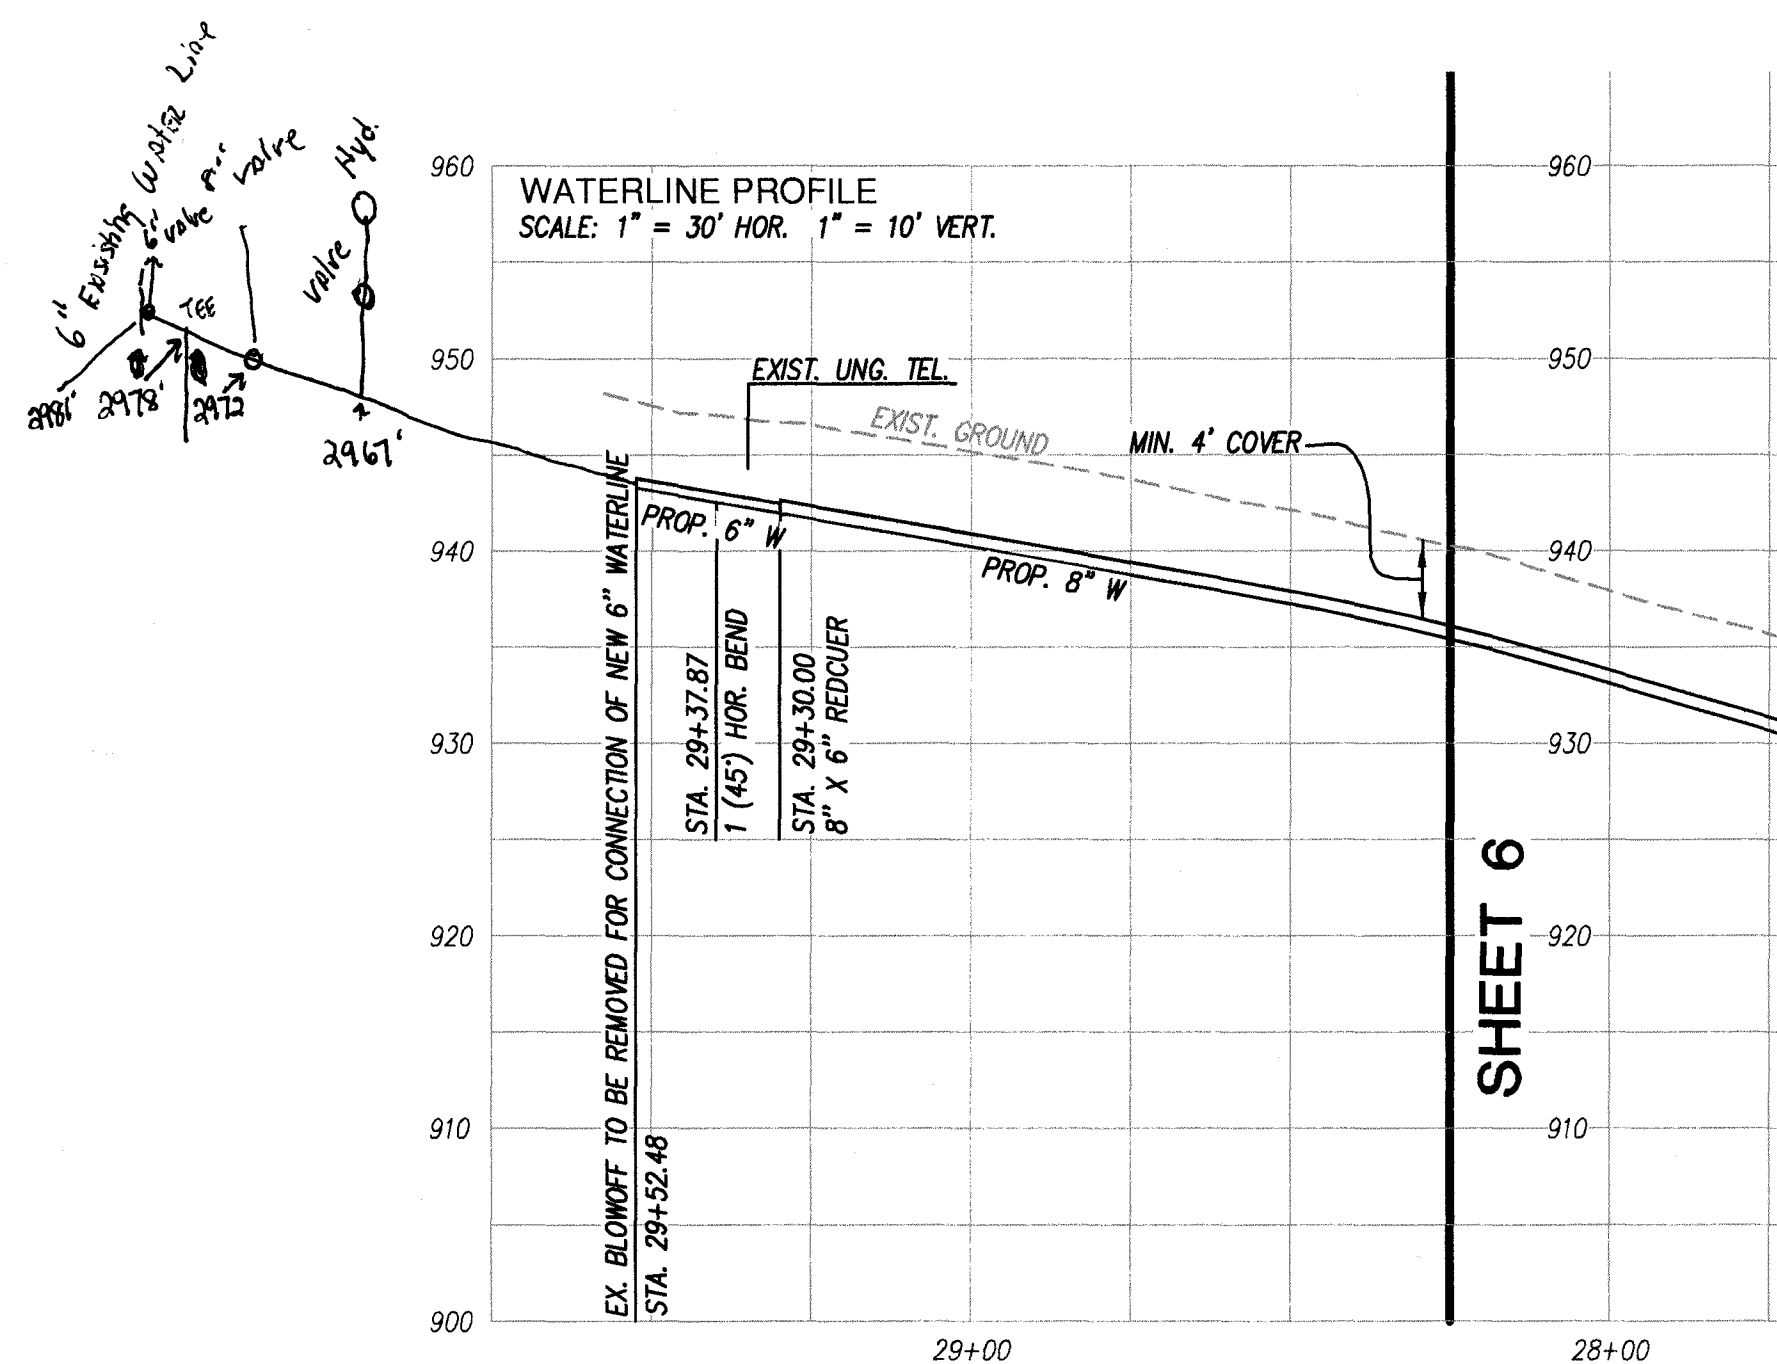

Tie in at the Existing 6" Line at Tank
the Line going across the Road is a 4" SDR21
10' Hydr
10' Hydr

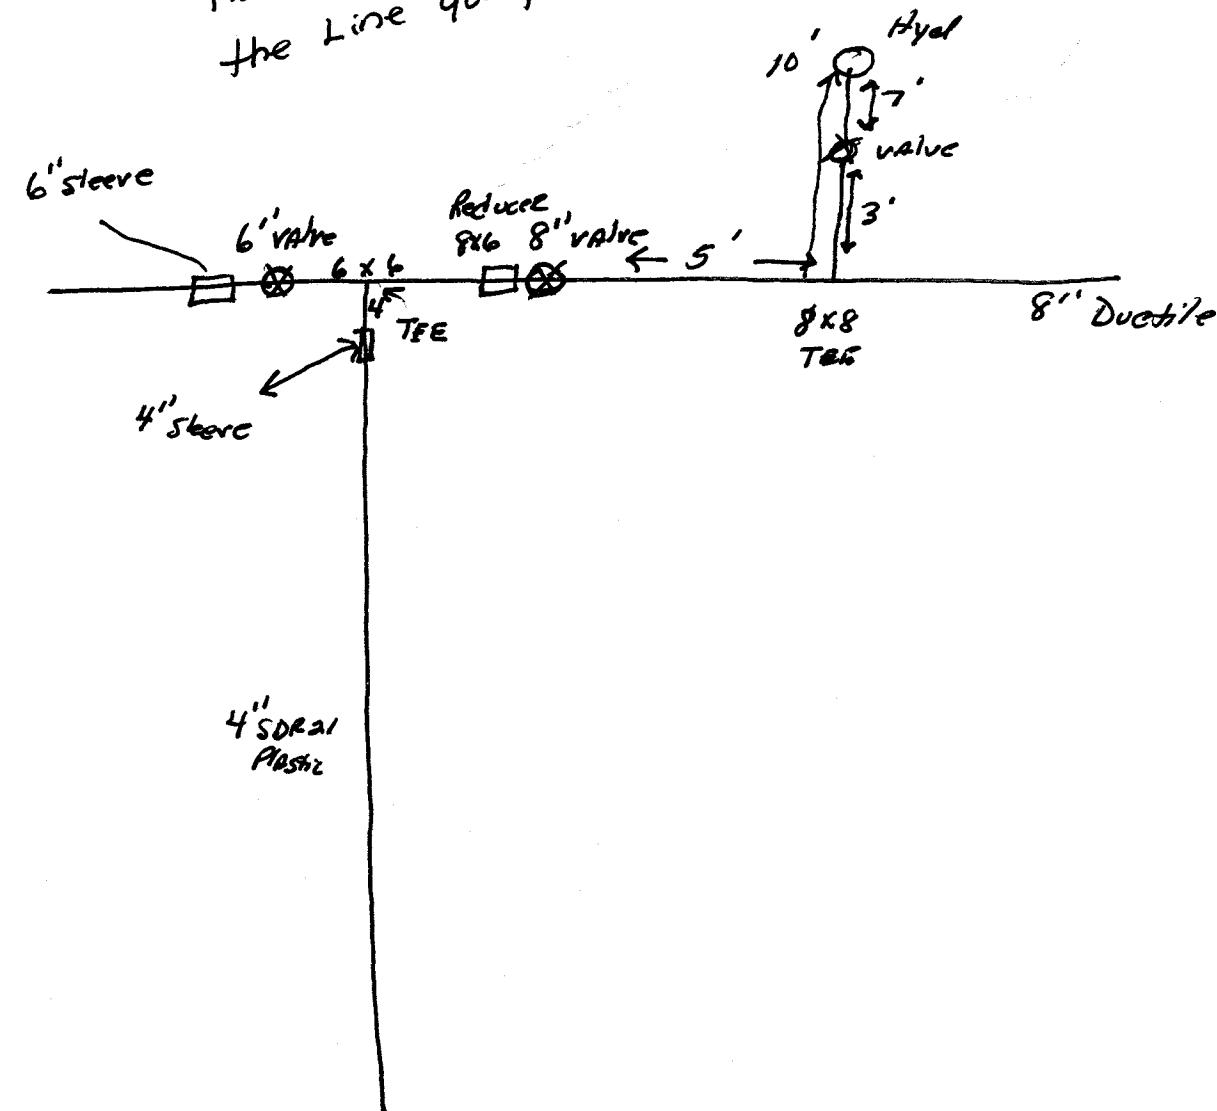

PLAN & PROFILE

**STAROVER LAKE
WATERLINE EXTENSION
PREPARED FOR
WESTERN VIRGINIA WATER AUTHORITY
SITUATED IN
FRANKLIN COUNTY, VIRGINIA**

REVISIONS		
NO.	DATE	DESCRIPTION
1		
2		
3		
4		
5		

DATE: January 6, 2021

SCALE: $1'' = 30'$

COMMISSION NO: 19-285