




NOTE:
Water line and appurtenances built as REDLINE shows hereon.
Sewer line built as designed.

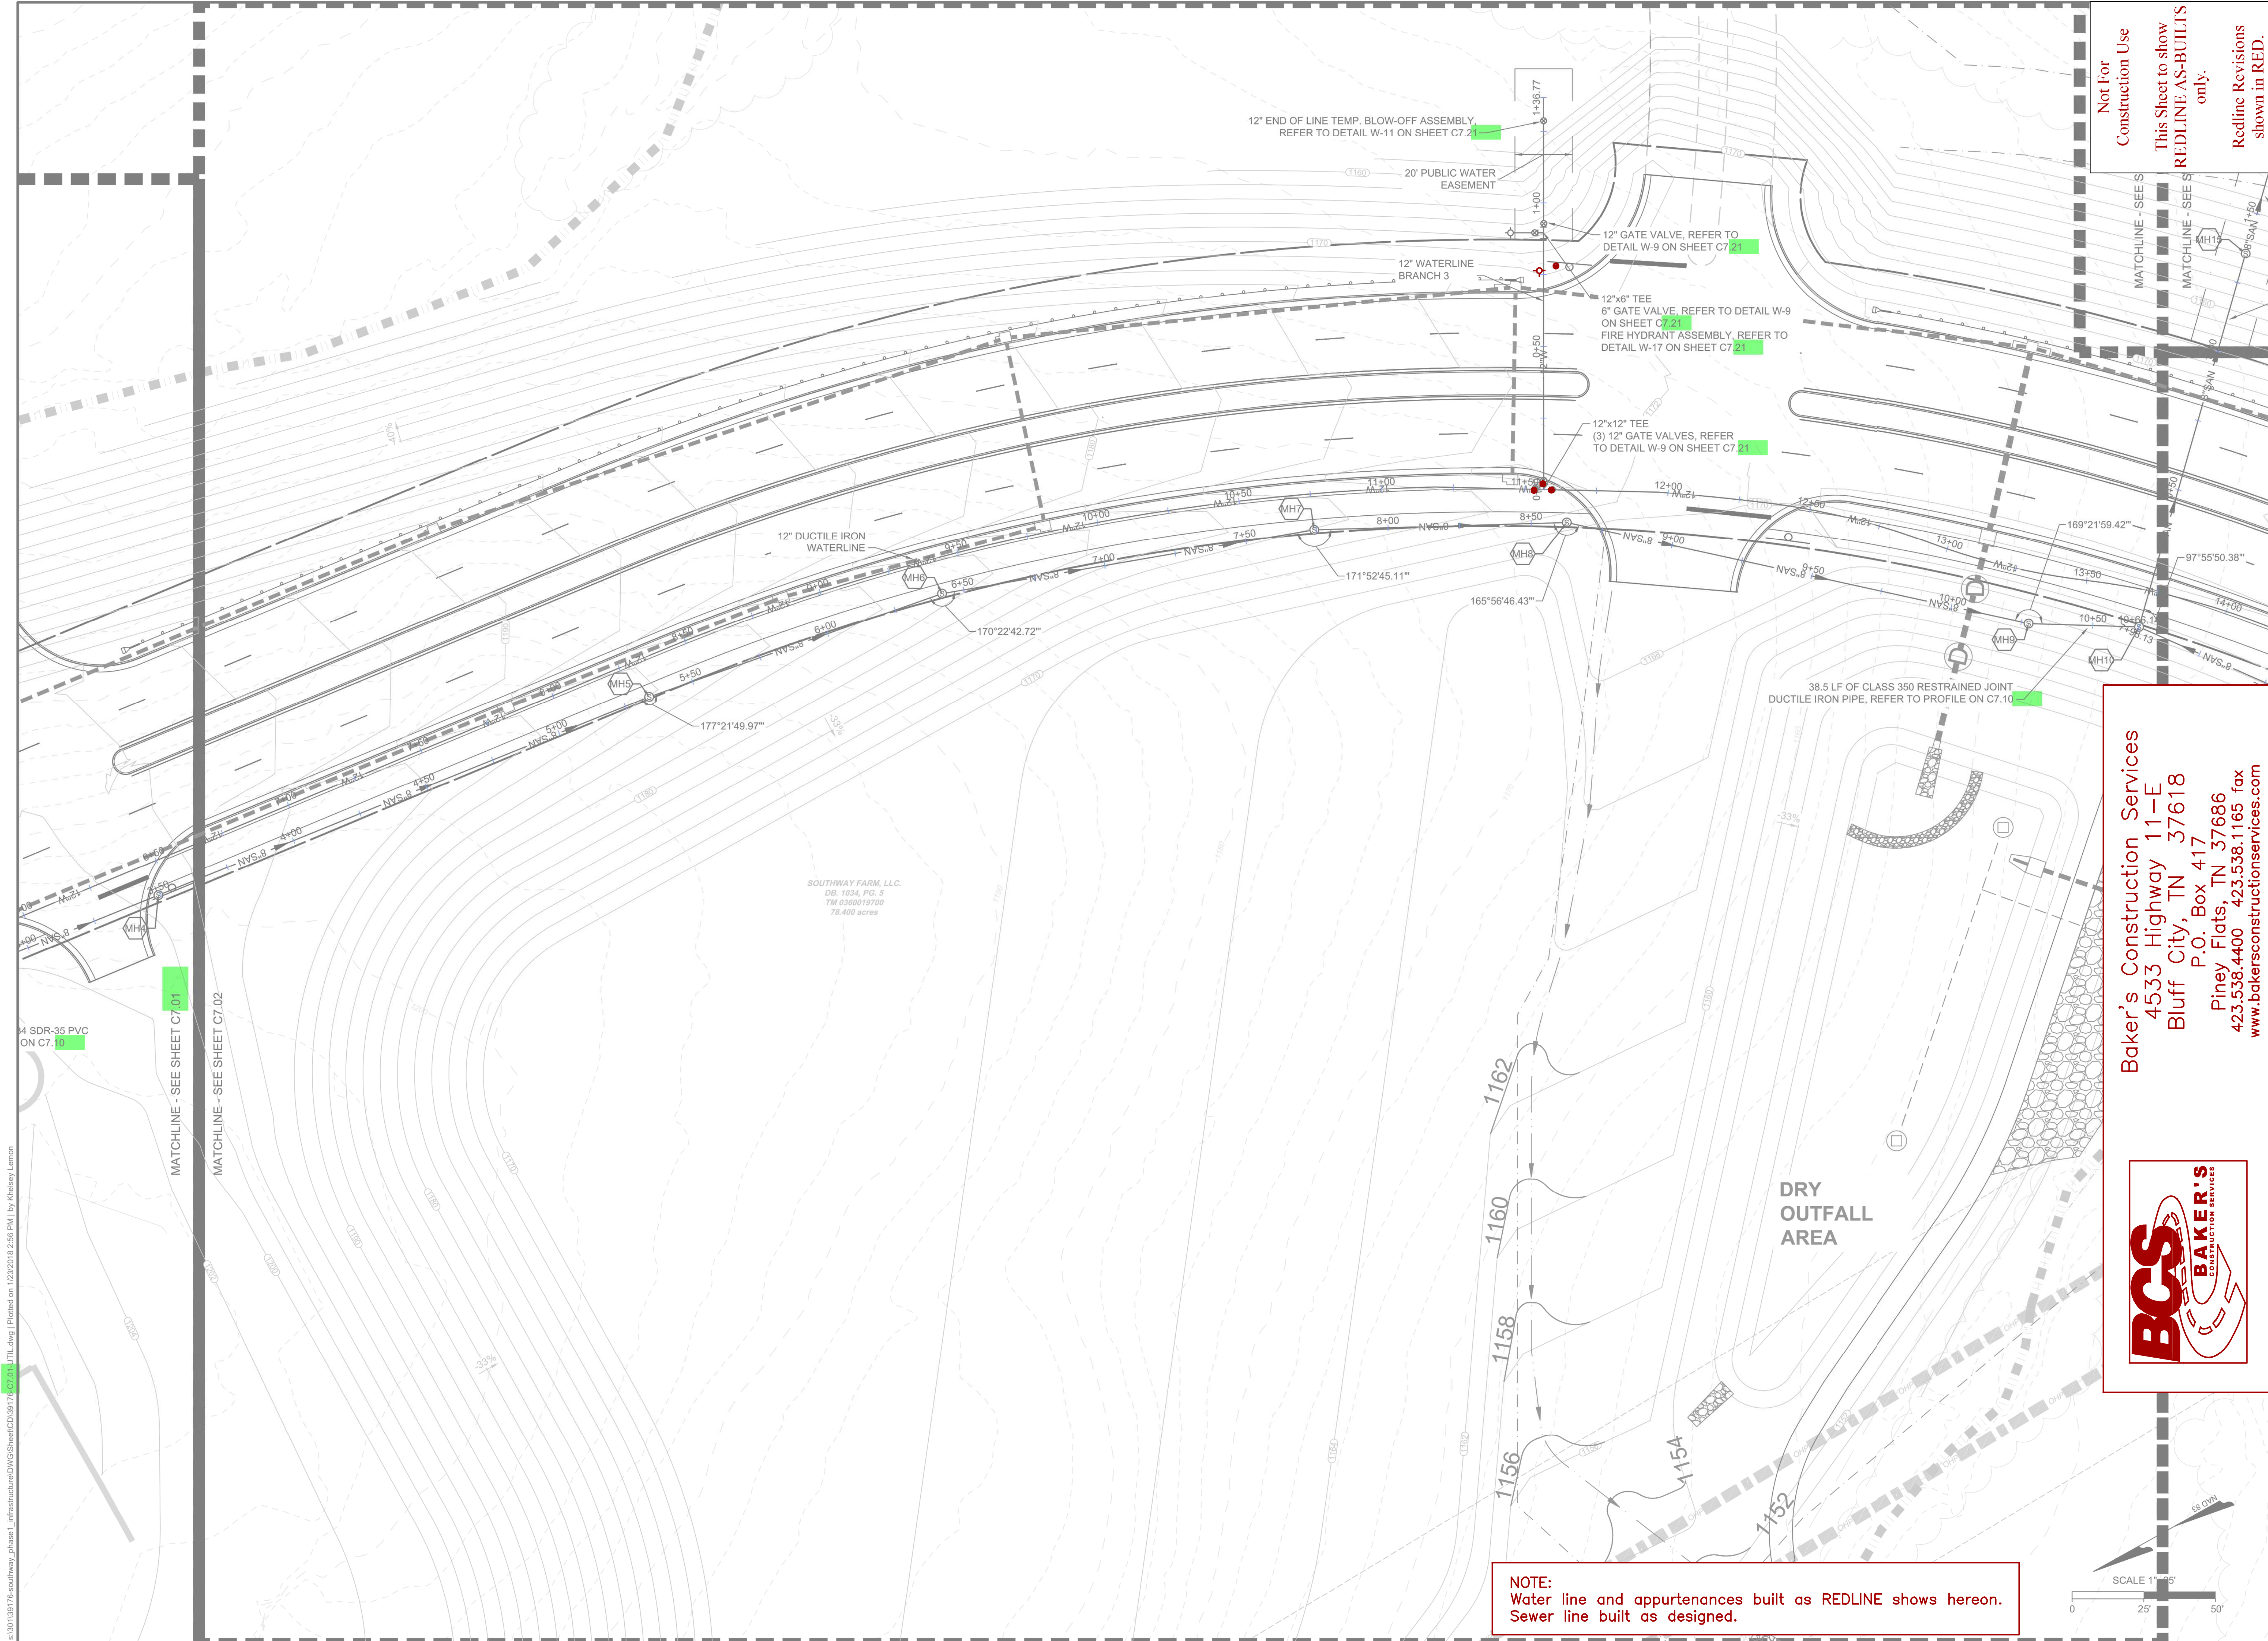

Baker's Construction Services
4533 Highway 11-E
Bluff City, TN 37618
P.O. Box 417
Piney Flats, TN 37686
423.538.4400 423.538.1165 fax
www.bakersconstructionservices.com

Not For Construction Use
This Sheet to show REDLINE AS-BUILTS only.
Redline Revisions shown in RED.



YOUR VISION ACHIEVED THROUGH OURS.

THIS DRAWING PREPARED AT THE
CORPORATE OFFICE
1001 Boulders Parkway, Suite 300 | Richmond, VA 23225
TEL 804.200.6500 FAX 804.560.1016 www.timmons.com

DATE

08/21/2017

ADDENDUM NO. 8

09/15/2017

REVISIONS PER VDOT COMMENTS

09/28/2017

REVISIONS PER COUNTY FOR BORROW AREA

12/13/2017

FINAL PRINTING

01/04/2018

ENTRANCE ROAD ADDITION

07/19/2018

WATERLINE PHASING REVISION

07/23/2018

FINAL COUNTY SET

REVISION DESCRIPTION

08/21/2017

09/15/2017

09/28/2017

12/13/2017

01/04/2018

07/19/2018

07/23/2018

DRAWN BY

D.O.

DESIGNED BY

R.S.

CHECKED BY

K.P.

SCALE

1" = 25'

JOB NO.

39176

SHEET NO.

C7.02-R

SUMMIT VIEW BUSINESS PARK PHASE 1

FRANKLIN COUNTY, VA

WATER & SEWER PLAN

REDLINE

REDLINE

These plans and associated documents are the exclusive property of TIMMONS GROUP and may not be reproduced in whole or in part and shall not be used for any purpose whatsoever, inclusive, but not limited to construction, bidding, and/or construction staking without the express written consent of TIMMONS GROUP.