



L:\20341271-Summit_View\UDWG\Sheet\CD\41271-203C-03.dwg | Plotted on 5/7/2019 11:52 AM | by Ian Hogan

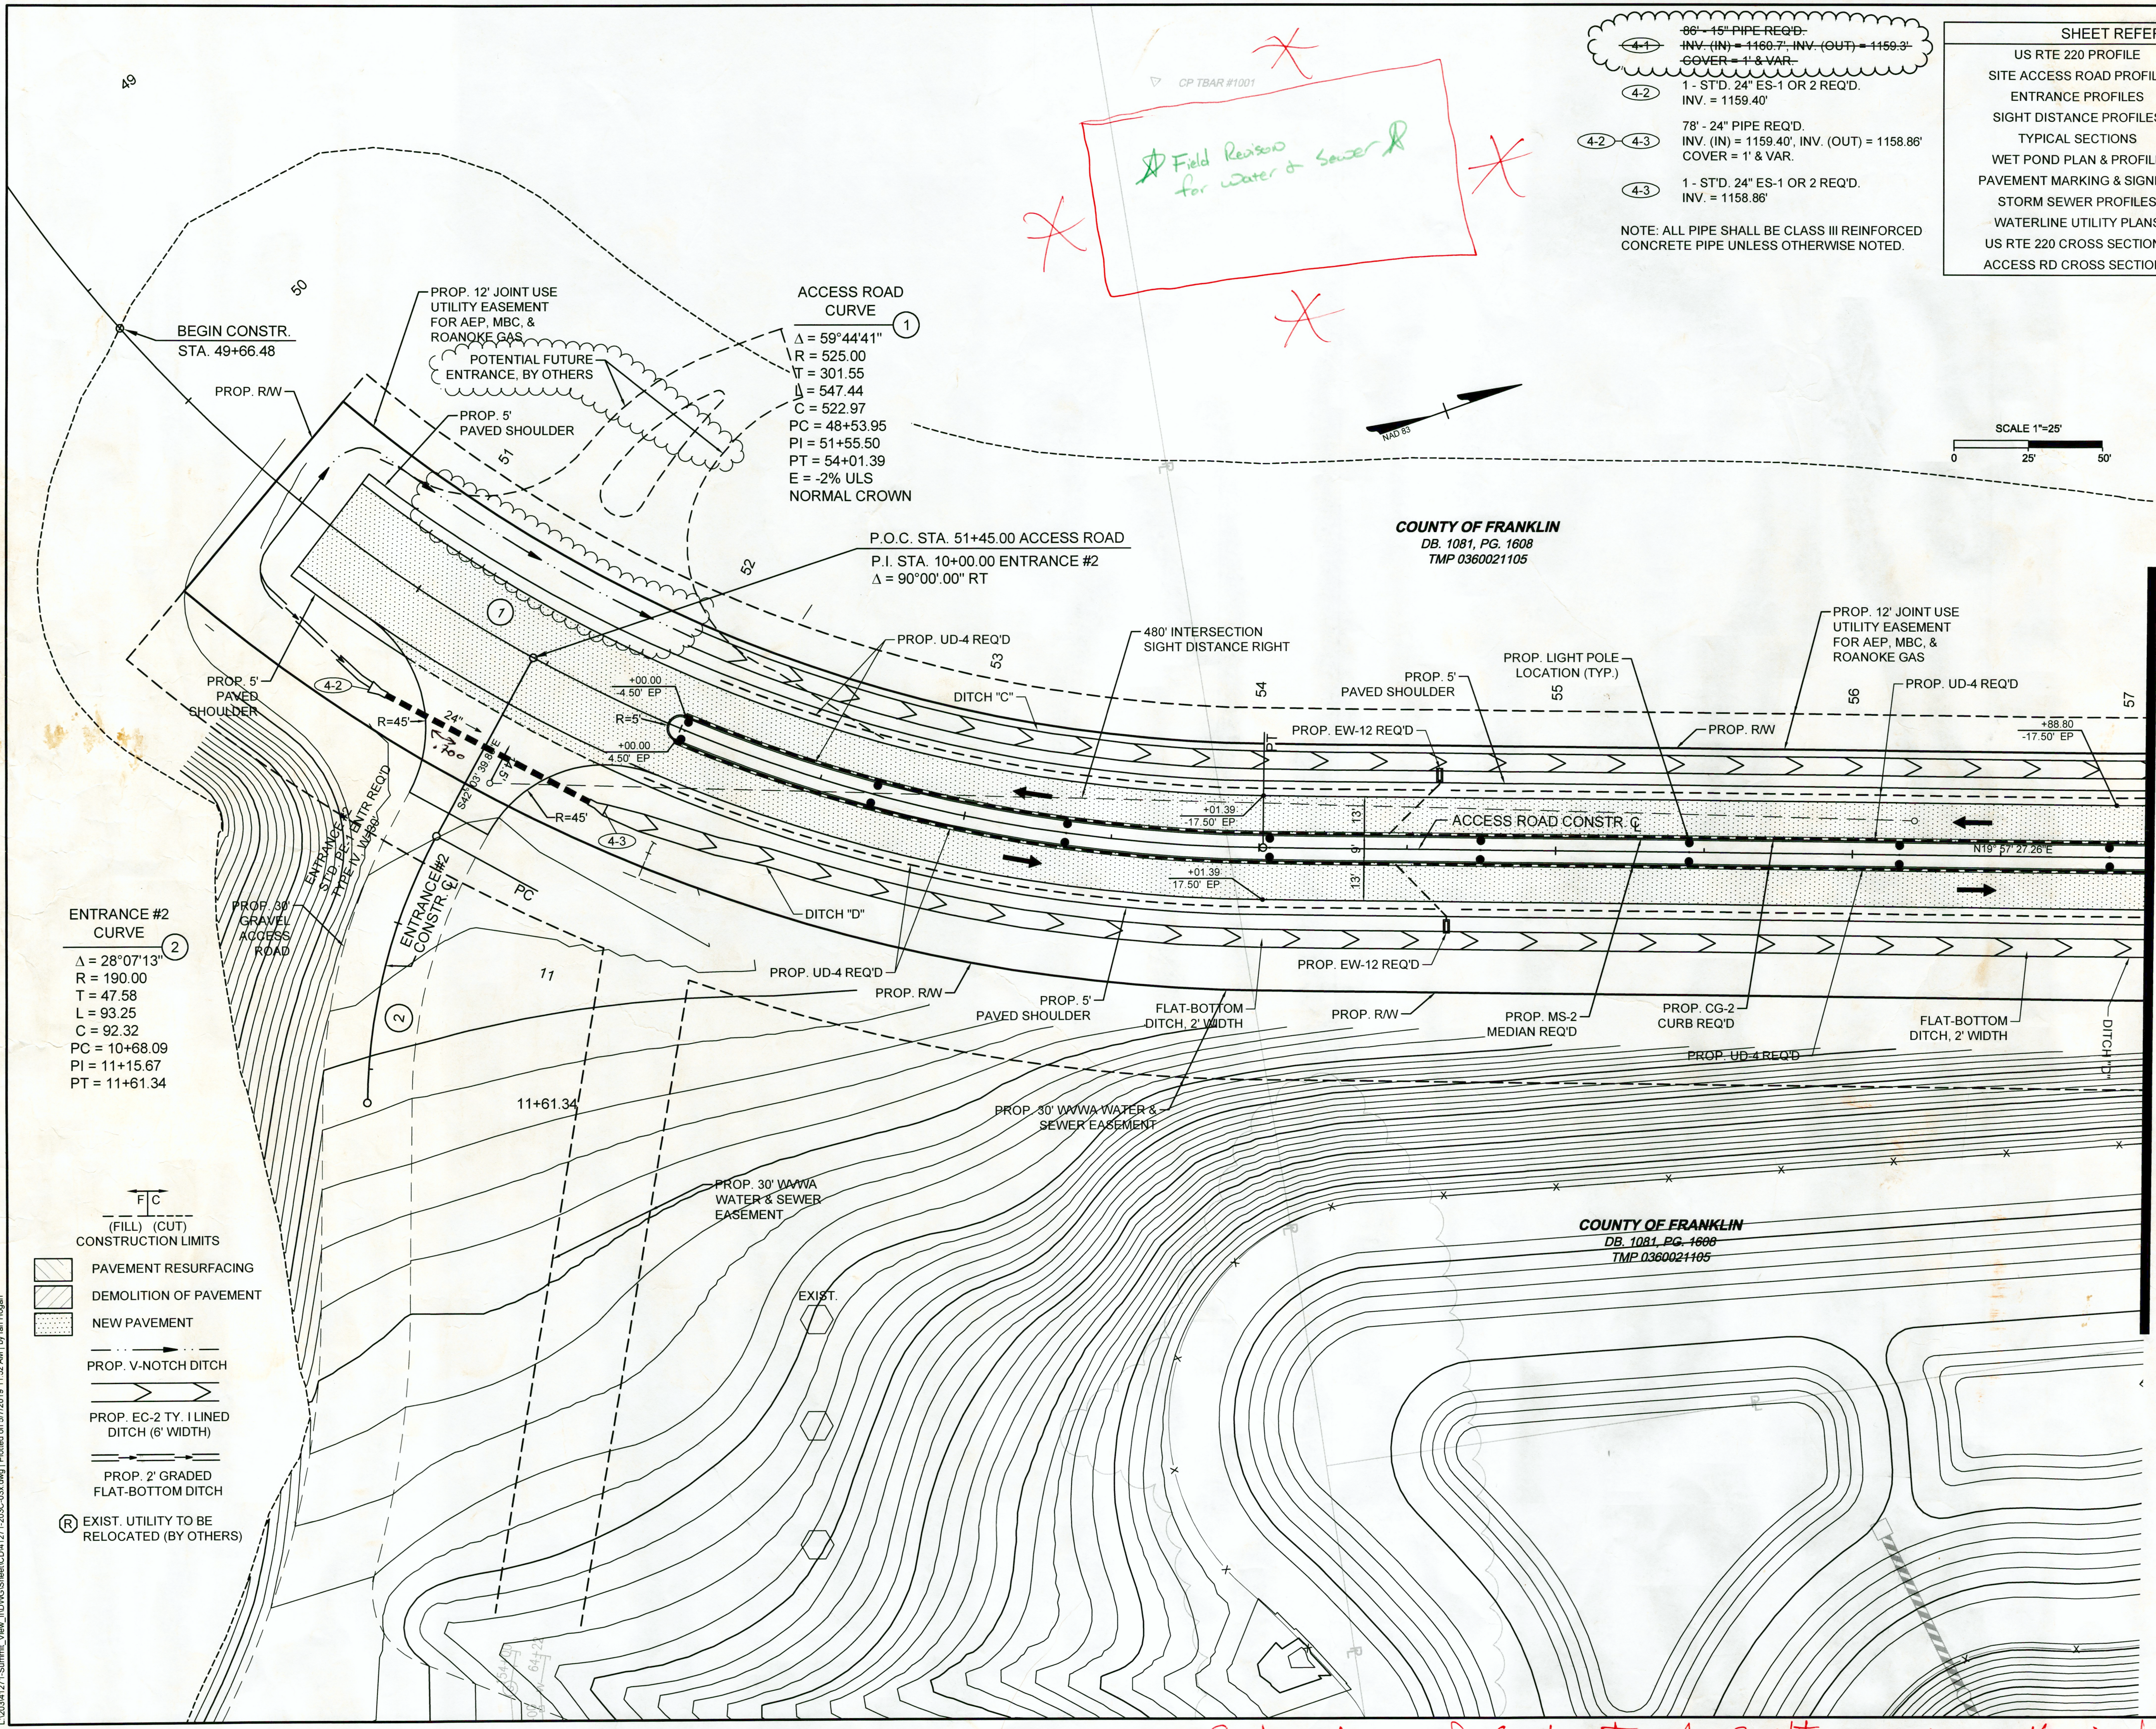

MATCHLINE SHEET 3 - STA. 57+00.00

SHEET REFERENCES	
US RTE 220 PROFILE	3A
SITE ACCESS ROAD PROFILE	3B, 4A
ENTRANCE PROFILES	4B
SIGHT DISTANCE PROFILES	3C, 4C
TYPICAL SECTIONS	2
WET POND PLAN & PROFILE	2C(6)
PAVEMENT MARKING & SIGNING	2H - 2J
STORM SEWER PROFILES	5 - 5A
WATERLINE UTILITY PLANS	6(3) - 6(6)
US RTE 220 CROSS SECTIONS	XS-1 - XS-14
ACCESS RD CROSS SECTIONS	XS-15 - XS-28

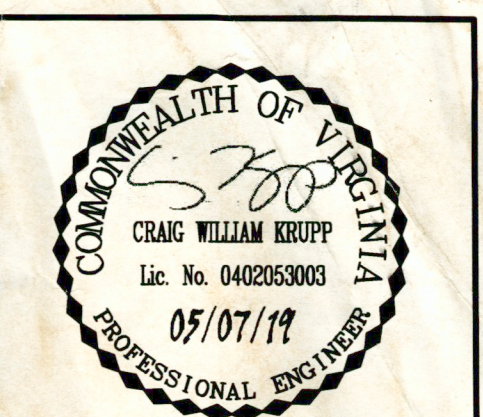

THIS DRAWING PREPARED AT THE	
CORPORATE OFFICE	
1001 Builders Park, Springfield, VA 22150	
TEL 804.206.6500 FAX 804.560.1016 www.timmons.com	
YOUR VISION ACHIEVED THROUGH OURS.	
Site Development	Residential
Technology	
DATE	REVISION DESCRIPTION
06/13/18	PER COUNTY AND VDOT COMMENTS
08/29/18	PER COUNTY AND VDOT COMMENTS
10/03/18	PER COUNTY AND VDOT COMMENTS
03/12/19	WATERLINE & SAN. SEWER COMMENT REVISIONS
05/07/19	ENTRANCE #1 GEOMETRIC AND DRAINAGE REVISIONS

DATE	05/07/19
DRAWN BY	MRF
DESIGNED BY	CWK
CHECKED BY	CMK
SCALE	1" = 25'

TIMMONS GROUP

SUMMIT VIEW BUSINESS PARK PHASE II
BOONE DISTRICT - FRANKLIN COUNTY - VIRGINIA

SITE ACCESS ROAD PLAN SHEET

JOB NO.	41271
SHEET NO.	4

Continuation of Contractor As-Builts 10.16.19 K. Winslow