


L:\334\127-Summit_View_ILDWGSheetCD41271-203C-33A.dwg Plotted on 5/7/2019 11:52 AM by Ian Hogan

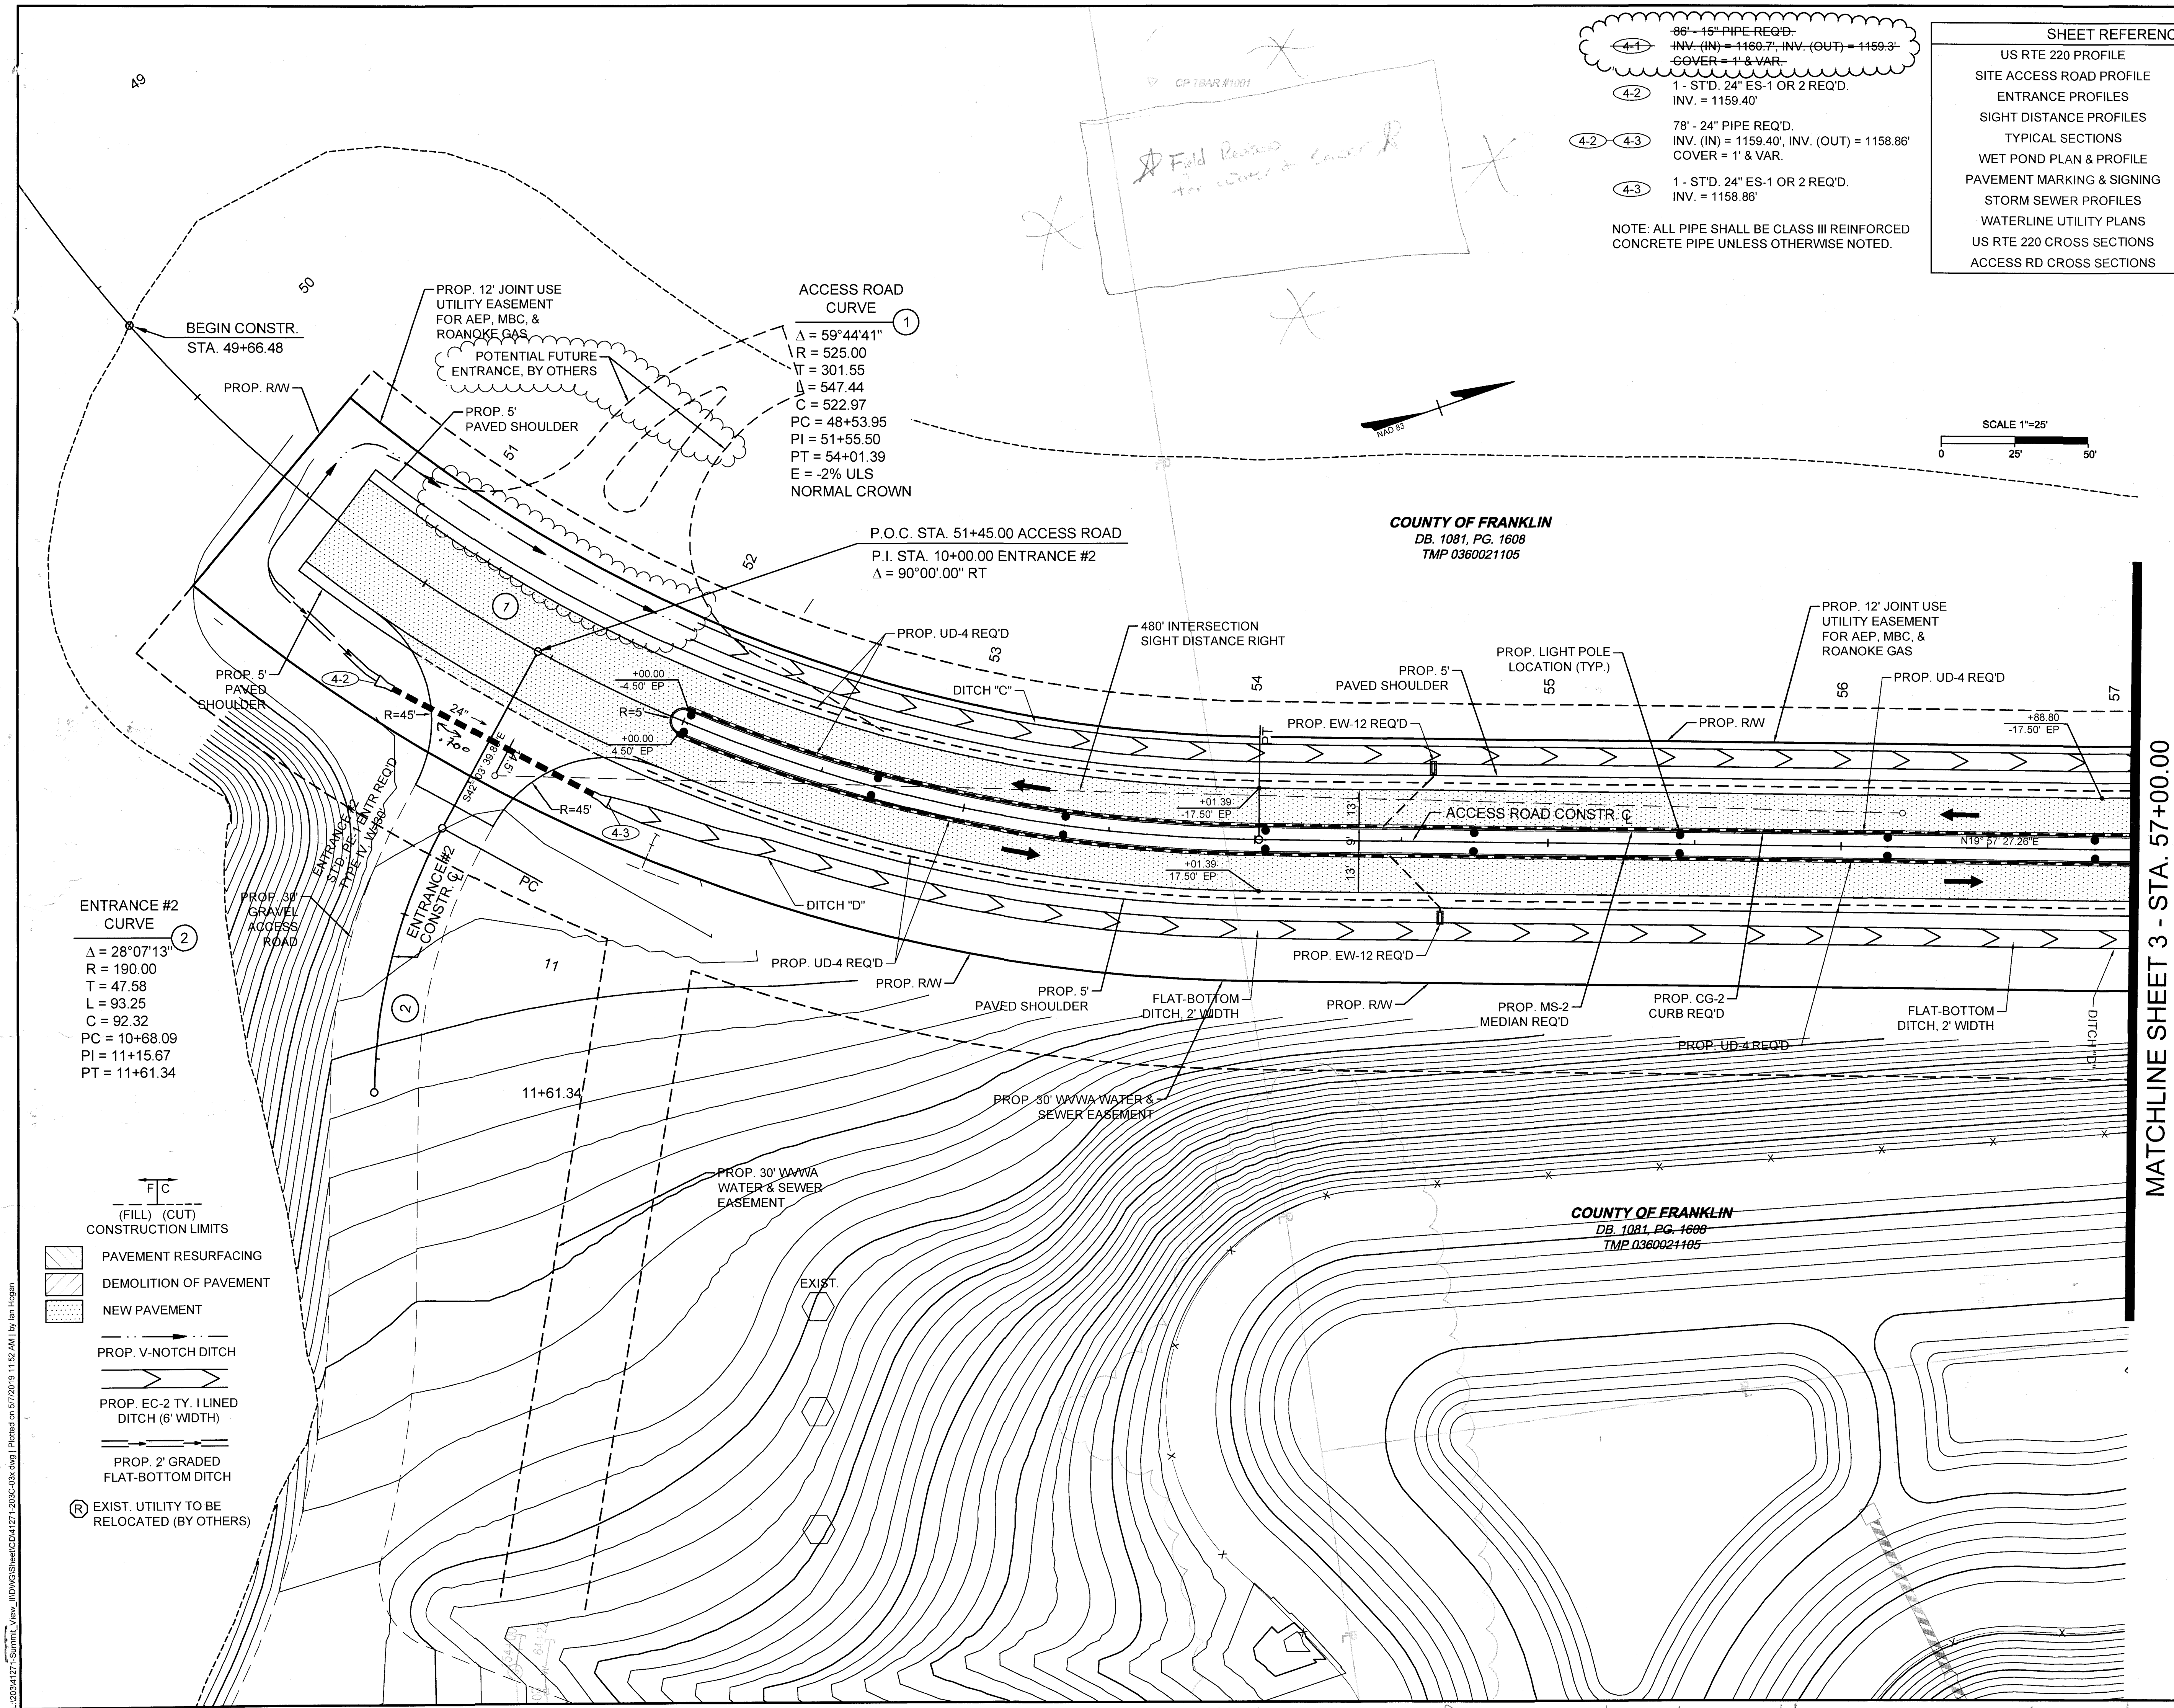


Continuation of Contractor As-Builts 10.16.19 K. Winslow

- 8" - 15" PIPE REQ'D.
INV. (IN) = 1159.7', INV. (OUT) = 1159.3'
COVER = 1' & VAR.
- 1 - STD. 24" ES-1 OR 2 REQ'D.
INV. = 1159.40'
- 78" - 24" PIPE REQ'D.
INV. (IN) = 1159.40', INV. (OUT) = 1158.86'
COVER = 1' & VAR.
- 1 - STD. 24" ES-1 OR 2 REQ'D.
INV. = 1158.86'

NOTE: ALL PIPE SHALL BE CLASS III REINFORCED CONCRETE PIPE UNLESS OTHERWISE NOTED.

SHEET REFERENCES	
US RTE 220 PROFILE	3A
SITE ACCESS ROAD PROFILE	3B, 4A
ENTRANCE PROFILES	4B
SIGHT DISTANCE PROFILES	3C, 4C
TYPICAL SECTIONS	2
WET POND PLAN & PROFILE	2C(6)
PAVEMENT MARKING & SIGNING	2H - 2J
STORM SEWER PROFILES	5 - 5A
WATERLINE UTILITY PLANS	6(3) - 6(6)
US RTE 220 CROSS SECTIONS	XS-1 - XS-14
ACCESS RD CROSS SECTIONS	XS-15 - XS-28

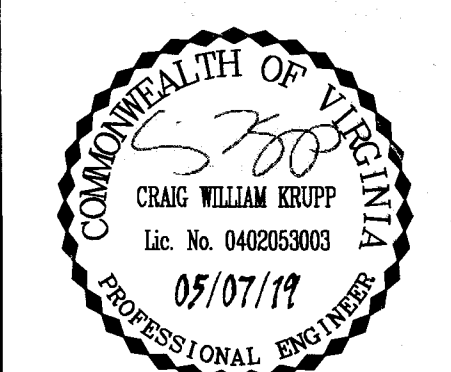

THIS DRAWING PREPARED AT THE	
CORPORATE OFFICE	
1001 Builders Parkway, Suite 300 Richmond, VA 23225	
TEL 804-260-6300 FAX 804-560-1010 www.timmons.com	
YOUR VISION. ACHIEVED THROUGH OURS.	
Site Development	Infrastructure Technology
DATE	REVISION DESCRIPTION
06/13/18	PER COUNTY AND VDOT COMMENTS
08/29/18	PER COUNTY AND VDOT COMMENTS
10/03/18	PER COUNTY AND VDOT COMMENTS
03/12/19	WATERLINE & SAN. SEWER COMMENT REVISIONS
05/07/19	ENTRANCE #1 GEOMETRIC AND DRAINAGE REVISIONS

SUMMIT VIEW BUSINESS PARK PHASE II
BOONE DISTRICT - FRANKLIN COUNTY - VIRGINIA
SITE ACCESS ROAD PLAN SHEET

REPRODUCED IN WHOLE OR IN PART AND SHALL NOT BE USED FOR ANY PURPOSE WHATSOEVER, INCLUSIVE, BUT NOT LIMITED TO, REPRODUCTION, TRANSMISSION, OR DISTRIBUTION IN ANY FORM OR BY ANY MEANS, WITHOUT THE WRITTEN PERMISSION OF TIMMONS GROUP, INC.