
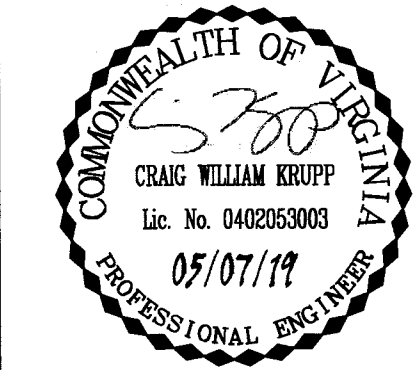
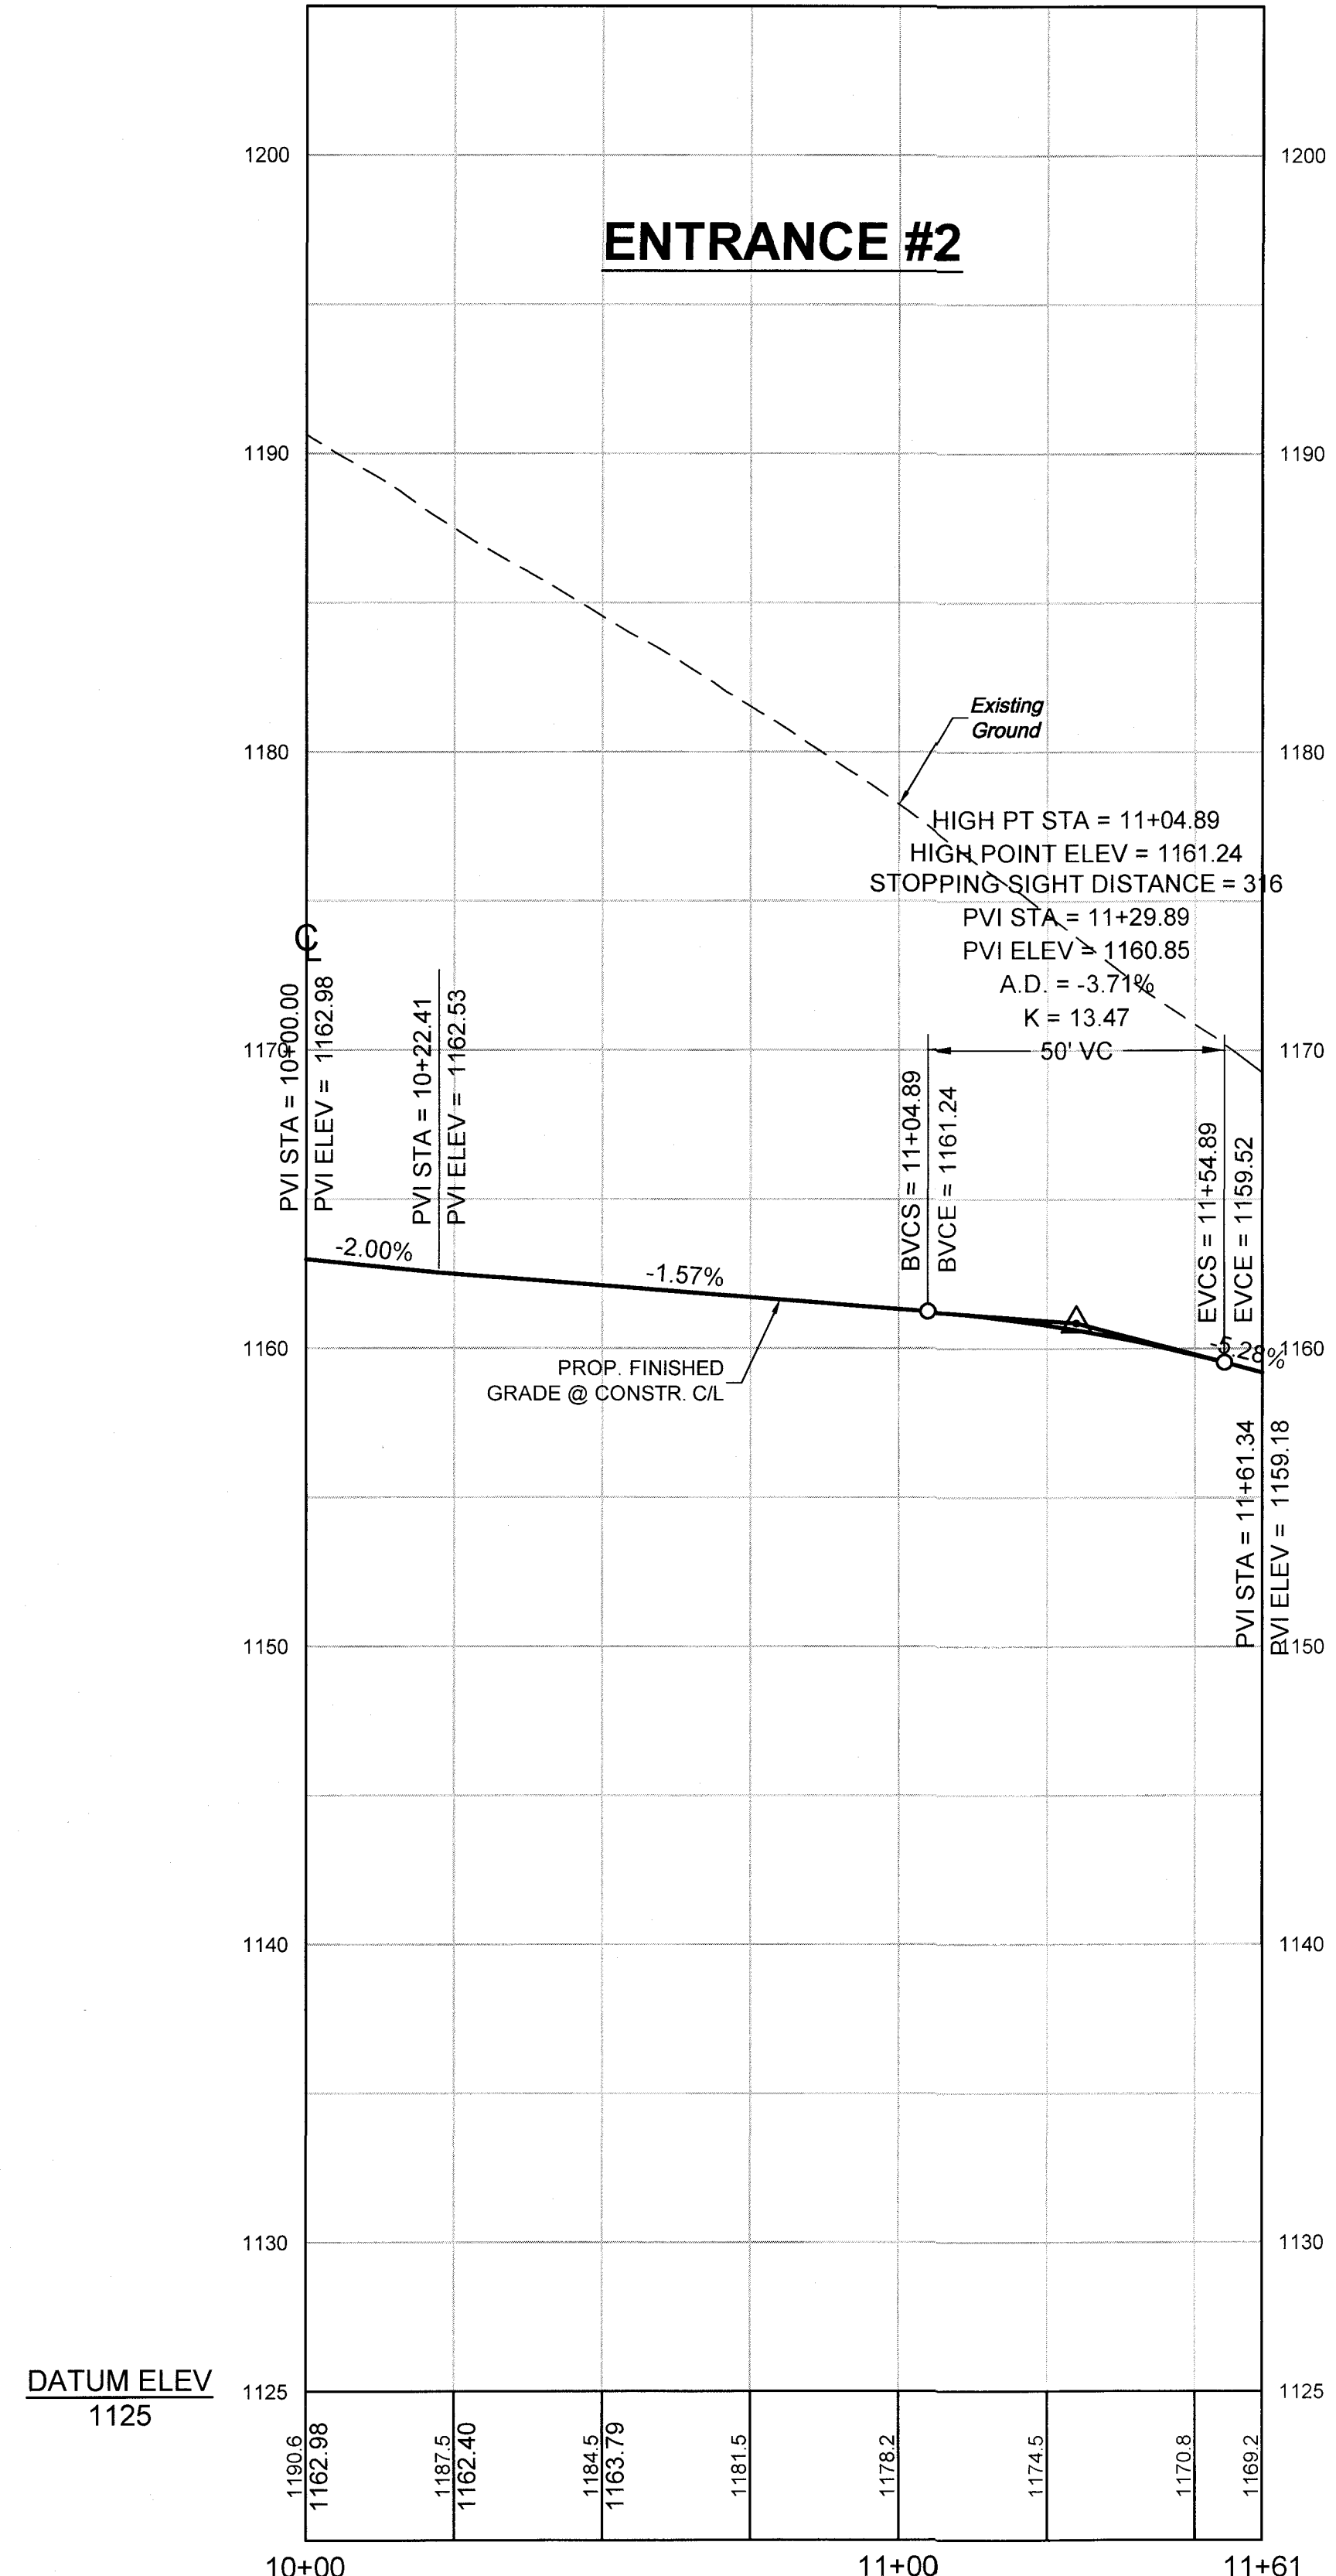


L:\20341271-Summit_View_JUDWGSheetCD\41271-203C-03A.dwg | Plotted on 5/7/2019 11:51 AM | by Ian Hogan

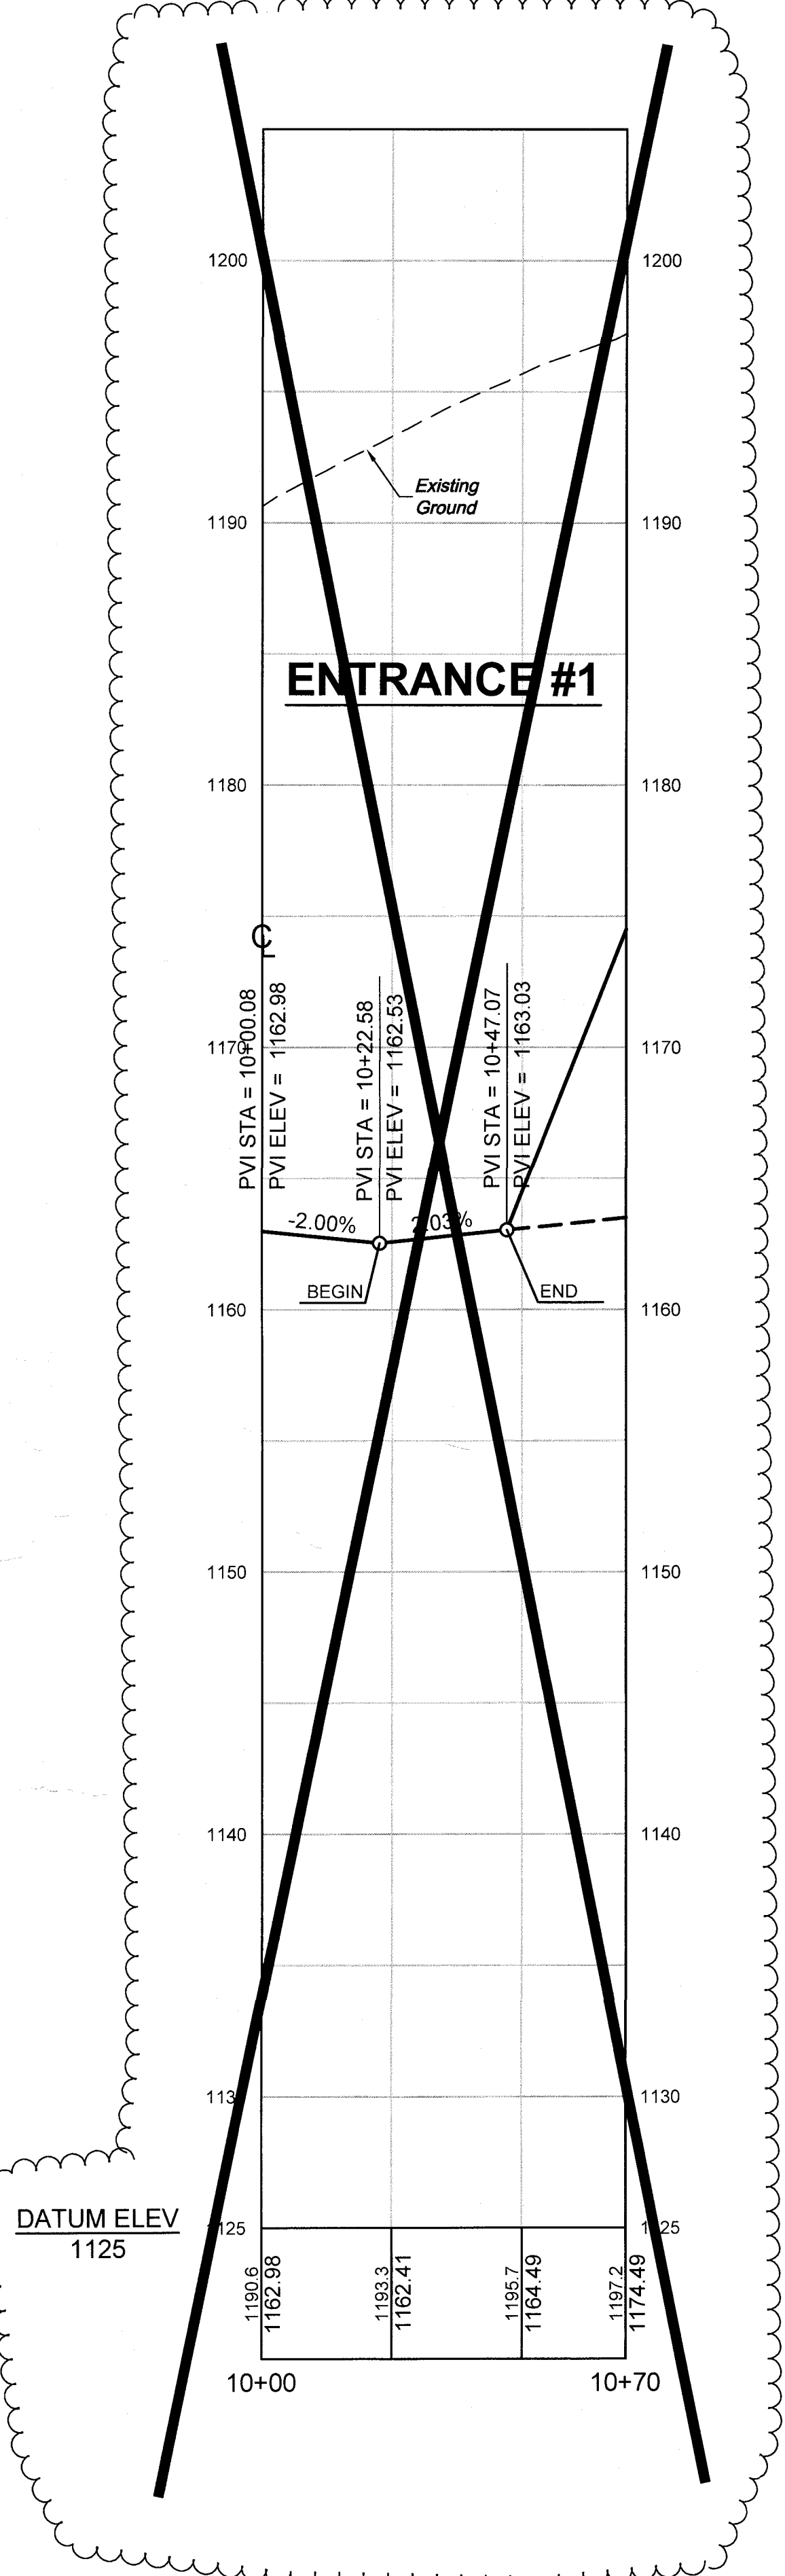

THIS DRAWING PREPARED AT THE
CORPORATE OFFICE
1001 Boulevard Parkway
Richmond, VA 23225
TEL 804.200.6500 FAX 804.560.1016 www.timmons.com

YOUR VISION ACHIEVED THROUGH OURS.


Site Development	Residential	Infrastructure	Technology
DATE	DATE	REVISION DESCRIPTION	REVISION DESCRIPTION
06/13/18	06/13/18	PER COUNTY AND VDOT COMMENTS	PER COUNTY AND VDOT COMMENTS
09/29/18	09/29/18	PER COUNTY AND VDOT COMMENTS	PER COUNTY AND VDOT COMMENTS
10/03/18	10/03/18	PER COUNTY AND VDOT COMMENTS	PER COUNTY AND VDOT COMMENTS
03/12/19	03/12/19	WATERLINE & SAN. SEWER COMMENT REVISIONS	WATERLINE & SAN. SEWER COMMENT REVISIONS
05/07/19	05/07/19	ENTRANCE #1 GEOMETRIC AND DRAINAGE REVISIONS	ENTRANCE #1 GEOMETRIC AND DRAINAGE REVISIONS

DRAWN BY
MRF

DESIGNED BY
CWK

CHECKED BY
CMK

SCALE
1"=25'

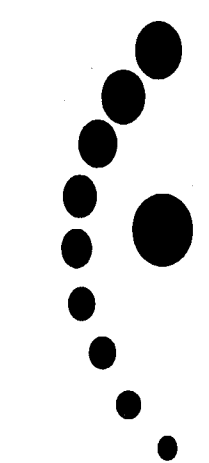

TIMMONS GROUP

SUMMIT VIEW BUSINESS PARK PHASE II

BOONE DISTRICT - FRANKLIN COUNTY - VIRGINIA

ENTRANCE PROFILES

JOB NO.
41271

SHEET NO.
04B

These plans and associated documents are the exclusive property of TIMMONS GROUP and may not be reproduced in whole or in part and shall not be used for any purpose whatsoever, inclusive, but not limited to construction, bidding, and/or construction taking without the express written consent of TIMMONS GROUP.