



L:\2024\1271-Summit_View_11DWG\SheetCD41271-2024-0831x.dwg Plotted on 5/2/2019 9:47 AM by Melvin Fleming

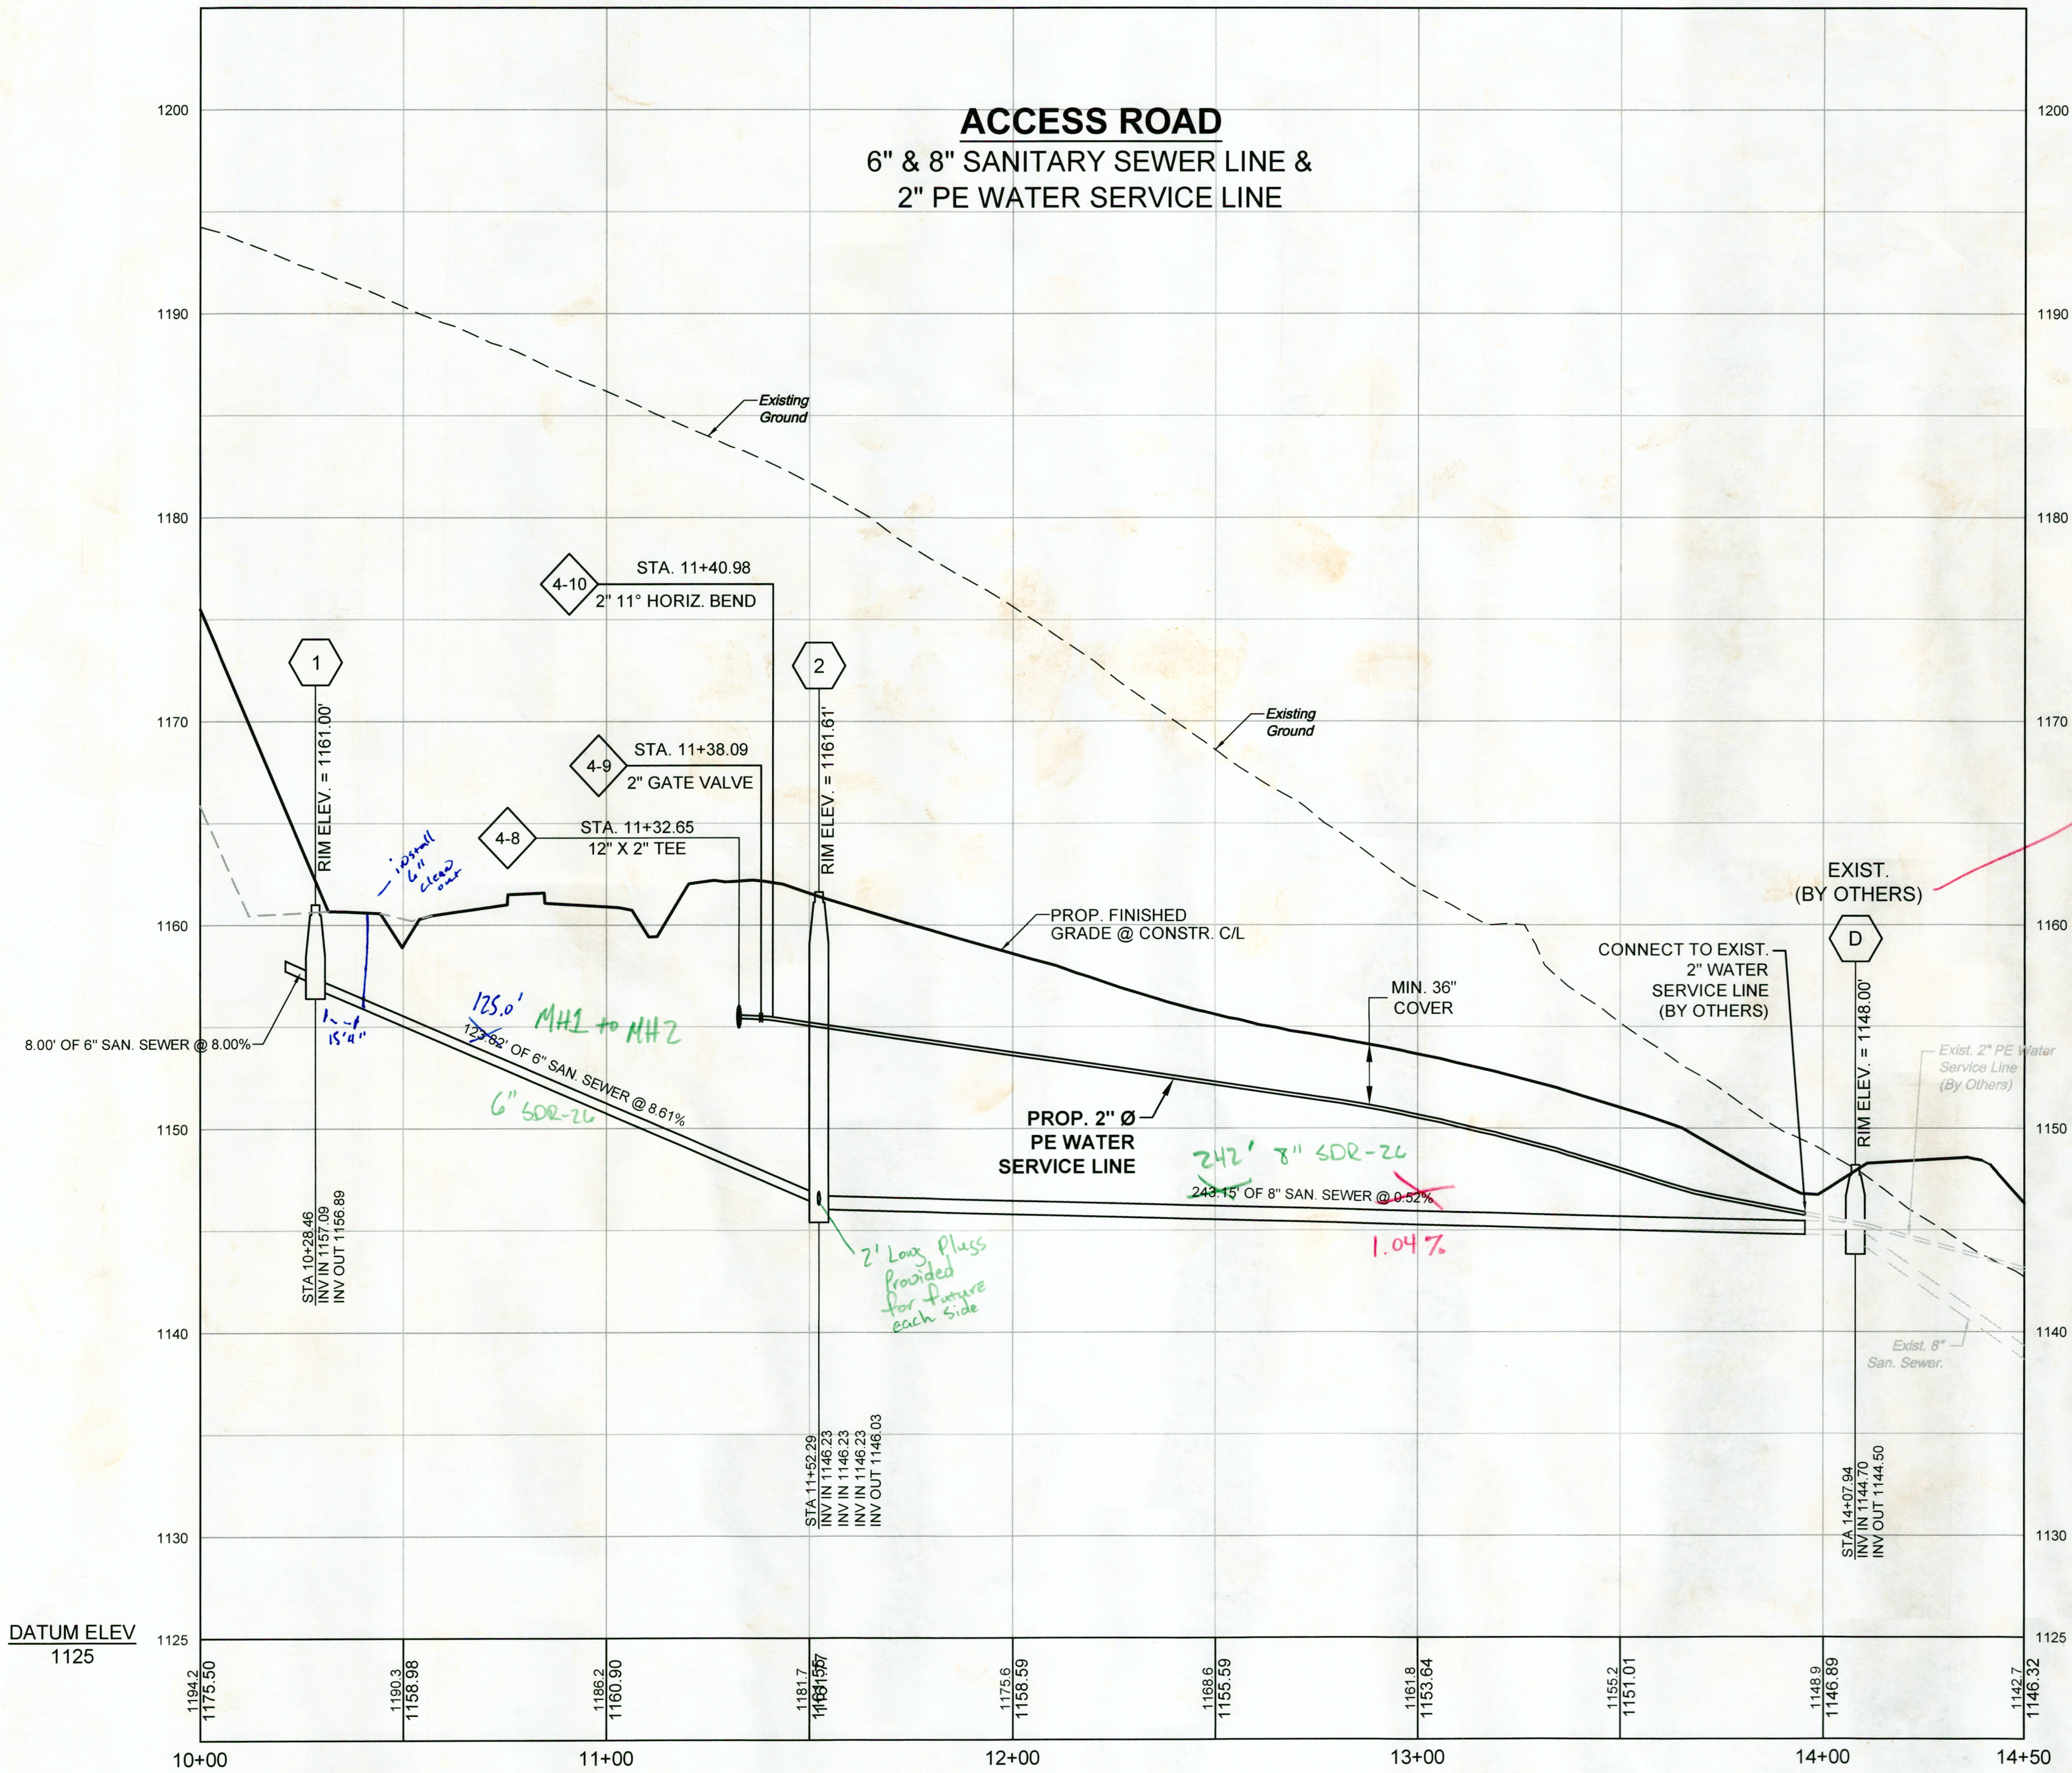

MH installed
By others
Deeper

Line from MHD to MH2 changed
1.04%

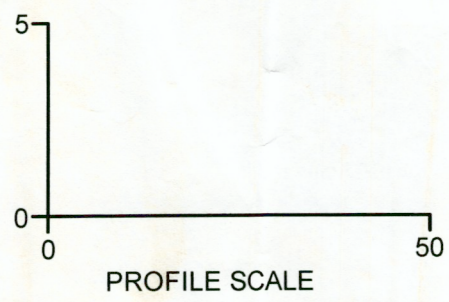

THIS DRAWING PREPARED AT THE CORPORATE OFFICE 1001 Boulder Parkway, Suite 300 Richmond, VA 23225 TEL 804.200.6500 FAX 804.560.1016 www.timmons.com	
YOUR VISION ACHIEVED THROUGH OURS.	
Site Development	Residential
Infrastructure	Technology
DATE	REVISION DESCRIPTION
08/29/18	PER COUNTY AND VDOT COMMENTS
10/03/18	PER COUNTY AND VDOT COMMENTS
03/12/19	WATERLINE & SAN. SEWER COMMENT REVISIONS
05/07/19	ENTRANCE #1 GEOMETRIC AND DRAINAGE REVISIONS
05/21/19	SANITARY SEWER COMMENT REVISIONS

DATE	03/30/18
DRAWN BY	MRF
DESIGNED BY	CKW
CHECKED BY	CMK
SCALE	1"=25'

TIMMONS GROUP

SUMMIT VIEW BUSINESS PARK PHASE II

BOONE DISTRICT - FRANKLIN COUNTY - VIRGINIA

WATER & SEWER PROFILE

JOB NO.
41271

SHEET NO.
6(7)

Please note that the drawings are the exclusive property of TIMMONS GROUP and may not be reproduced in whole or in part and shall not be used for any purpose whatsoever, inclusive, but not limited to, construction, bidding, and/or construction staking without the express written consent of TIMMONS GROUP.