

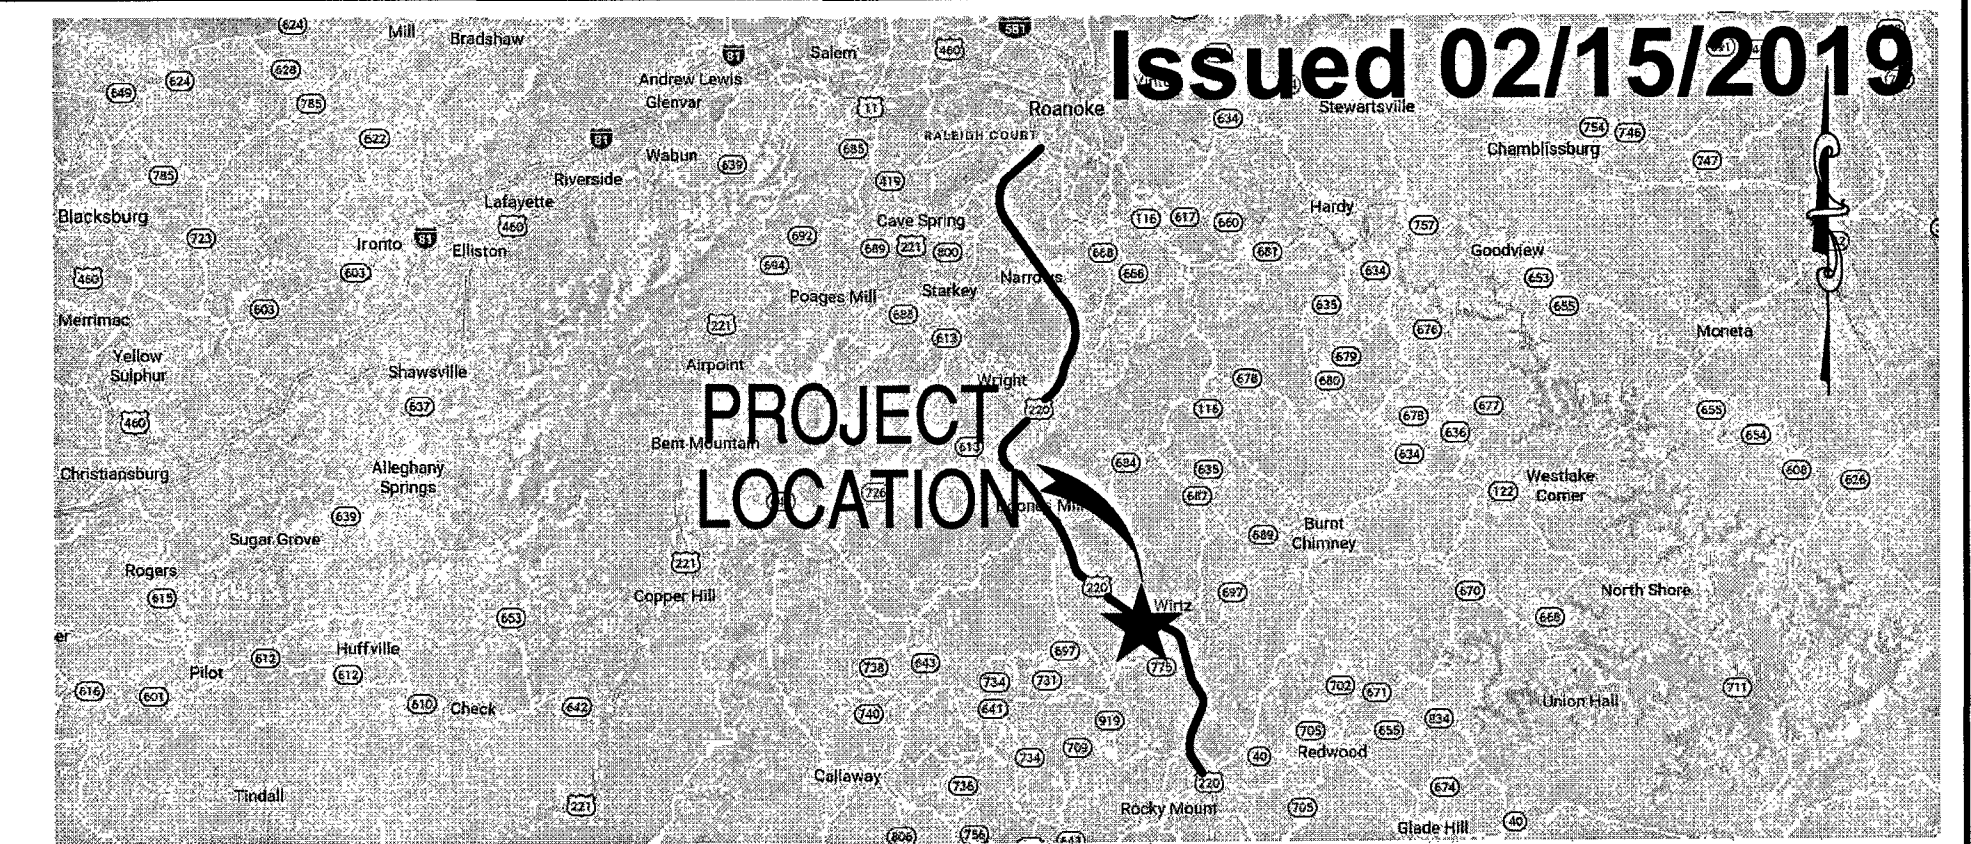


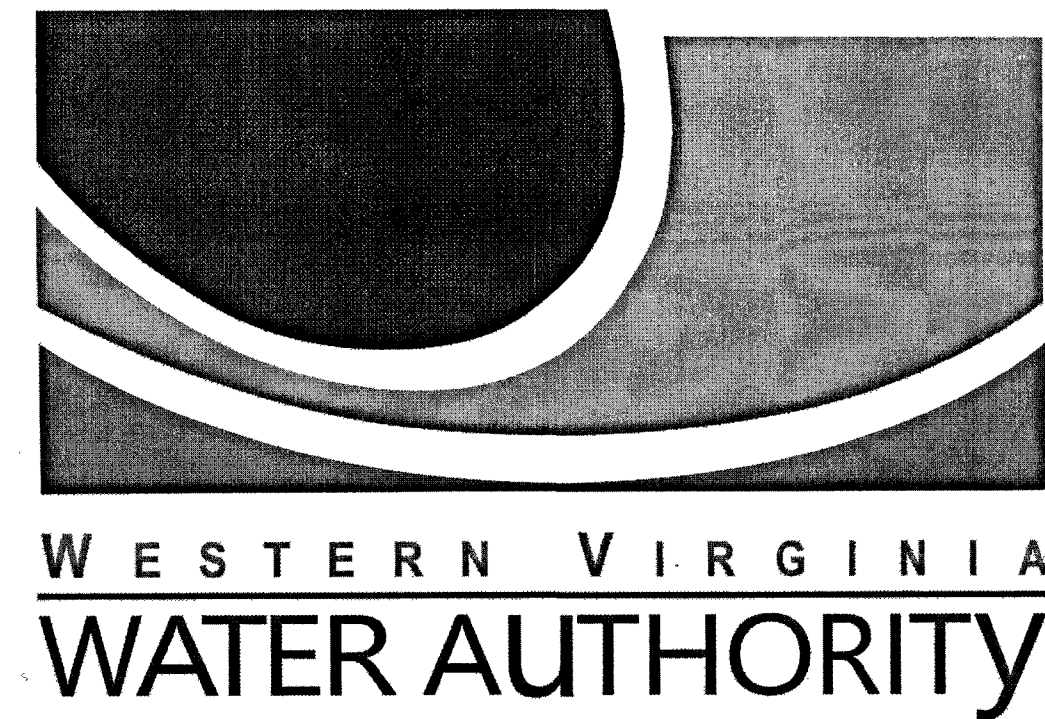

LOCATION MAP
NO SCALE

WESTERN VIRGINIA WATER AUTHORITY SUMMIT VIEW BUSINESS PARK UTILITY IMPROVEMENTS PHASE 1

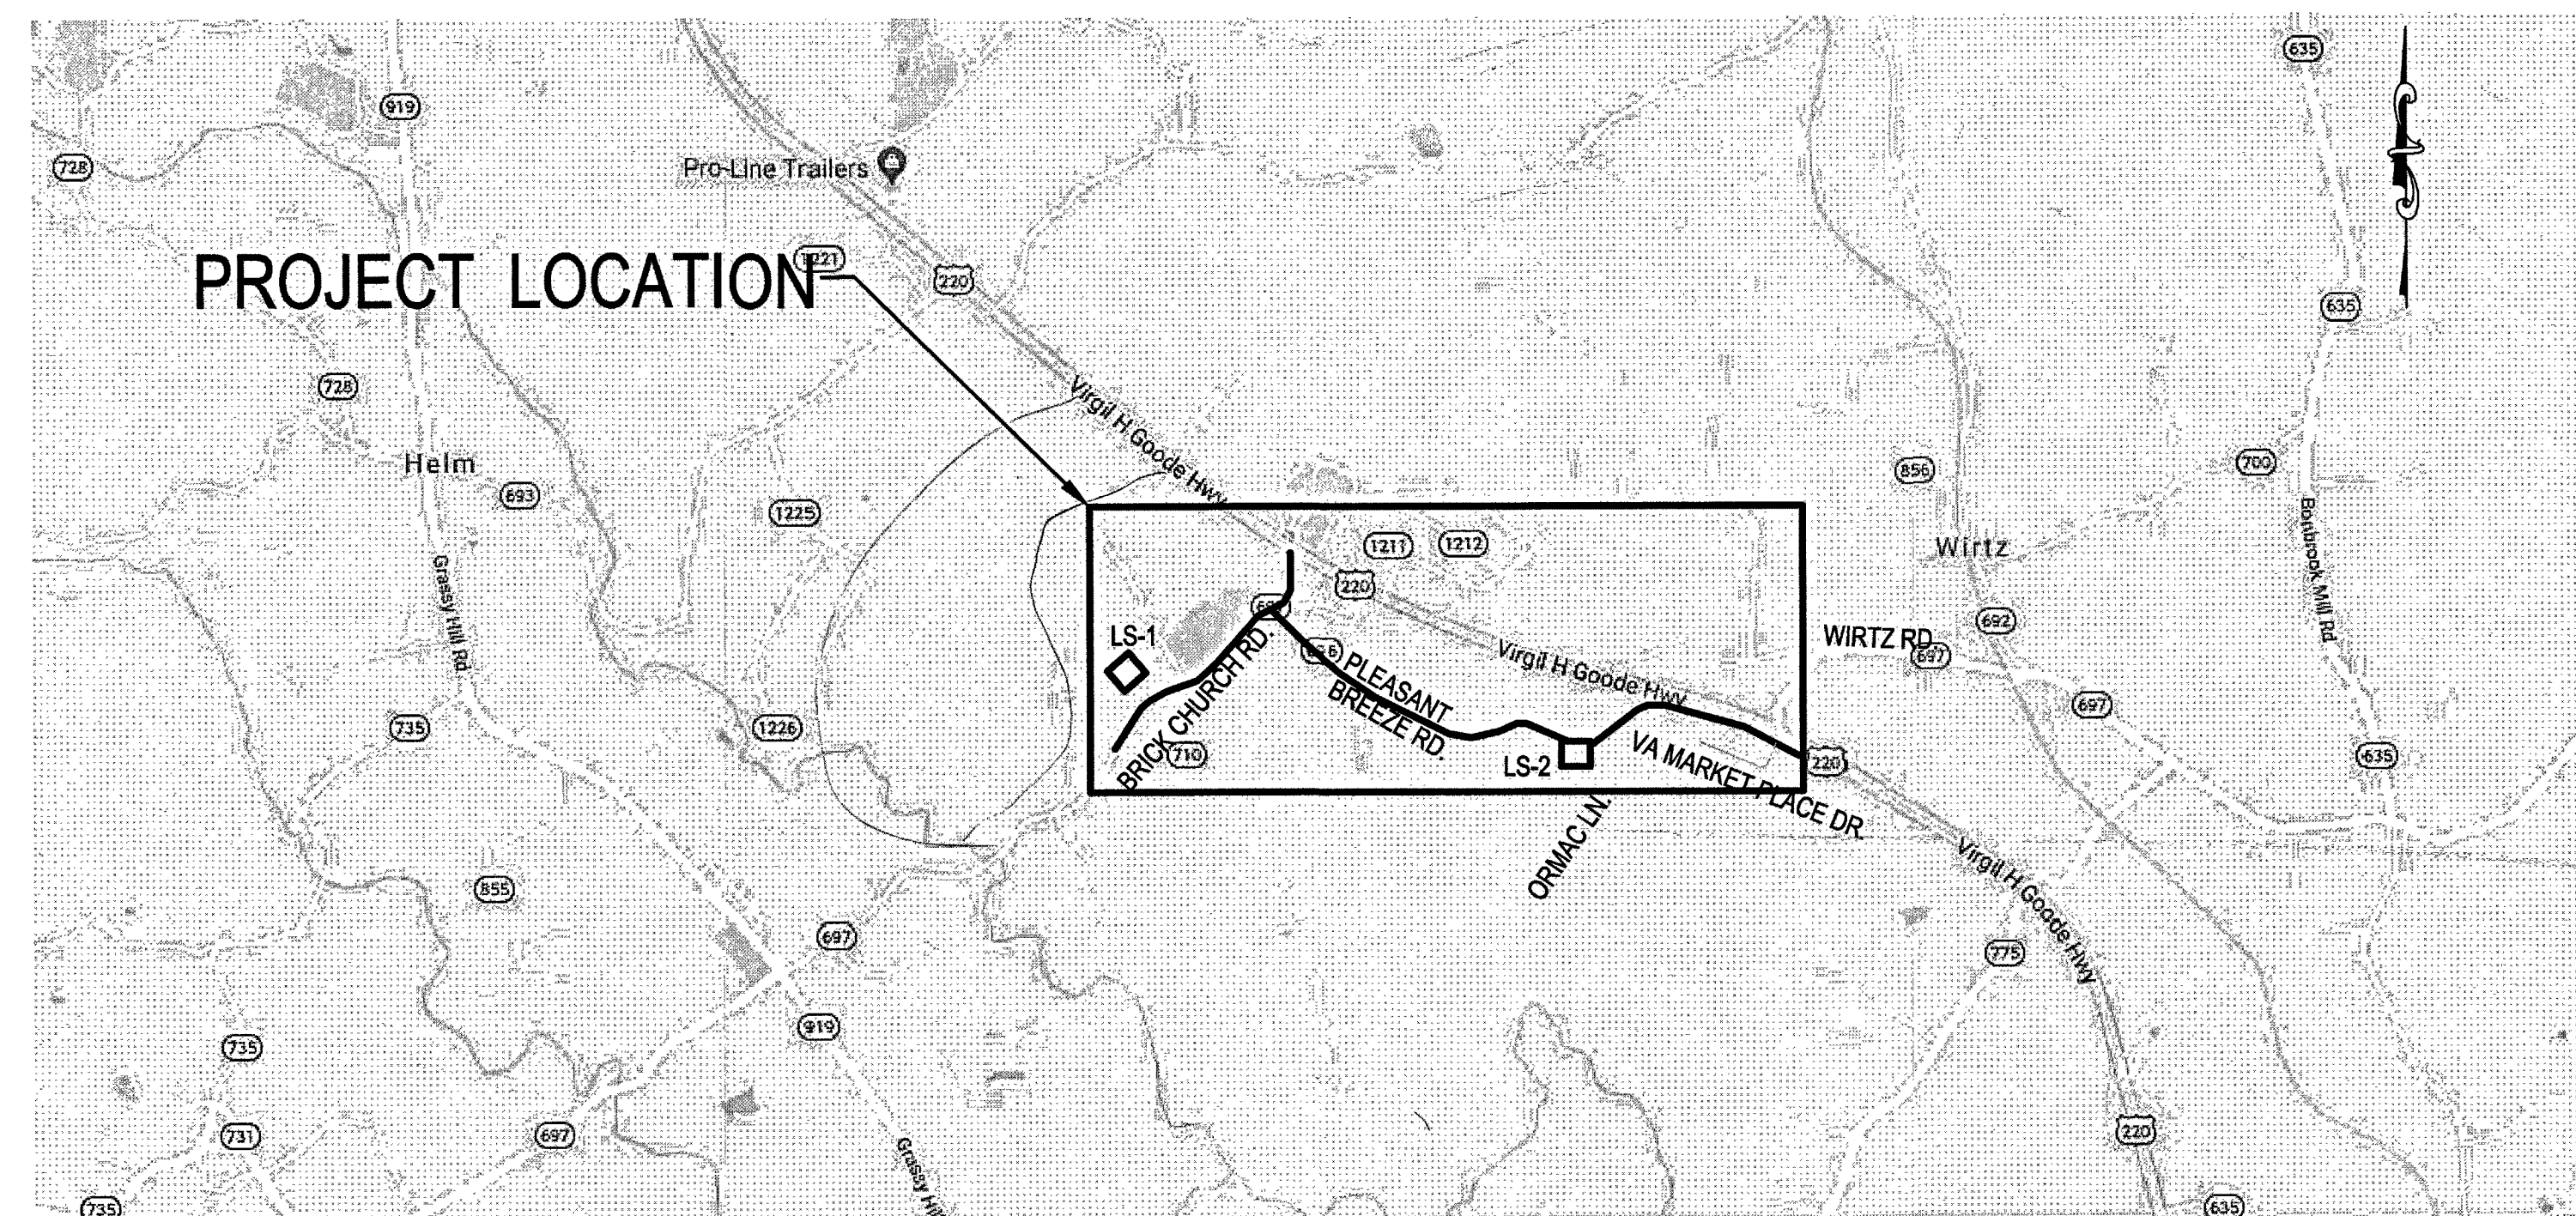

VICINITY MAP
NO SCALE

MAY 2018



Whitman, Requardt & Associates, LLP
1700 Kraft Dr, Suite 1200, Blacksburg, VA 24060

WESTERN VIRGINIA WATER AUTHORITY
601 South Jefferson Street, Suite 300
Roanoke, Virginia 24011

DES:
DRAWN:
CHECK:
DATE: 05/24/18

SCALE: N/A
HORIZ: N/A
VERT: N/A

SUMMIT VIEW BUSINESS PARK UTILITY IMPROVEMENTS
PHASE 1

APPROVED FOR CONSTRUCTION

COVER

DRAWING
G0.01

SHEET
1

As-Built