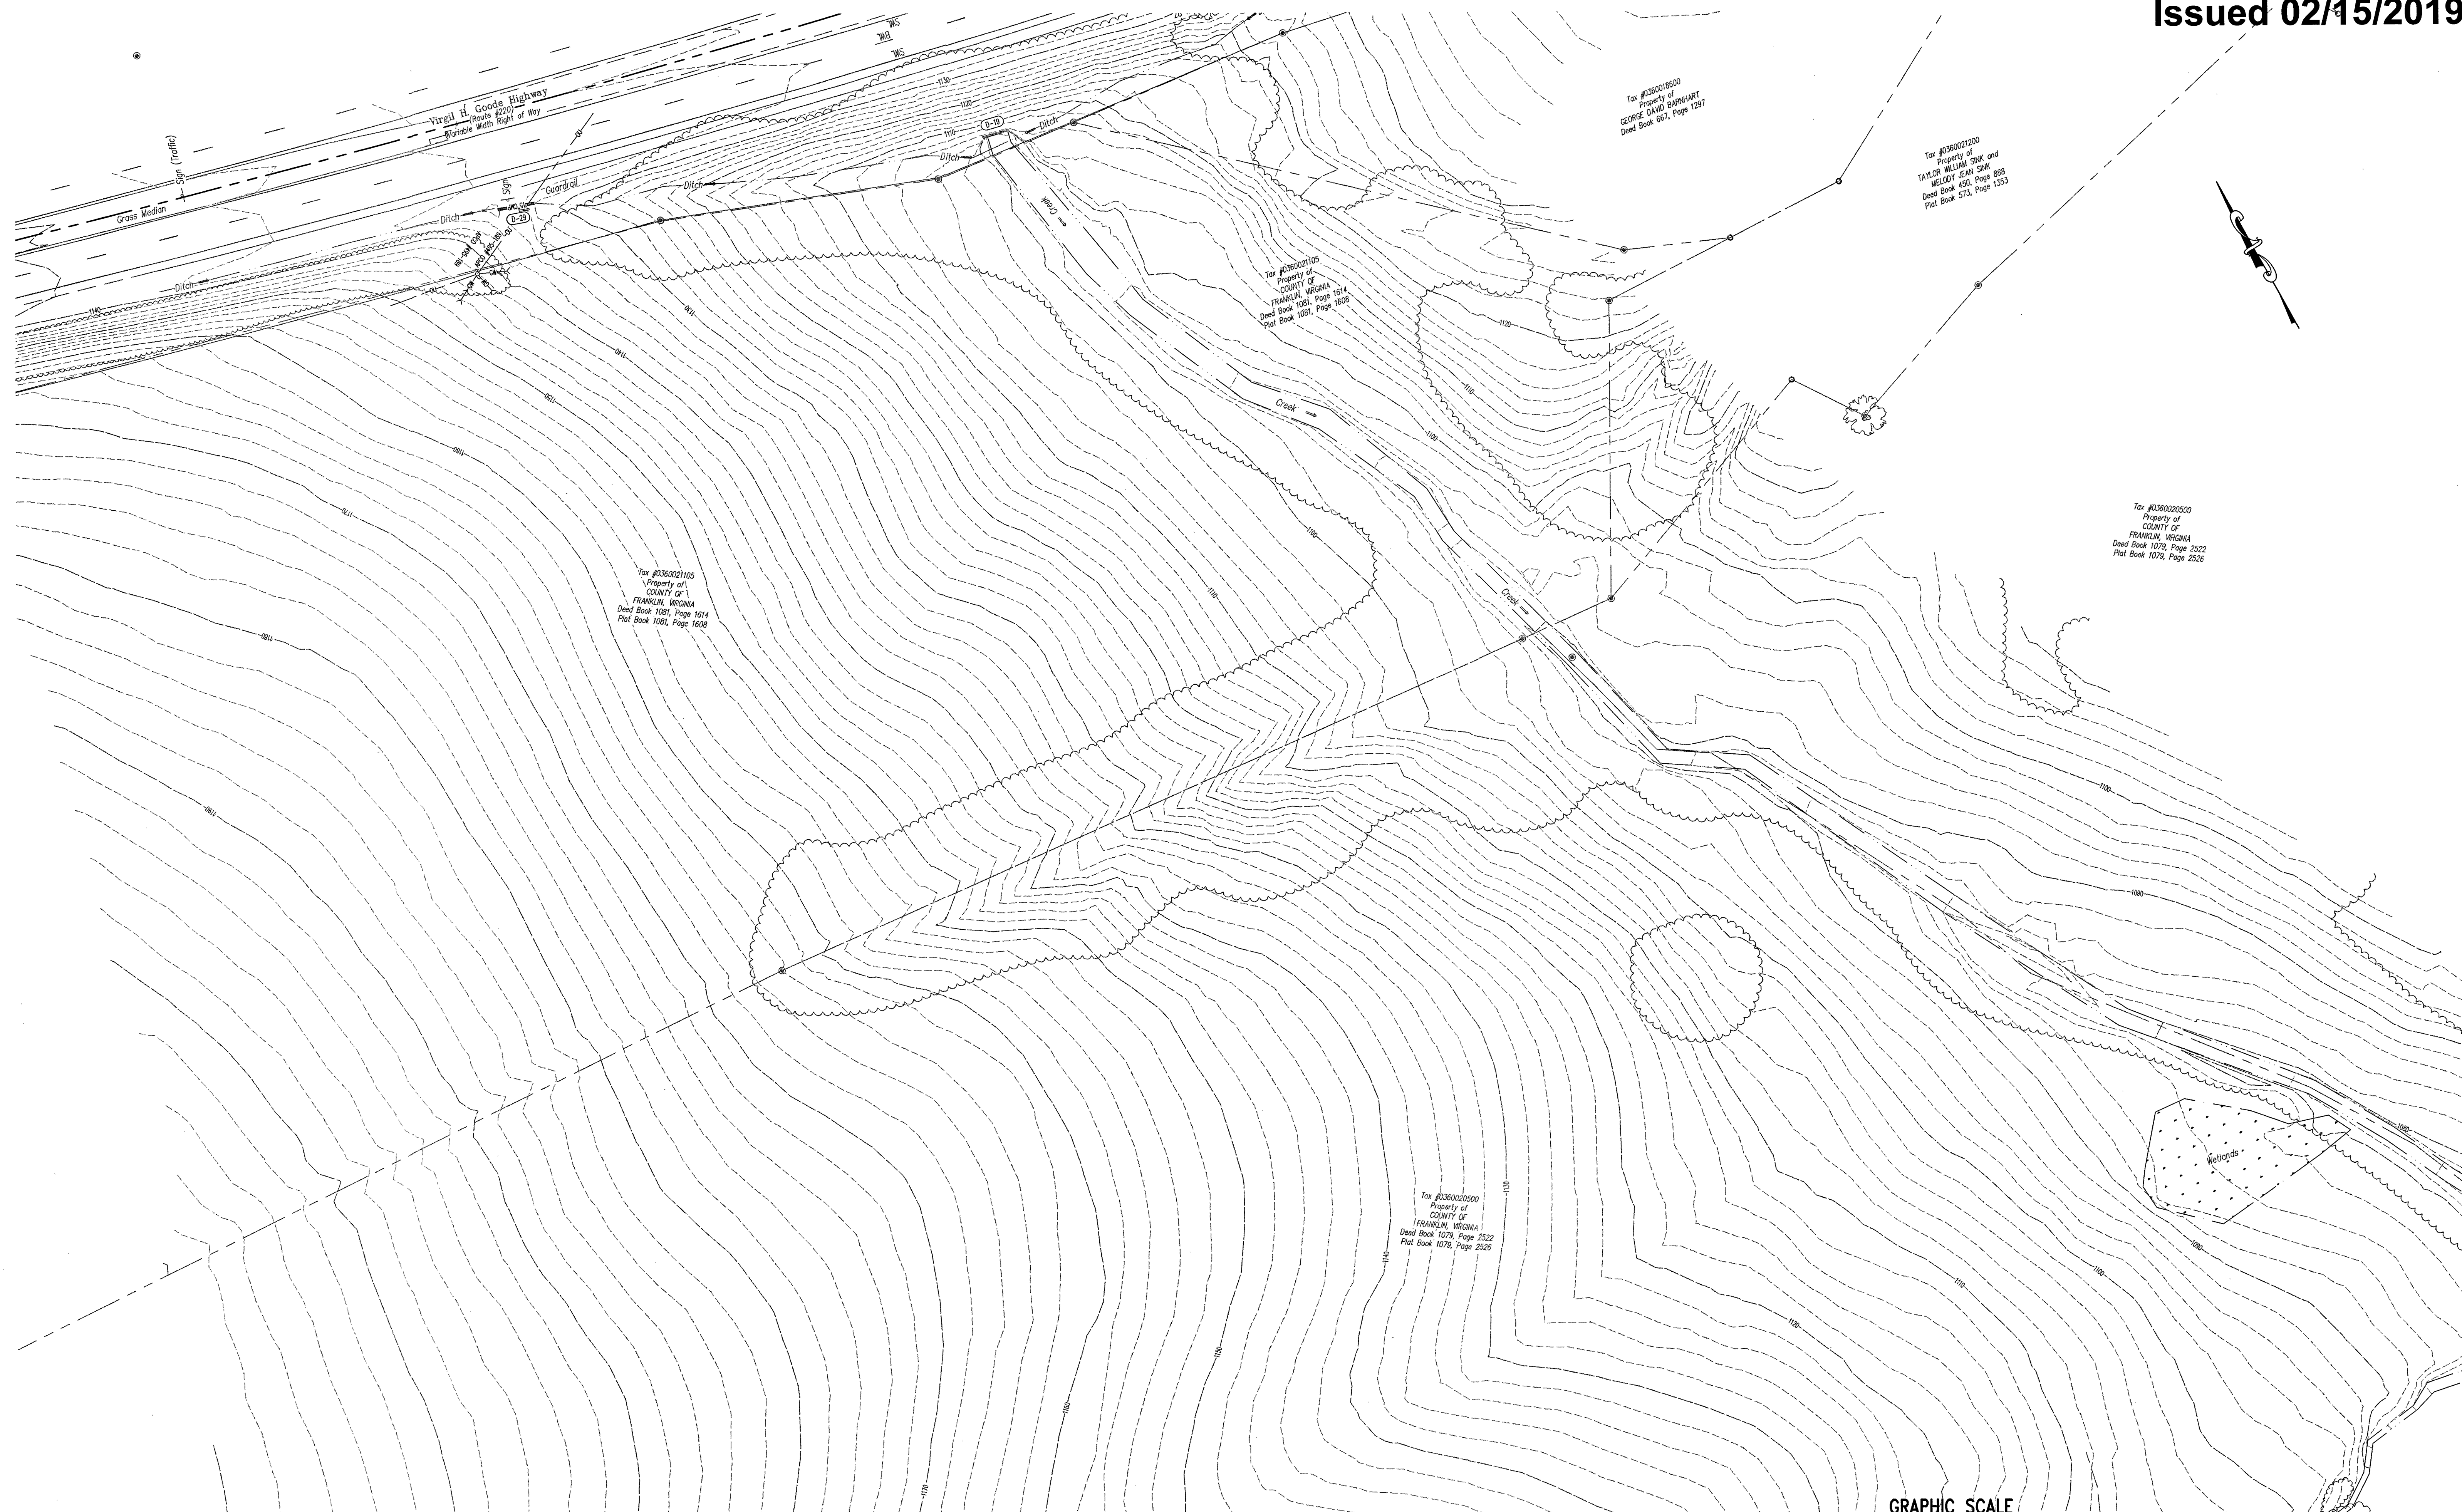


|          |      |             |
|----------|------|-------------|
| As-Built |      |             |
|          |      |             |
| REV      | DATE | DESCRIPTION |
| DRAWING  |      | SHEET       |
| C1.03    |      | 6           |