




STORM SEWER PROFILE

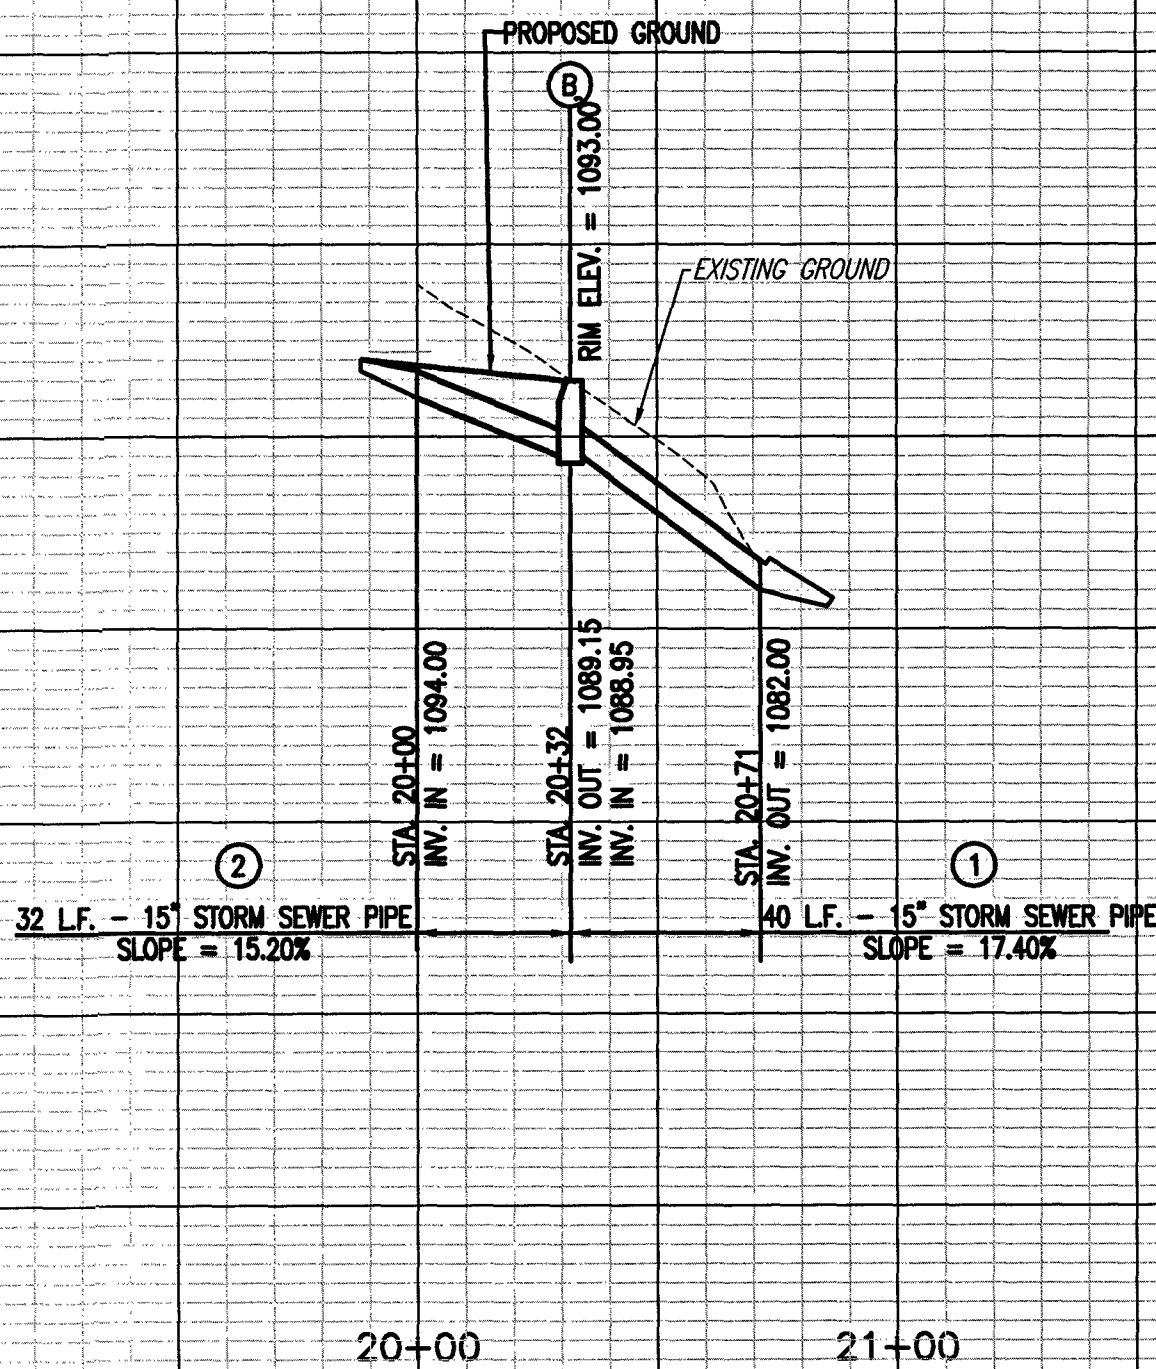


STORM SEWER PROFILE

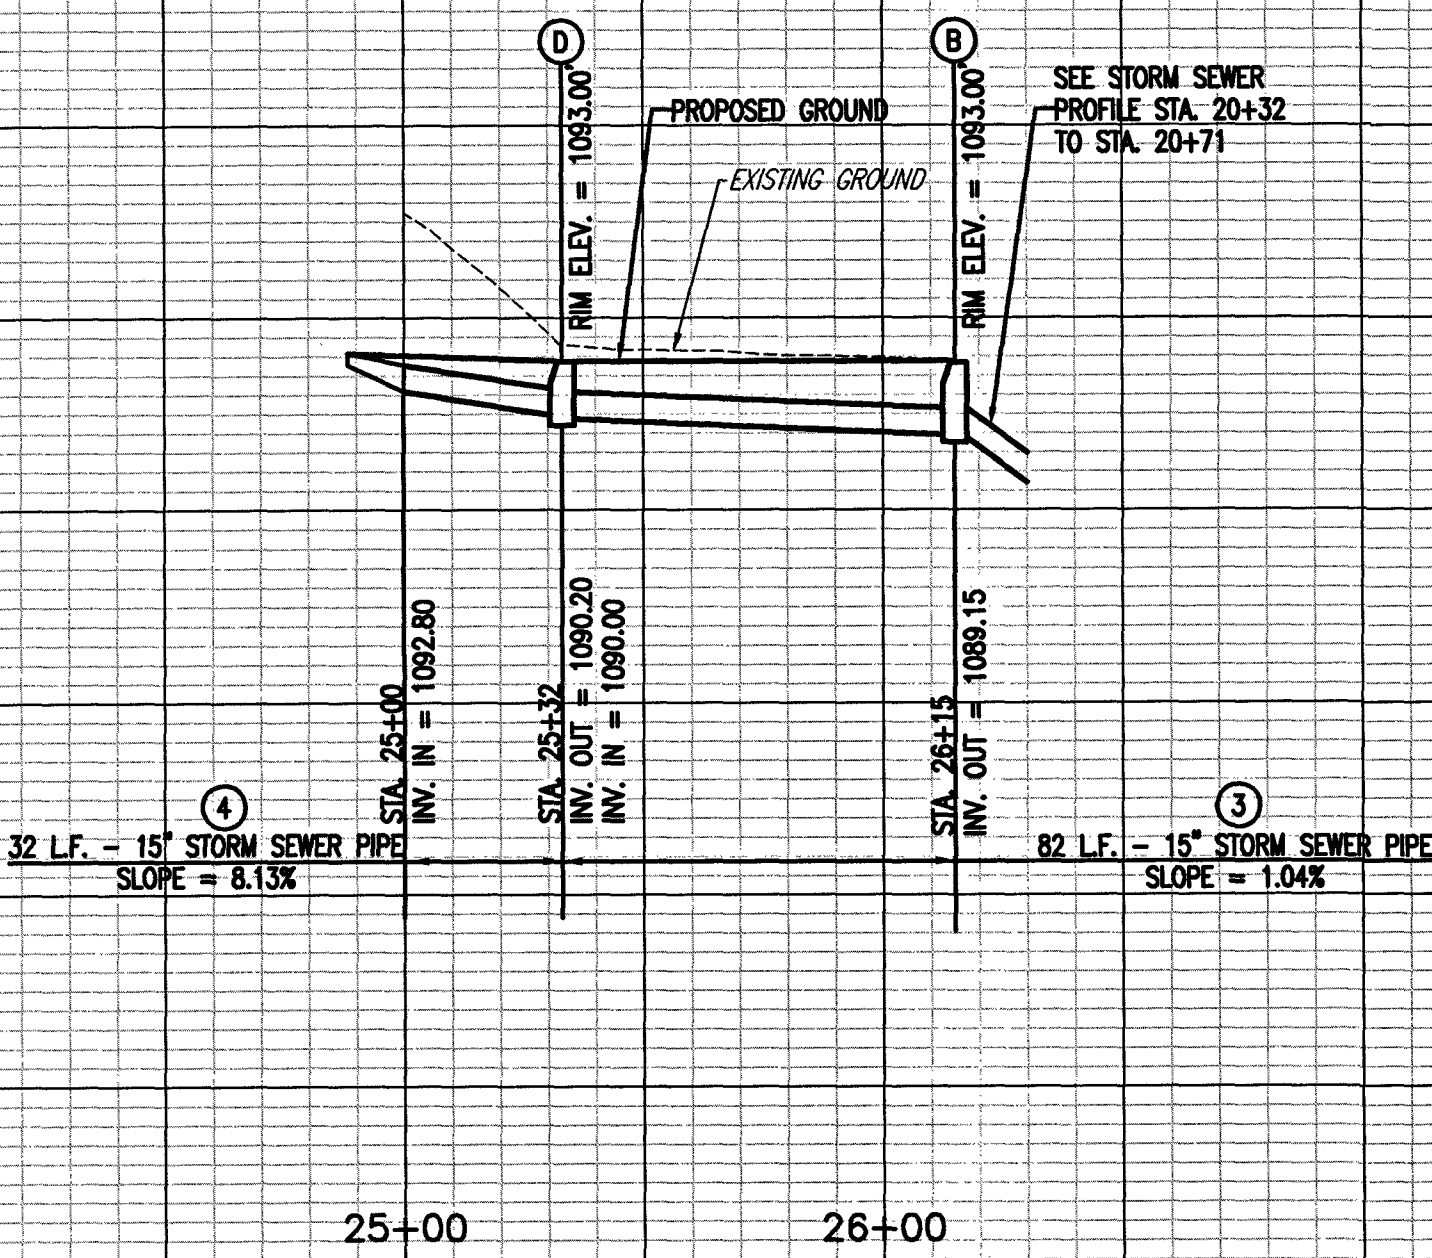

LIFT STATION #2
CONSTRUCTION
ACCESS ROAD
TYPICAL SECTION
NOT TO SCALE

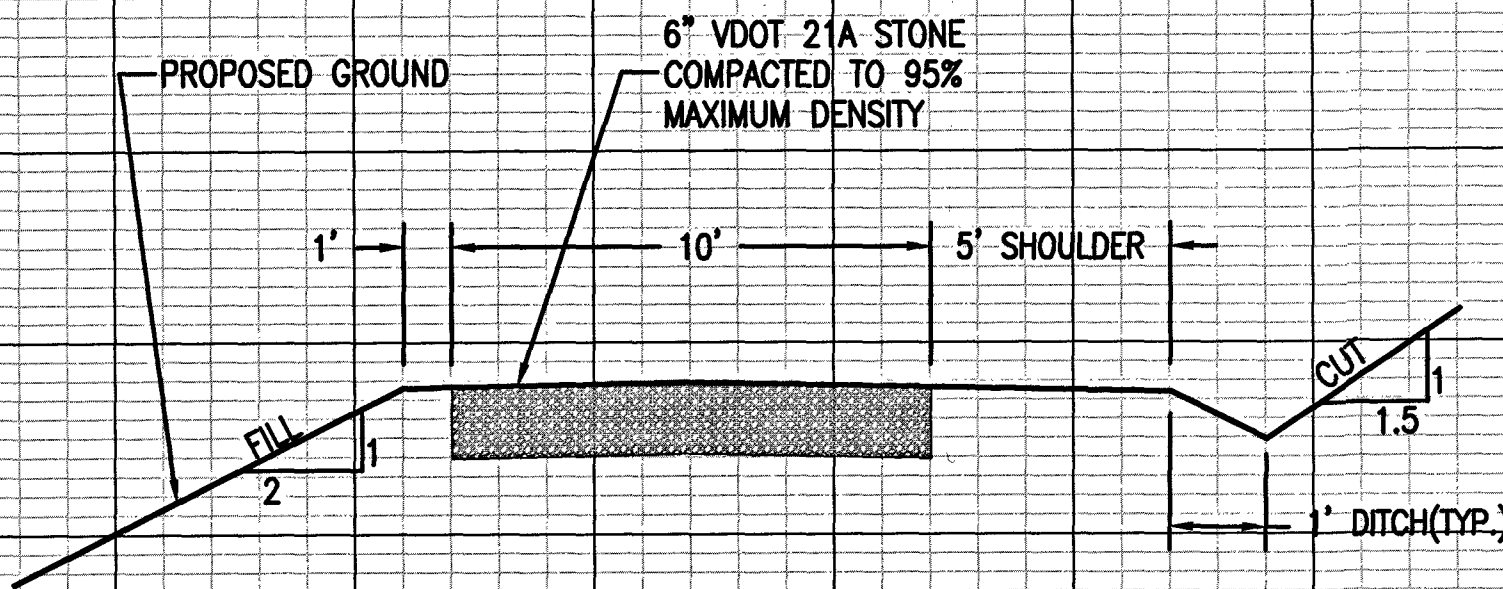

GRAPHIC SCALES

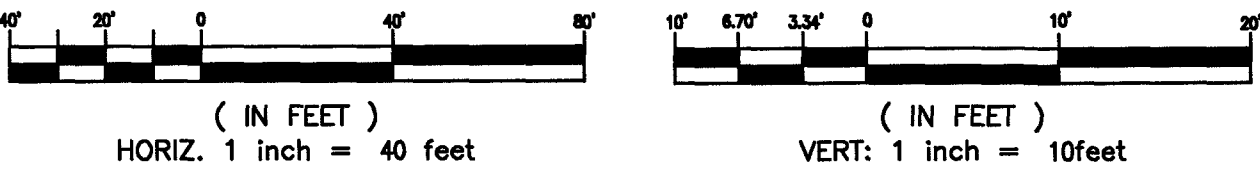

As-Built



WESTERN VIRGINIA WATER AUTHORITY
601 South Jefferson Street, Suite 300
Roanoke, Virginia 24011

DES: KN SCALE: AS SHOWN
DRAWN: JES HORIZ: 1" = 40'
CHECK: GWF VERT: 1" = 10'
DATE: 05/24/18

SUMMIT VIEW BUSINESS PARK UTILITY IMPROVEMENTS,
PHASE 1

LIFT STATION #2 ROAD PROFILE, SECTION,
& STORM SEWER PROFILE

DRAWING
C3.05

SHEET
15

REV	DATE	DESCRIPTION
R	10/26/2018	DESIGN REVISIONS