


As-Built

REV	DATE	DESCRIPTION	DRAWING	SHEET
			C4.01	17

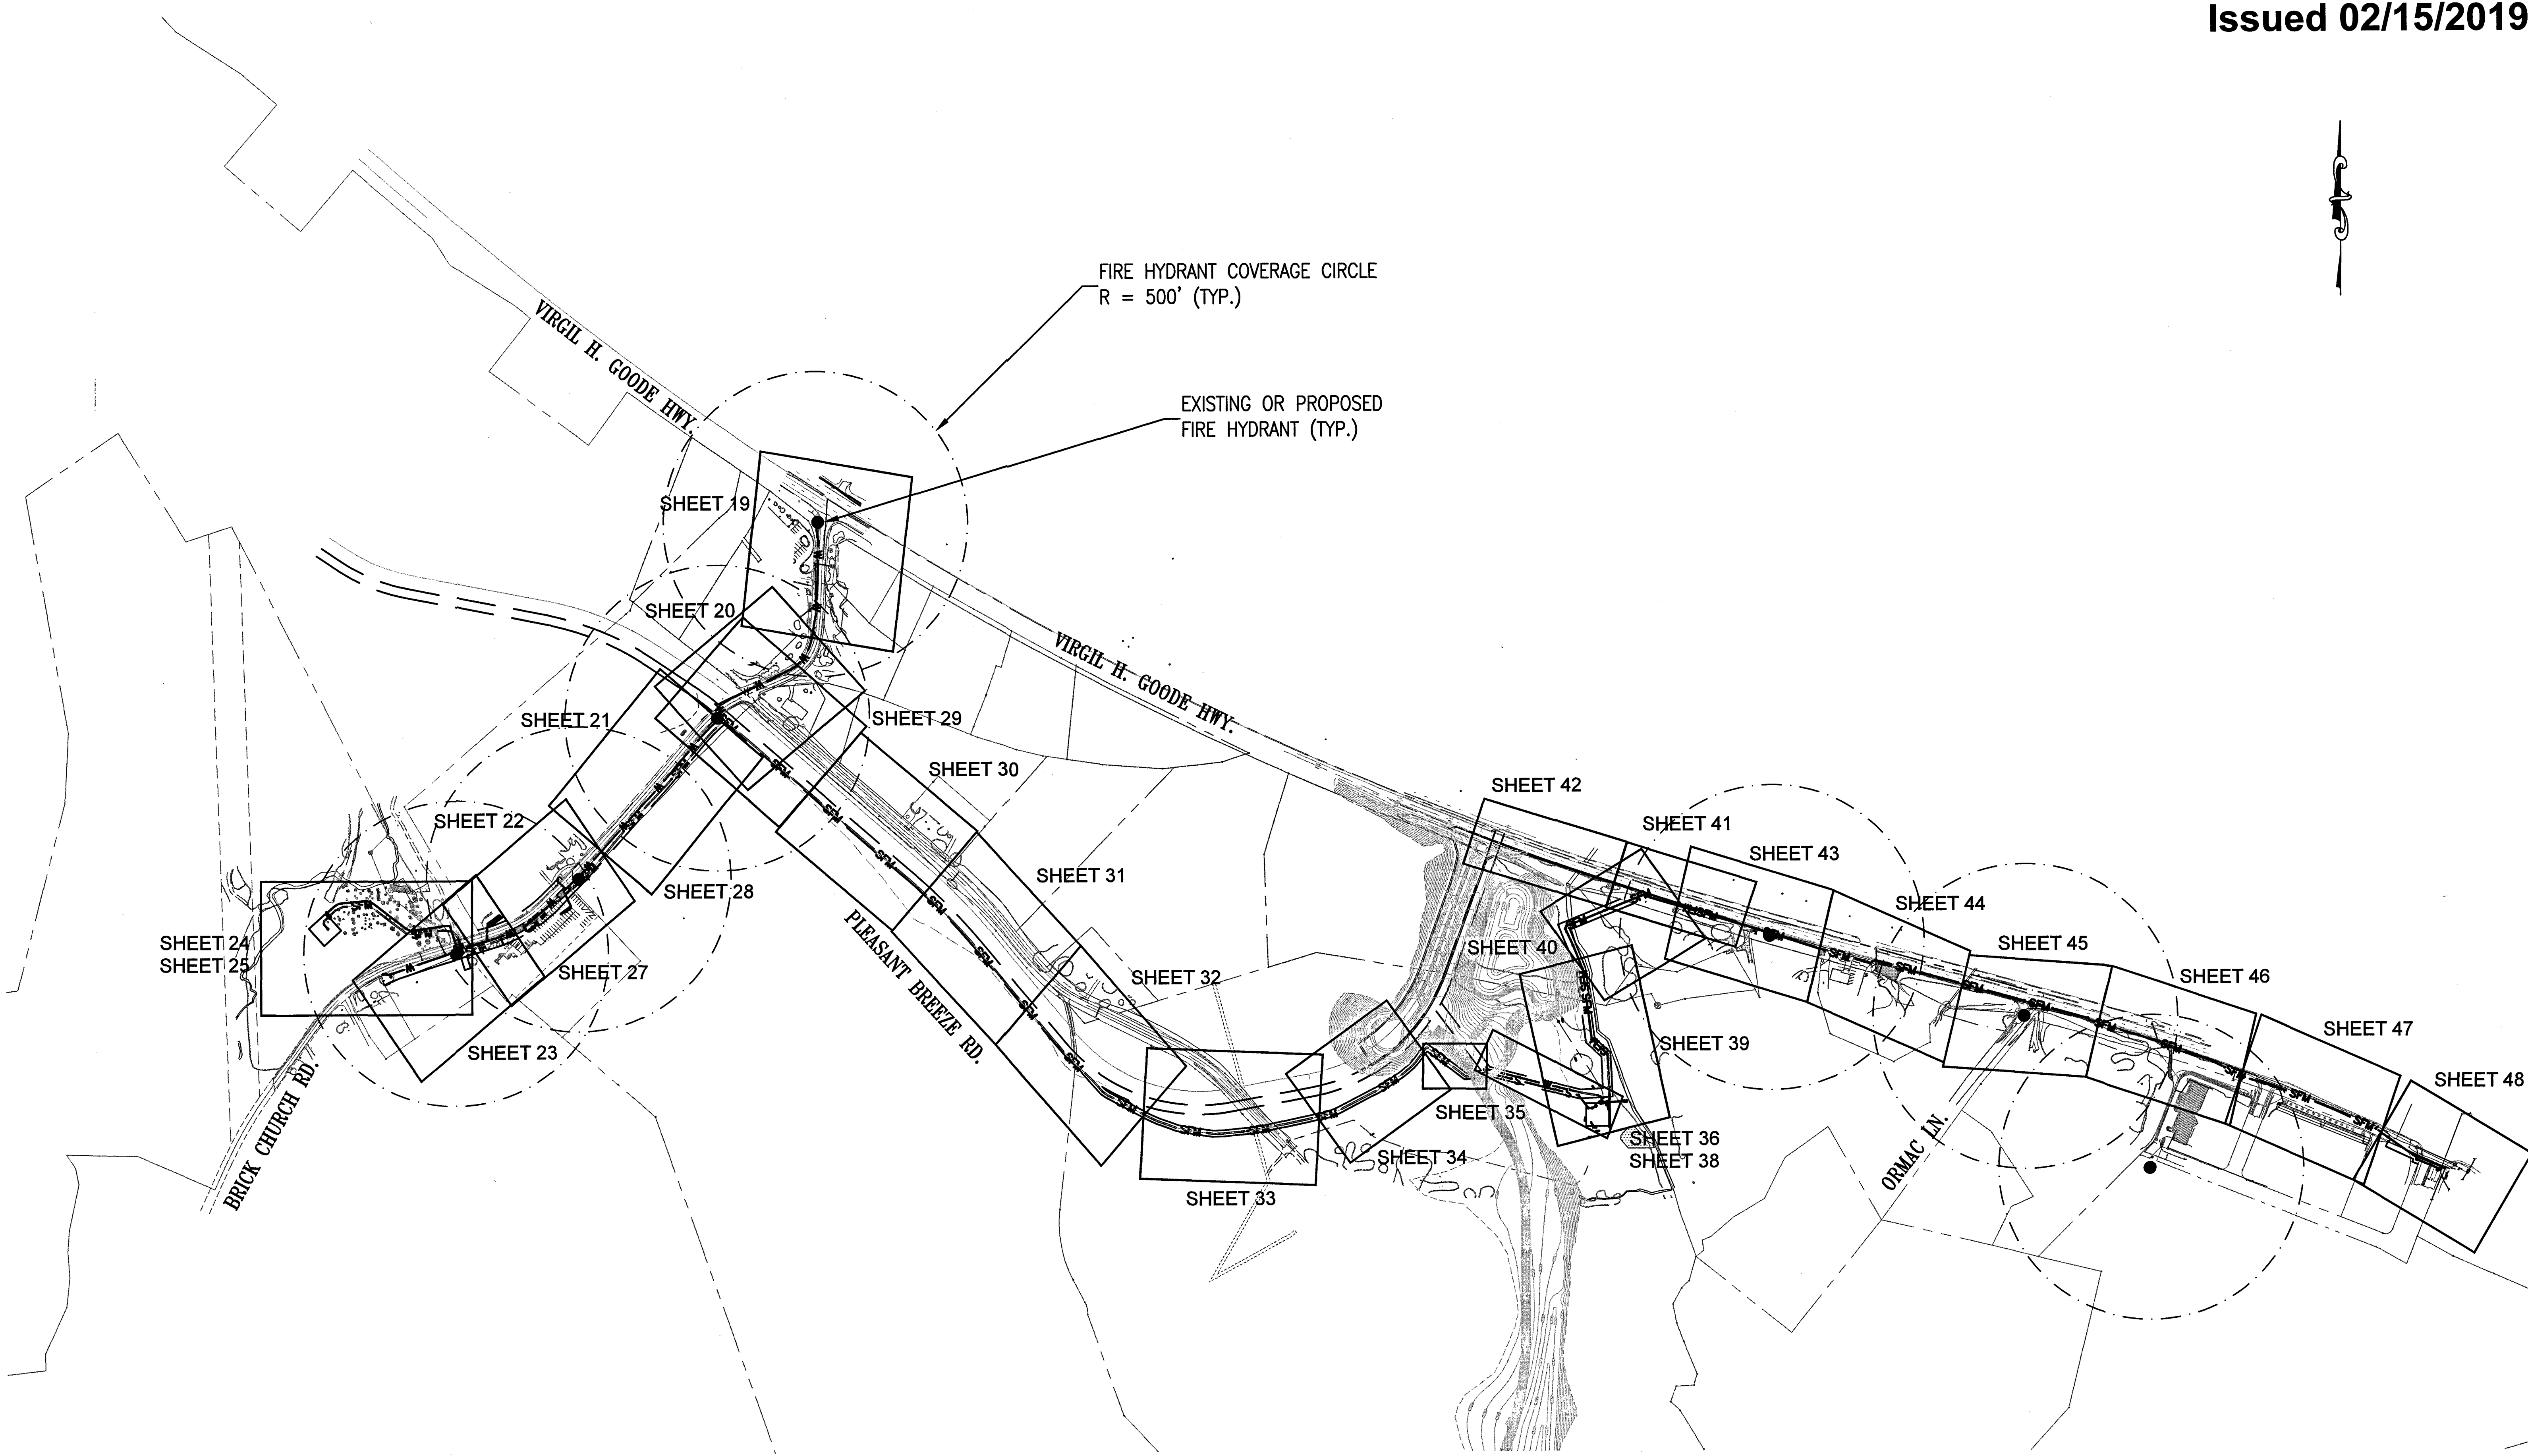

WRA
Whitman, Requardt & Associates, LLP
1700 Kraft Dr, Suite 1200, Blacksburg, VA 24060

WESTERN VIRGINIA WATER AUTHORITY
601 South Jefferson Street, Suite 300
Roanoke, Virginia 24011

DES: PTM	SCALE: AS SHOWN
DRAWN: JES	HORIZ: 1" = 250'
CHECK: GWF	VERT: N/A
DATE: 05/24/18	

SUMMIT VIEW BUSINESS PARK UTILITY IMPROVEMENTS
PHASE 1

SHEET LAYOUT &
FIRE HYDRANT COVERAGE MAP