
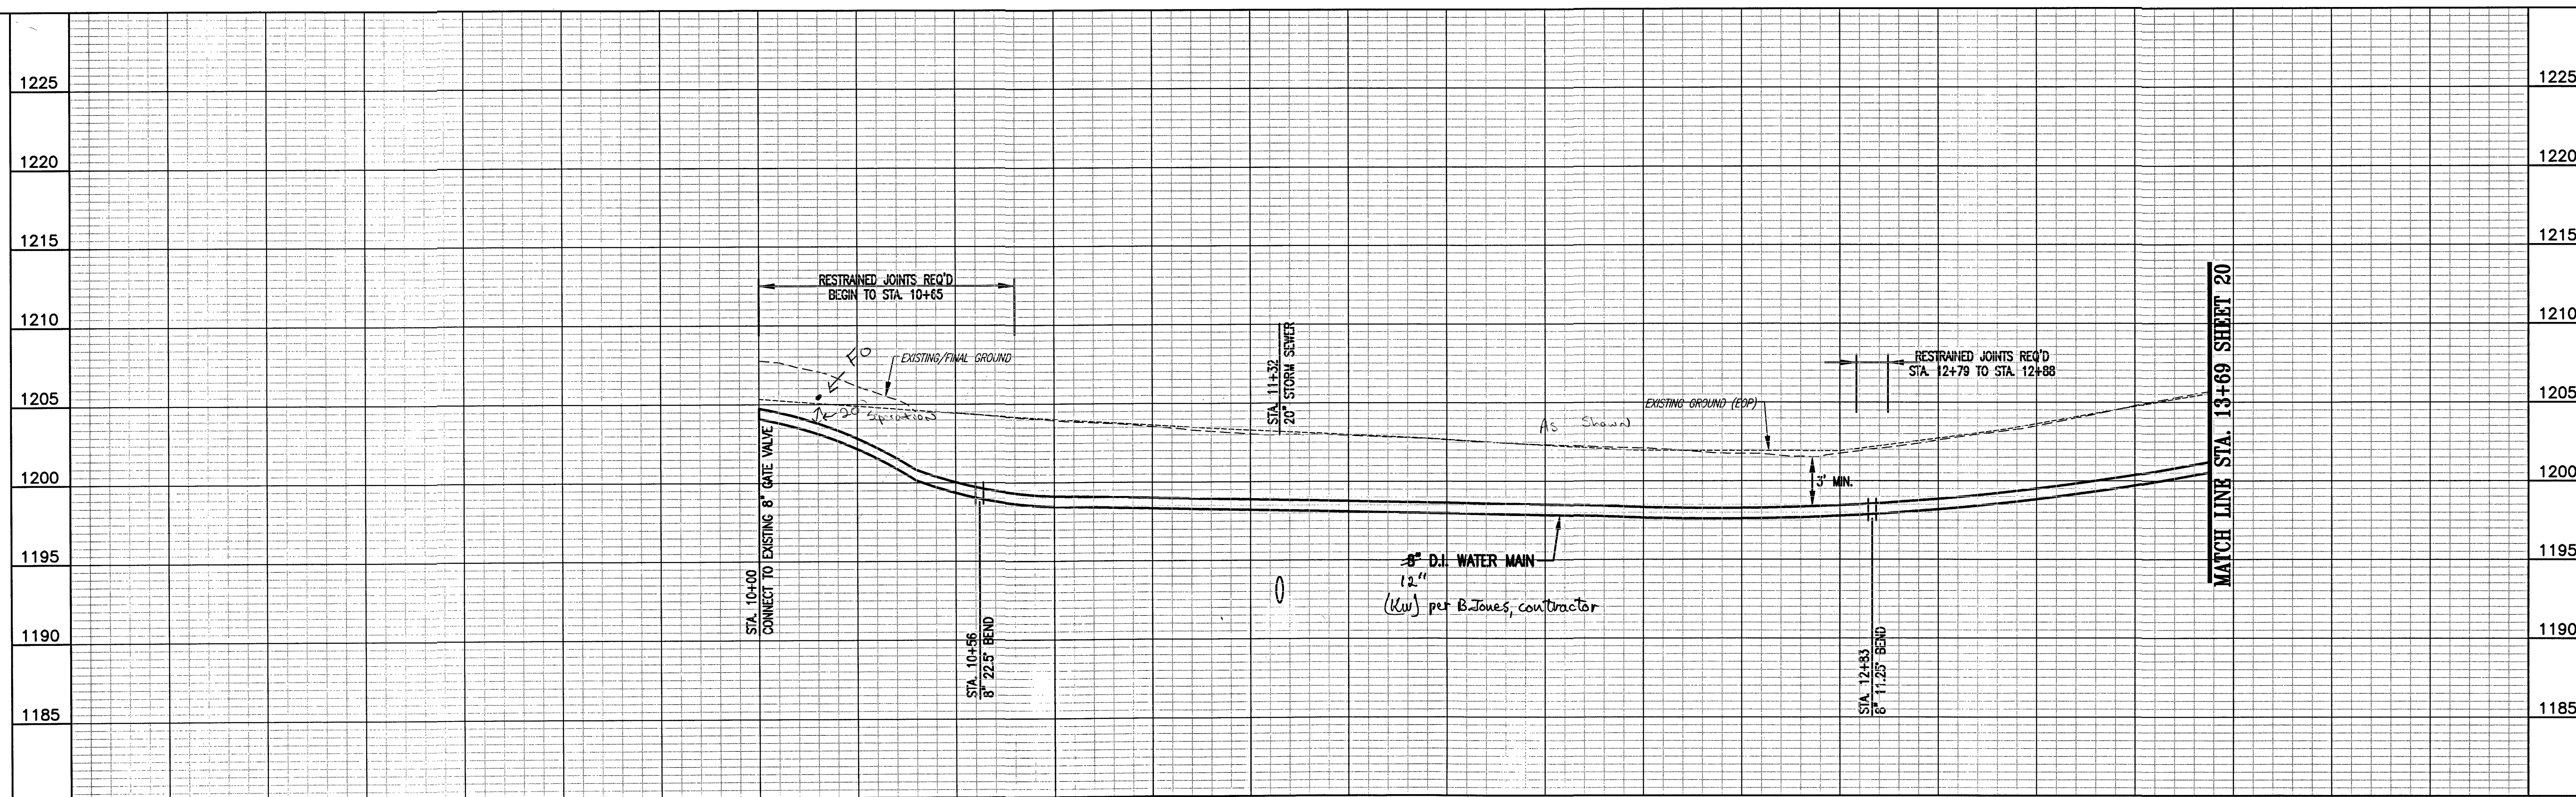


NOTE:

- ALL PIPE MATERIALS SHALL BE AS SPECIFIED ON THE PIPE SCHEDULE SHOWN ON DRAWING C4.02.

Issued 02/15/2019

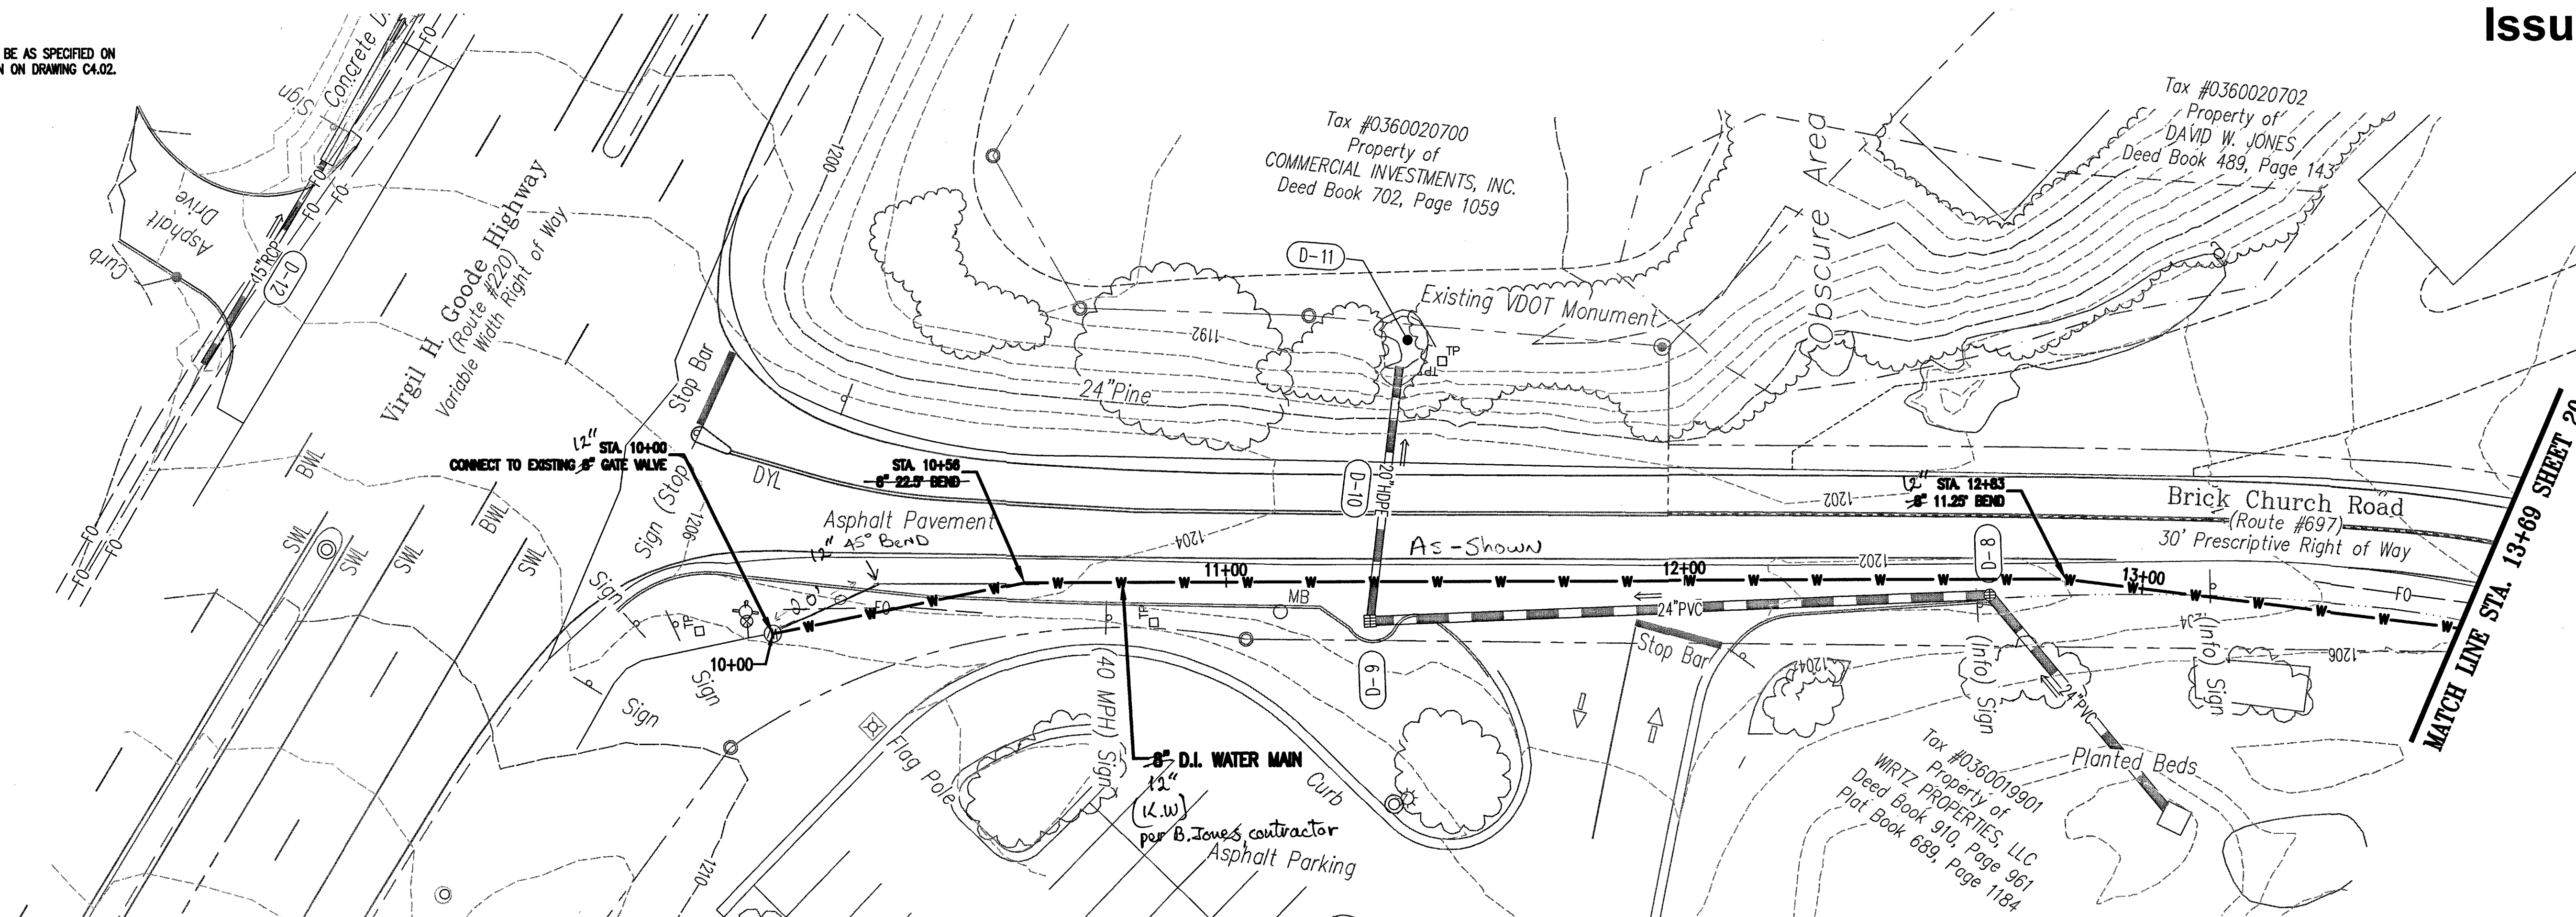



10+00

11+00

12+00


13+00

GRAPHIC SCALES

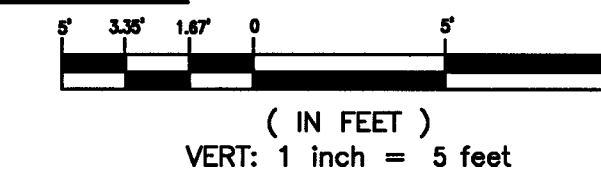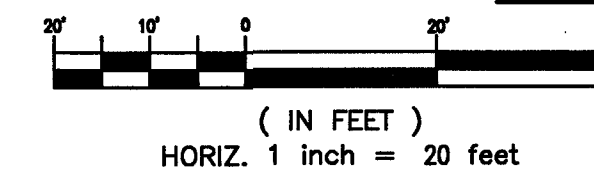

AS-BUILT

REV	DATE	DESCRIPTION

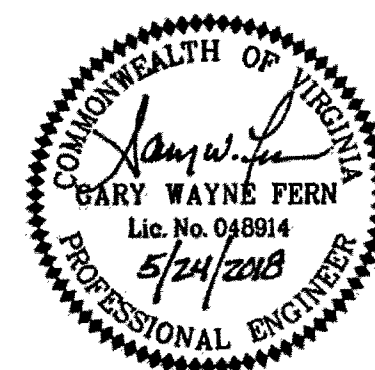

WESTERN VIRGINIA WATER AUTHORITY
601 South Jefferson Street, Suite 300
Roanoke, Virginia 24011

DES: PJM
DRAWN: JES
CHECK: GWP
DATE: 05/24/18

SCALE: AS SHOWN
HORIZ: 1" = 20'
VERT: 1" = 5'

SUMMIT VIEW BUSINESS PARK UTILITY IMPROVEMENTS
PHASE 1

8" D.I. WATER MAIN PLAN - PROFILE
STA. 10+00 TO STA. 13+69

DRAWING
C4.03

SHEET
19