
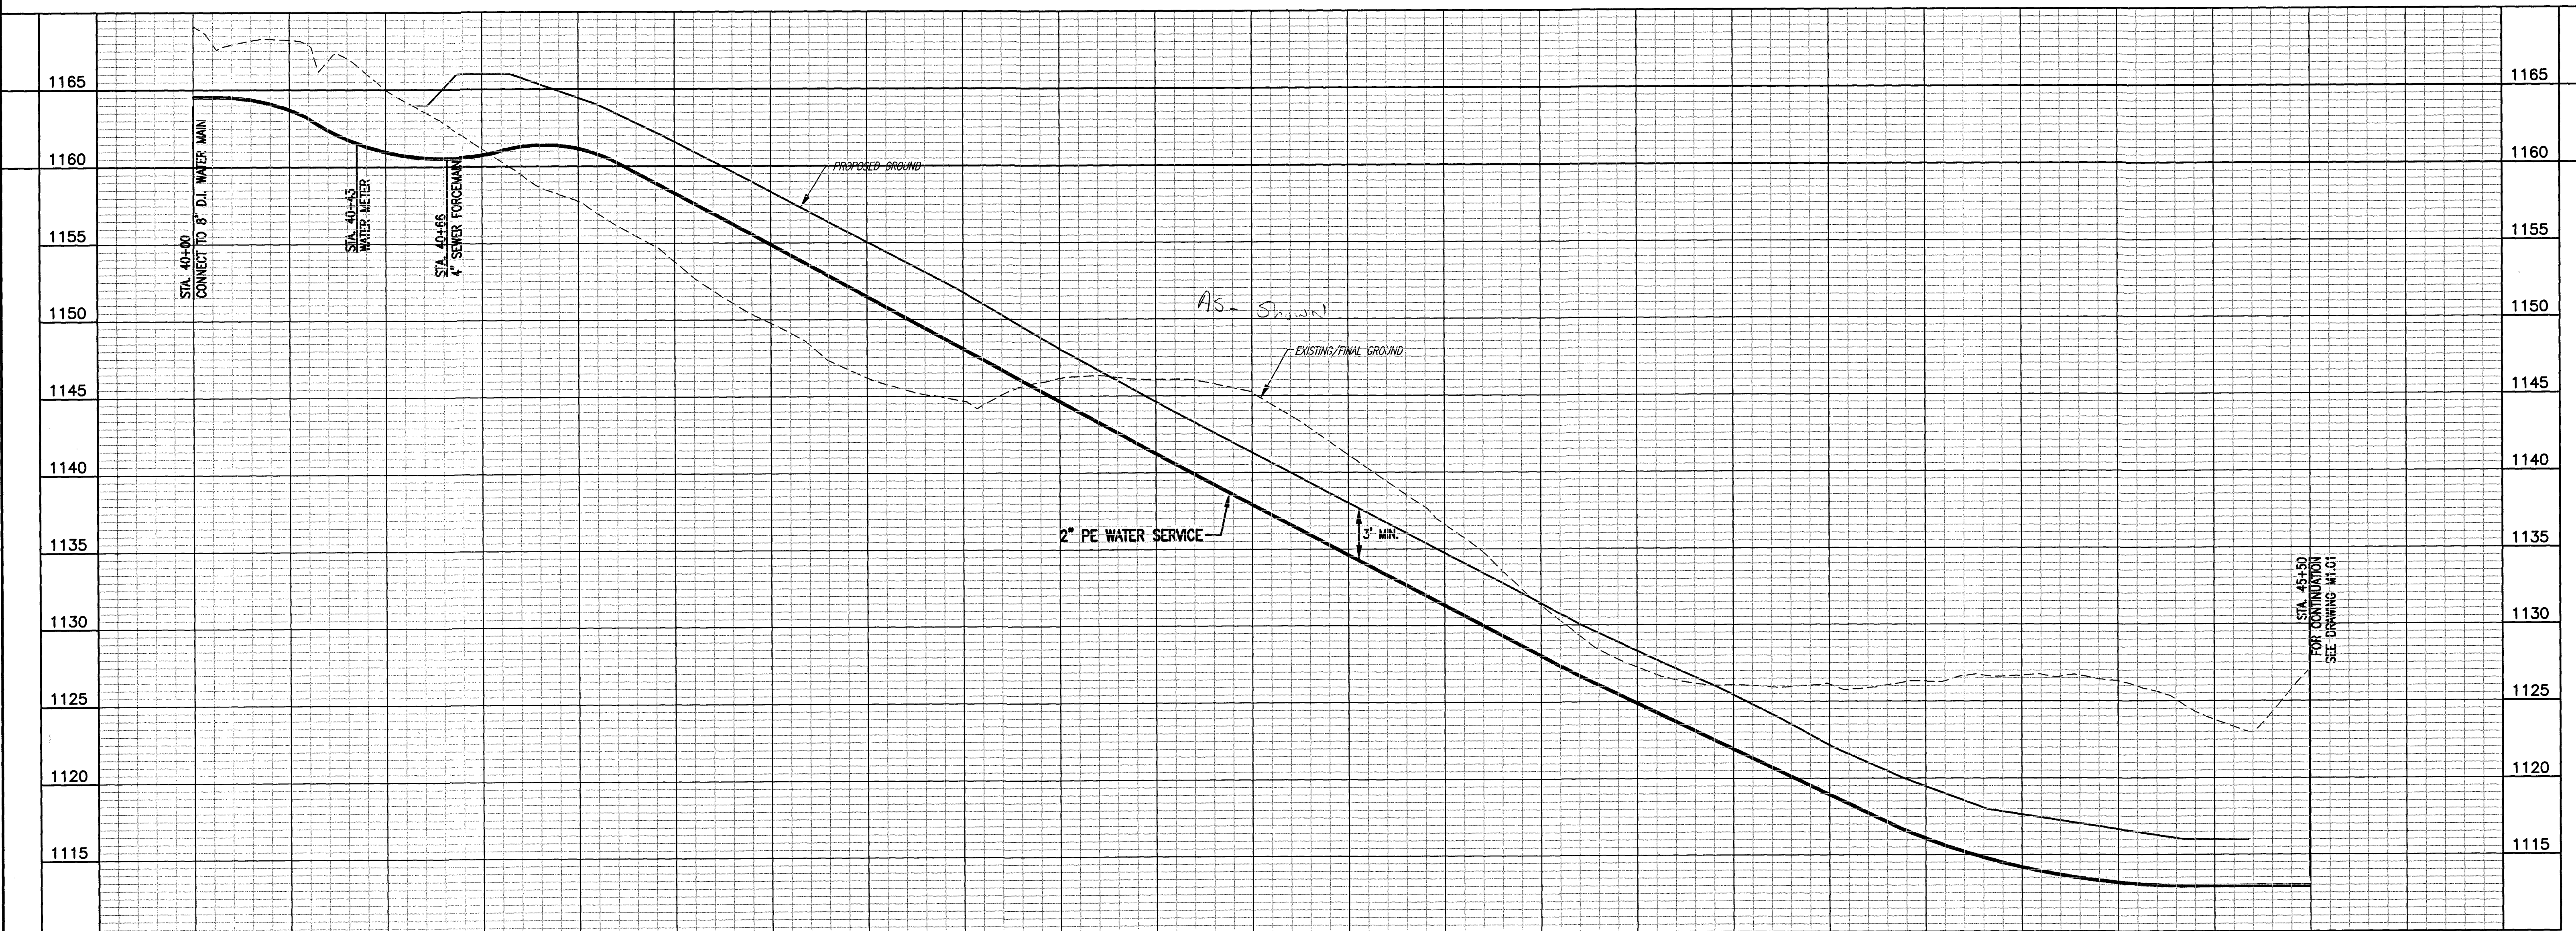


NOTE:

1. ALL PIPE MATERIALS SHALL BE AS SPECIFIED ON THE PIPE SCHEDULE SHOWN ON DRAWING C4.02.
2. CONTRACTOR SHALL MAINTAIN ACCESS TO AT LEAST ONE ENTRANCE TO THE CHURCH AT ALL TIMES.
3. IN THE EVENT OF A FUNERAL TO BE HELD AT THE CHURCH OR CEMETERY, CONTRACTOR WILL RECEIVE 24 HOURS NOTICE AND SHALL SHUT DOWN ALL WORK ON SITE THE DAY OF THE FUNERAL. NO PERSONNEL SHALL BE ON SITE.

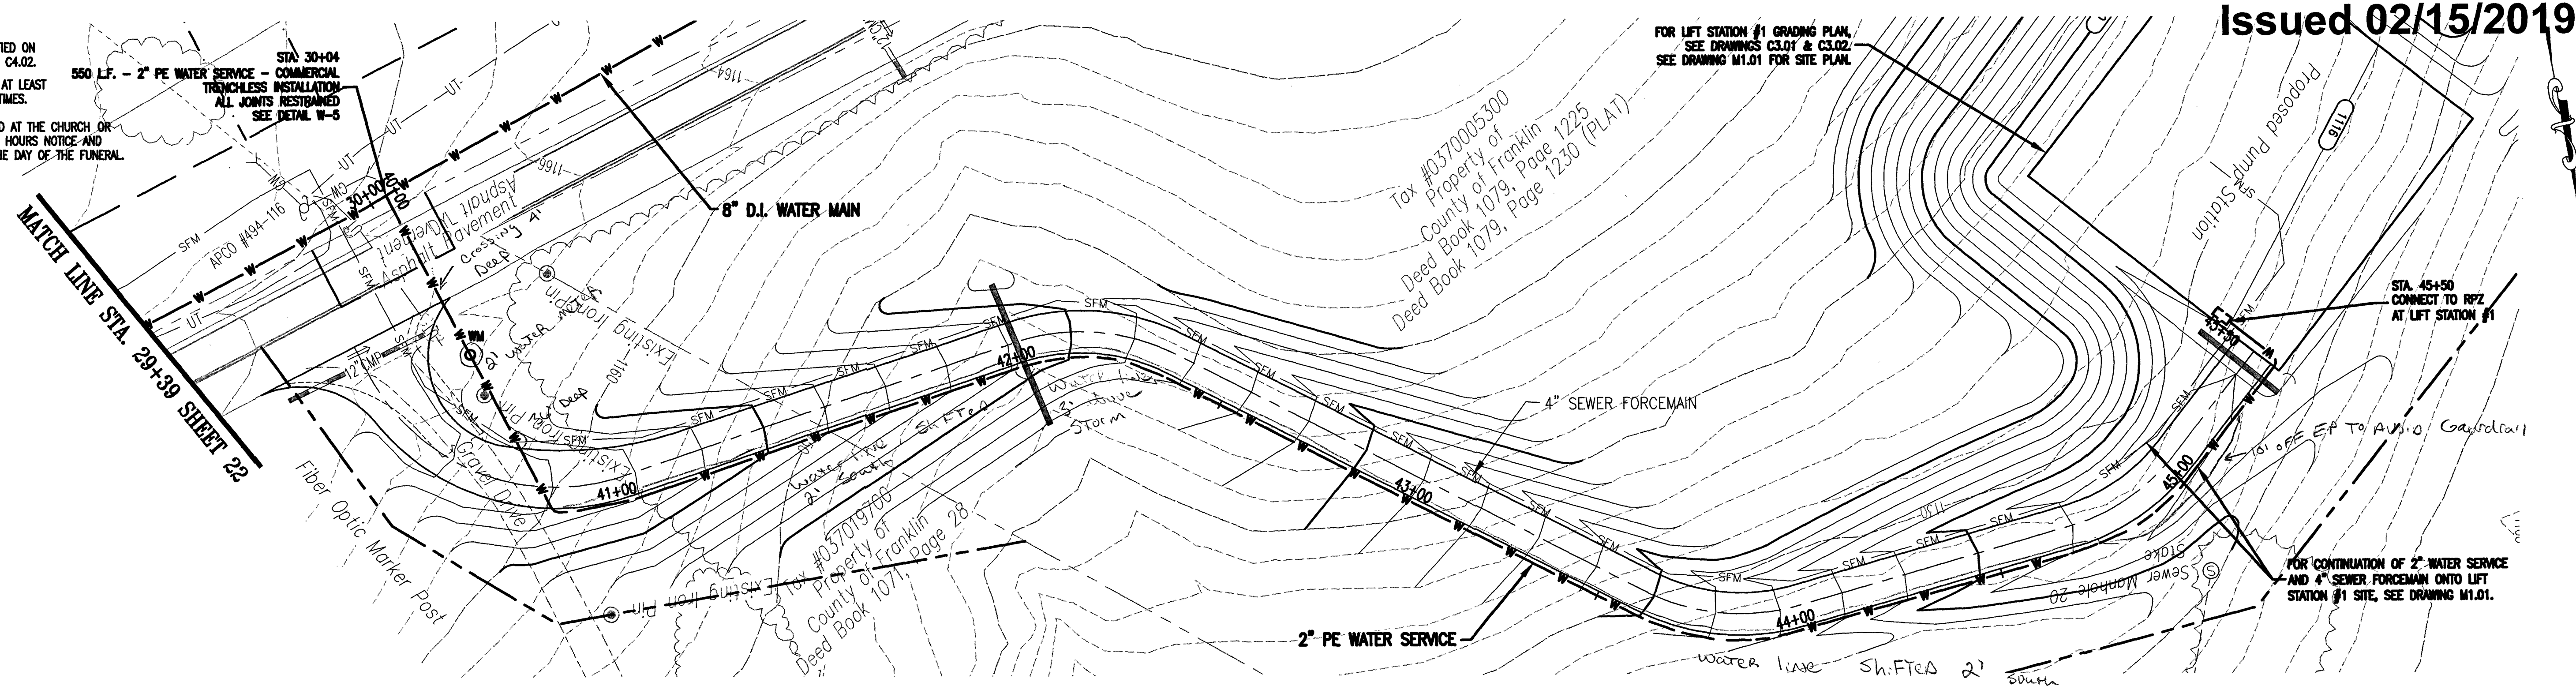

				WESTERN VIRGINIA WATER AUTHORITY 601 South Jefferson Street, Suite 300 Roanoke, Virginia 24011		DES: PJM DRAWN: JES CHECK: GWF DATE: 05/24/18		SCALE: AS SHOWN HORIZ: 1" = 20' VERT: 1" = 5'		SUMMIT VIEW BUSINESS PARK UTILITY IMPROVEMENTS PHASE 1		2" WATER SERVICE PLAN - PROFILE STA. 40+00 TO STA. 45+50		DRAWING C4.08		SHEET 24	
--	--	--	--	---	--	---	--	--	--	--	--	--	--	-----------------------------	--	------------------------	--